


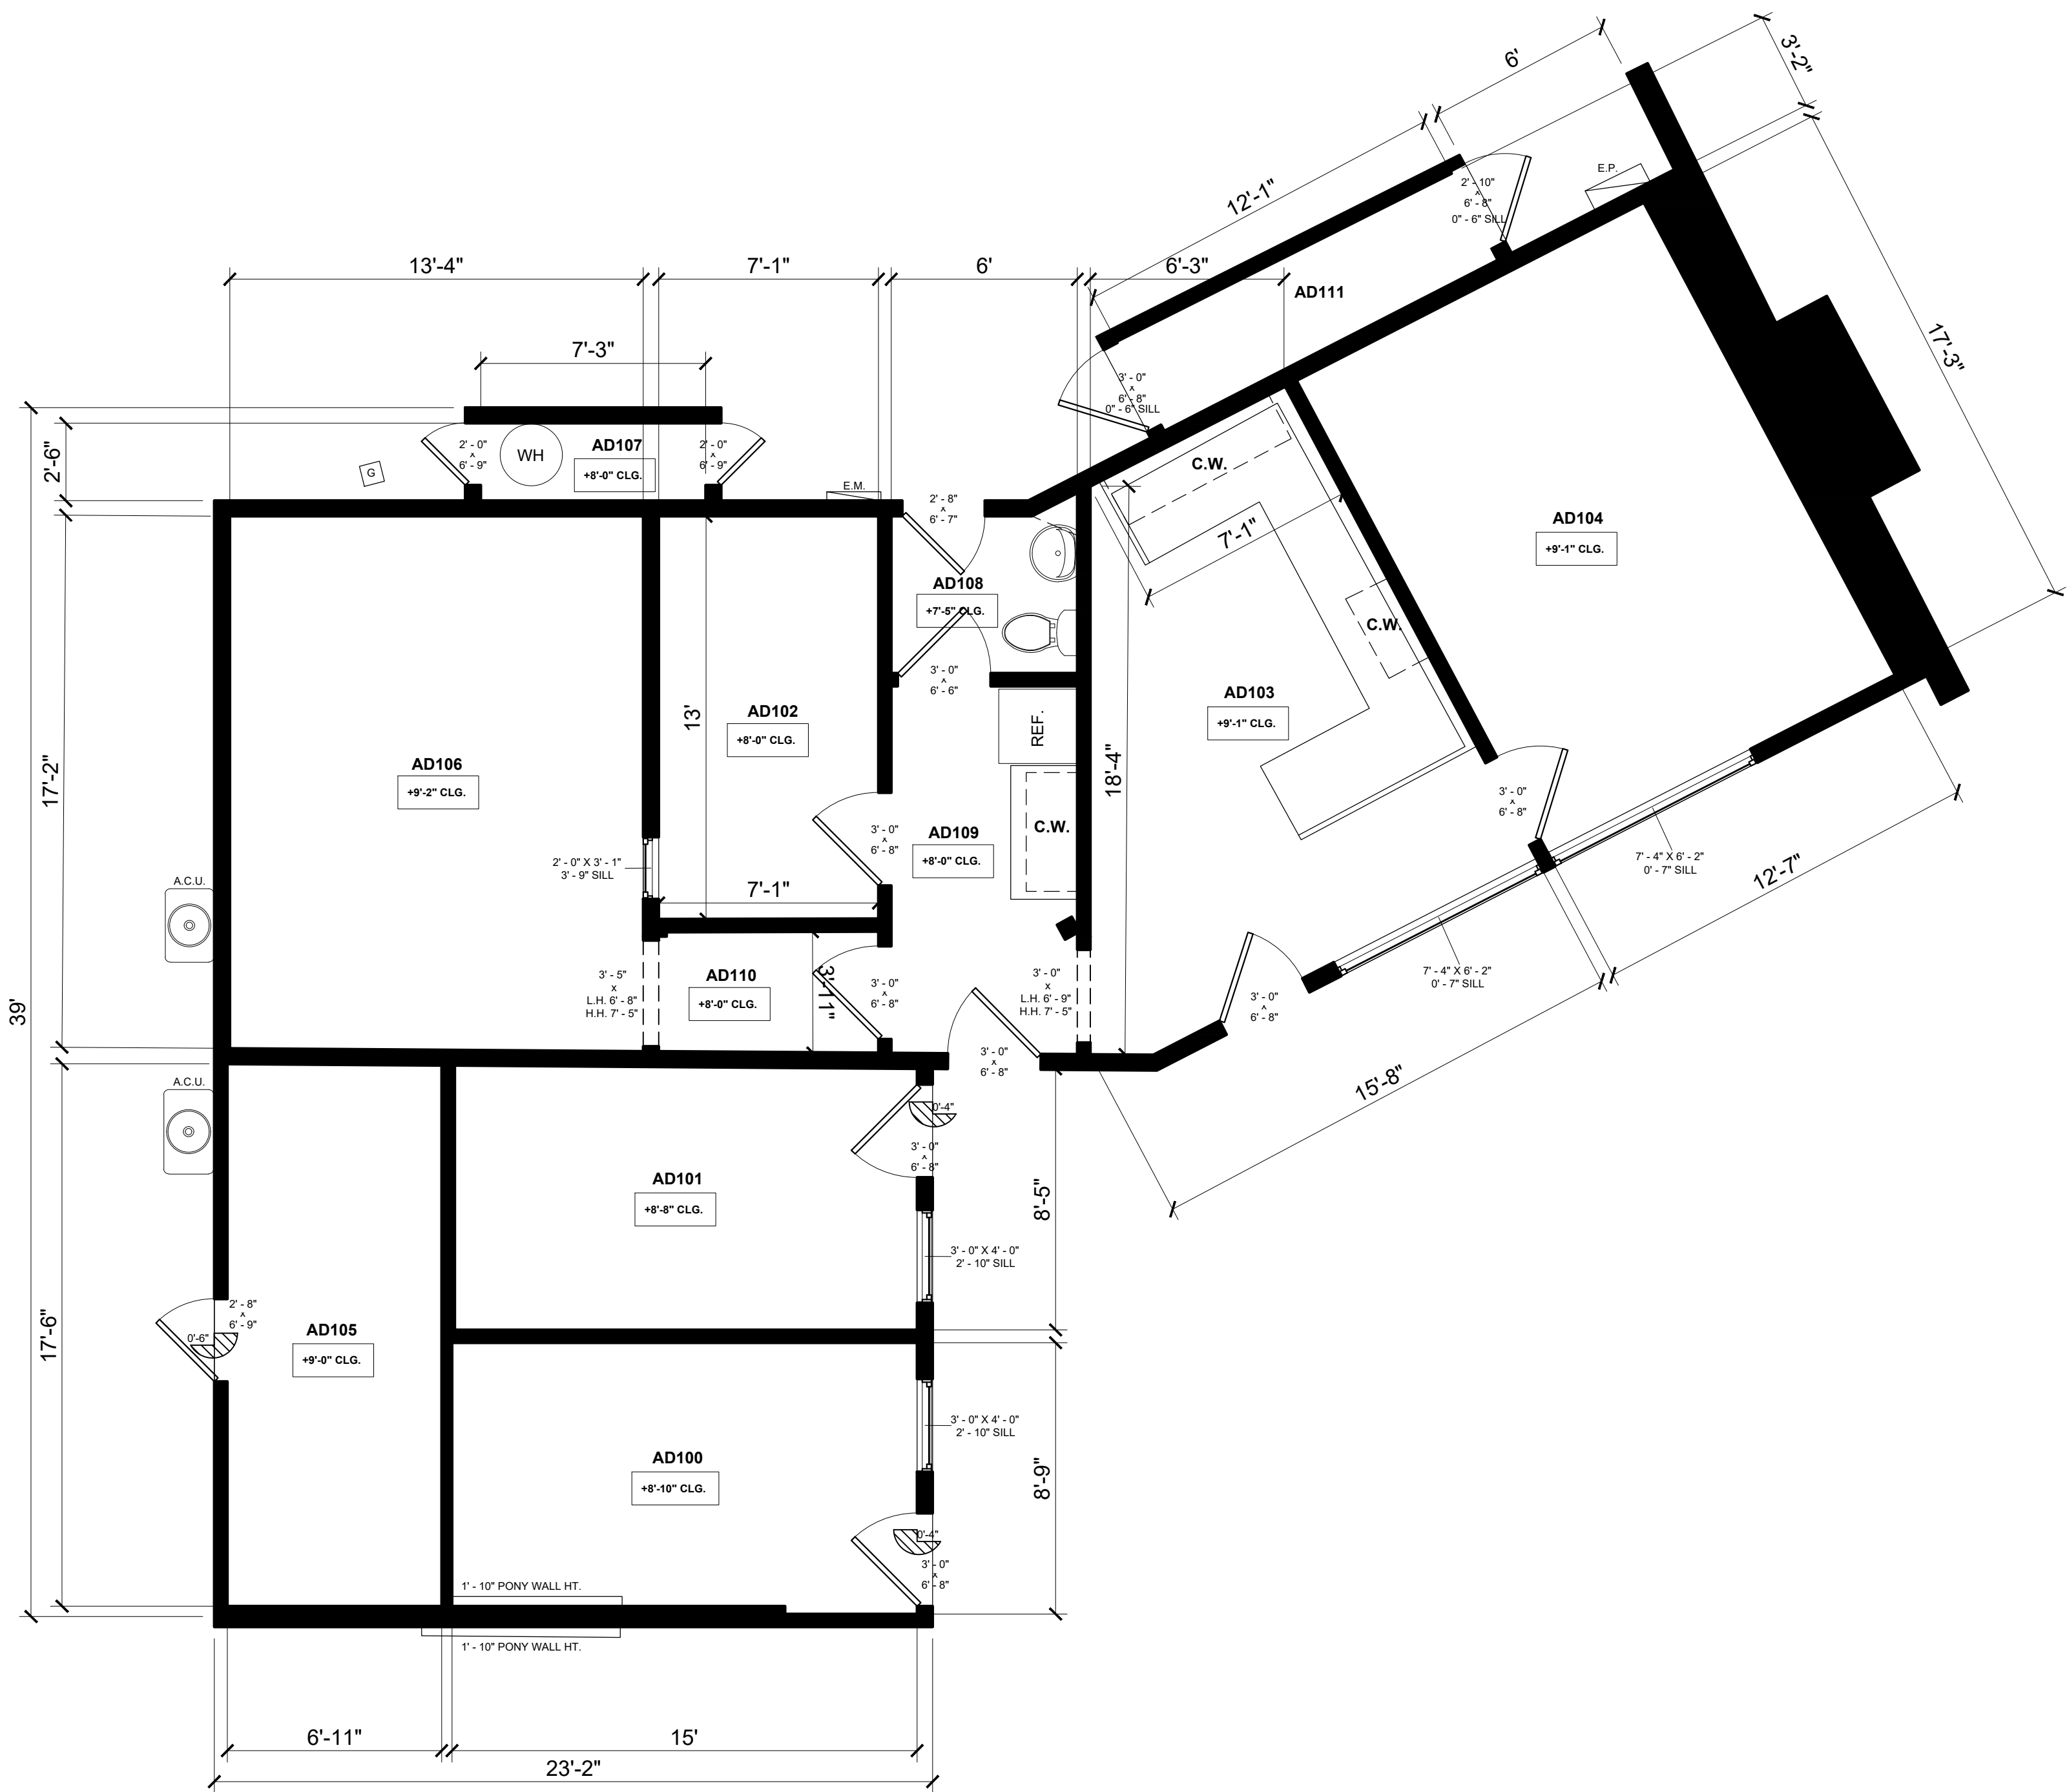

1 ADVANCEMENT HOUSE - EXISTING FLOOR PLAN
1/4" = 1'-0"

FLOOR PLAN LEGEND		HARVARD WESTLAKE SCHOOL ABLA AS BUILT LA 21255 BURBANK BLVD, STE 120 WOODLAND HILLS, CA 91367 WWW.ASBUILTLA.COM INFO@ASBUILTLA.COM (818)-208-3616
	WINDOW WIDTH X HEIGHT - SILL HEIGHT	
C.W.	CASEWORK / CABINETRY / BUILT-INS	
C.T.	COUNTERTOP / ISLAND	
F.P.	FIREPLACE	
T.O.	TOP OF	
B.O.	BOTTOM OF	
+X' - X' CLG.	CEILING AT HIGHEST POINT	
+X' - X'	LEVEL CHANGE	
X'	STEP DIRECTION & HEIGHT	
NOTES REGARDING AREA SIZING		DRAWN BY: PG CHECKED BY: F.P.S. DATE: 11/01/2025 PROJECT ID: 4578 SHEET SIZE: 48" X 36" 2D CAD & PDF SCOPE OF WORK As Built Set
* AREA MEASUREMENTS ARE BASED ON TOTAL SQUARE FOOTAGE MEASURED FROM THE INTERIOR SIDE OF THE WALLS IN ADDITION TO THE EXTERIOR SIDE OF WALLS.		*** IT'S THE RESPONSIBILITY OF THE PROJECT DESIGN PROFESSIONAL TO DETERMINE THE PROPER BREAKDOWN OF SPACES SIZES AS REQUIRED PER LOCAL REGULATIONS, BUILDING AND PLANNING CODES AND PROVIDE COMPLIANCE DOCUMENTATION AS REQUIRED. **** WE RECOMMEND TO ALL OUR CUSTOMERS TO GET A LAND SURVEY OF THEIR PROPERTY WHICH PROVIDES ANOTHER LEVEL OF ACCURACY, SIZING INFORMATION FOR THE PROPERTY, BOUNDARIES, AND AS IS OFTEN REQUIRED BY CITY BUILDING & PLANNING DEPARTMENTS FOR PLAN CHECK REVIEWS.
** AREA CALCULATIONS ARE COMPLEMENTARY AND WILL NOT NECESSARILY MATCH WHAT IS ON BUILDING OR REAL ESTATE RECORDS.		