


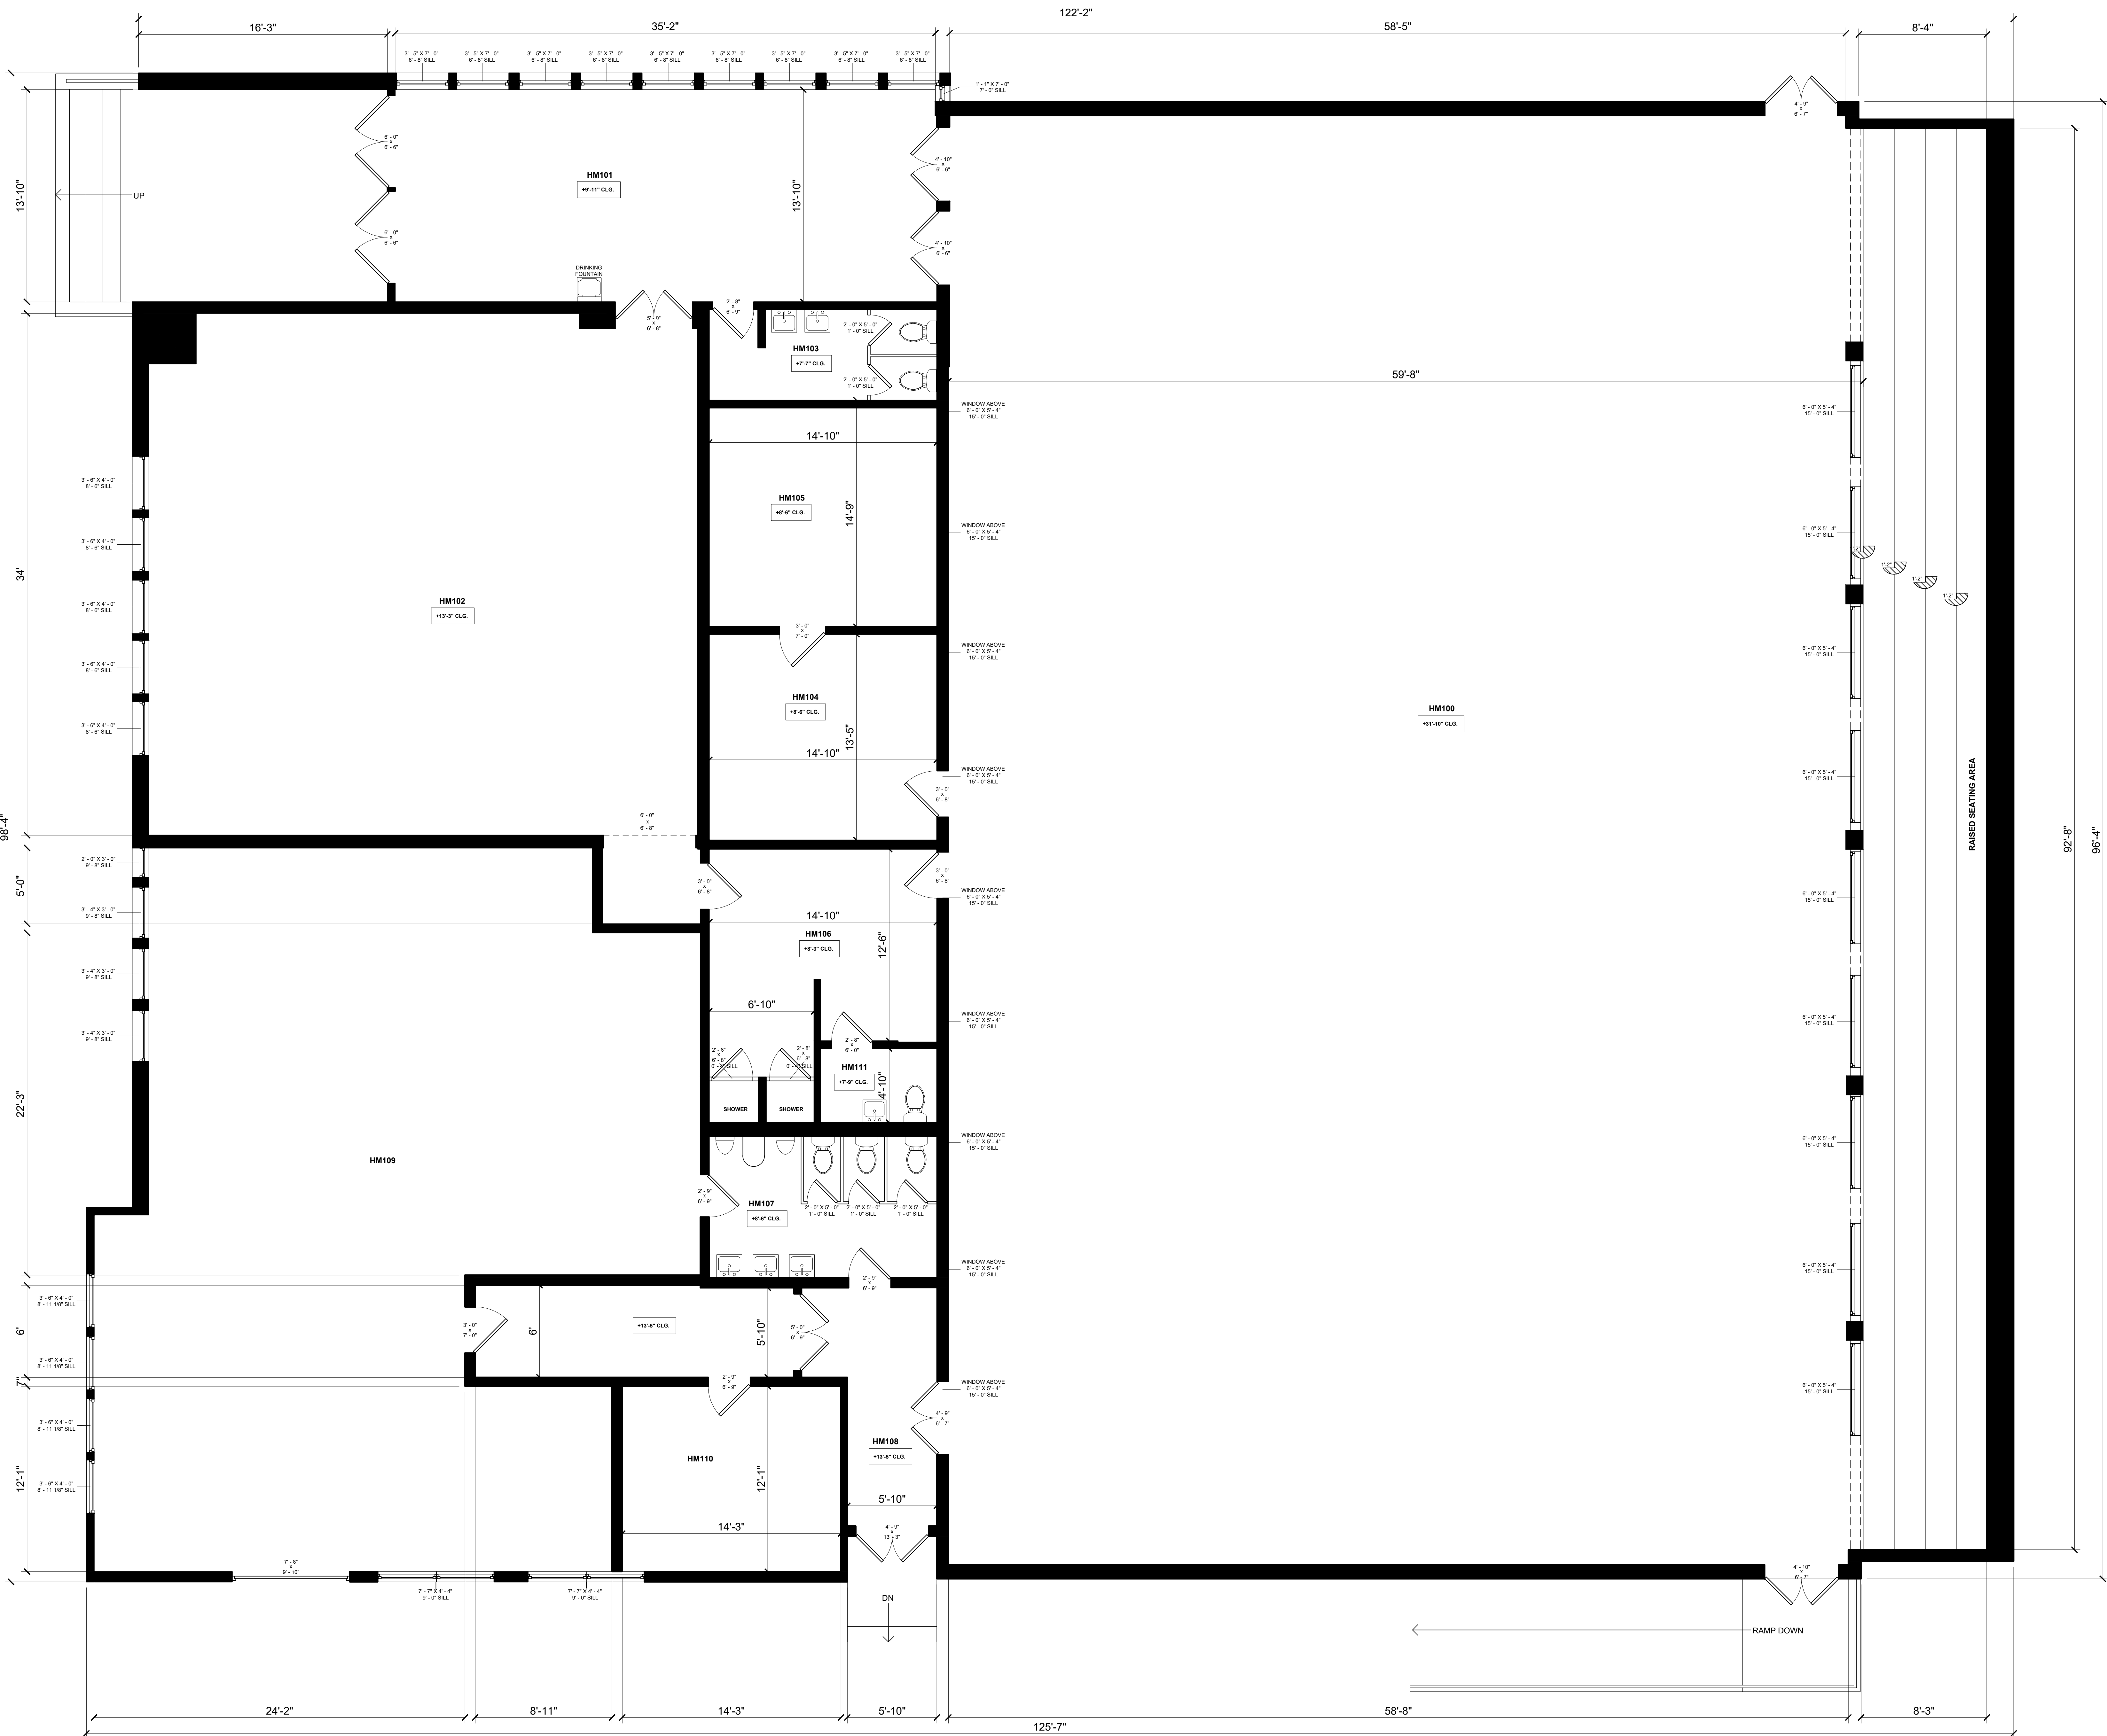

1 HAMILTON GYM - EXISTING FLOOR PLAN
1/4" = 1'-0"

FLOOR PLAN LEGEND		HARVARD WESTLAKE SCHOOL ABLA AS BUILT LA 21255 BURBANK BLVD, STE 120 WOODLAND HILLS, CA 91367 WWW.ASBUILT.LA.COM INFO@ASBUILT.LA.COM (818)-208-3616	
	WINDOW WIDTH X HEIGHT - SILL HEIGHT		
C.W.	CASEWORK / CABINETRY / BUILT-INS		
C.T.	COUNTERTOP / ISLAND		
F.P.	FIREPLACE		
T.O.	TOP OF		
B.O.	BOTTOM OF		
+X' - X' CLG.	CEILING AT HIGHEST POINT	DRAWN BY:	PG
+X' - X'	LEVEL CHANGE	CHECKED BY:	F.P.S.
X'	STEP DIRECTION & HEIGHT	DATE:	11/01/2025
NOTES REGARDING AREA SIZING		PROJECT ID	4578
		SHEET SIZE	48" X 36"
		2D CAD & PDF	
		SCOPE OF WORK	
* AREA MEASUREMENTS ARE BASED ON TOTAL SQUARE FOOTAGE MEASURED FROM THE INTERIOR SIDE OF THE WALLS IN ADDITION TO THE EXTERIOR SIDE OF WALLS.		As Built Set	
** AREA CALCULATIONS ARE COMPLIMENTARY AND WILL NOT NECESSARILY MATCH WHAT IS ON BUILDING OR REAL ESTATE RECORDS.			
*** IT'S THE RESPONSIBILITY OF THE PROJECT DESIGN PROFESSIONAL TO DETERMINE THE PROPER BREAKDOWN OF SPACES SIZES AS REQUIRED PER LOCAL REGULATIONS, BUILDING AND PLANNING CODES AND PROVIDE COMPLIANCE DOCUMENTATION AS REQUIRED.			
**** WE RECOMMEND TO ALL OUR CUSTOMERS TO GET A LAND SURVEY OF THEIR PROPERTY WHICH PROVIDES ANOTHER LEVEL OF ACCURACY, SIZING INFORMATION FOR THE PROPERTY, BOUNDARIES, AND AS IS OFTEN REQUIRED BY CITY BUILDING & PLANNING DEPARTMENTS FOR PLAN CHECK REVIEWS.			
N PROJECT N TRUE		AREA CALCULATIONS	
		Existing - Interior	9,628 SF
		Existing - Exterior	10,062 SF
		HM100	6,391 SF
		HM101	487 SF
		HM102	1,218 SF
		HM103	88 SF
		HM104	199 SF
		HM105	211 SF
		HM106	265 SF
		HM107	126 SF
		HM108	237 SF
		HM109	1558 SF
		HM110	172 SF
		HM111	37 SF
		PROJECT ADDRESS:	
		3700 Coldwater Canyon Ave. Los Angeles, CA 91604	
		SHEET TITLE:	
		Hamilton Gym Floor Plans	
		SCALE: AS NOTED	
		SHEET NUMBER: AB-117	