



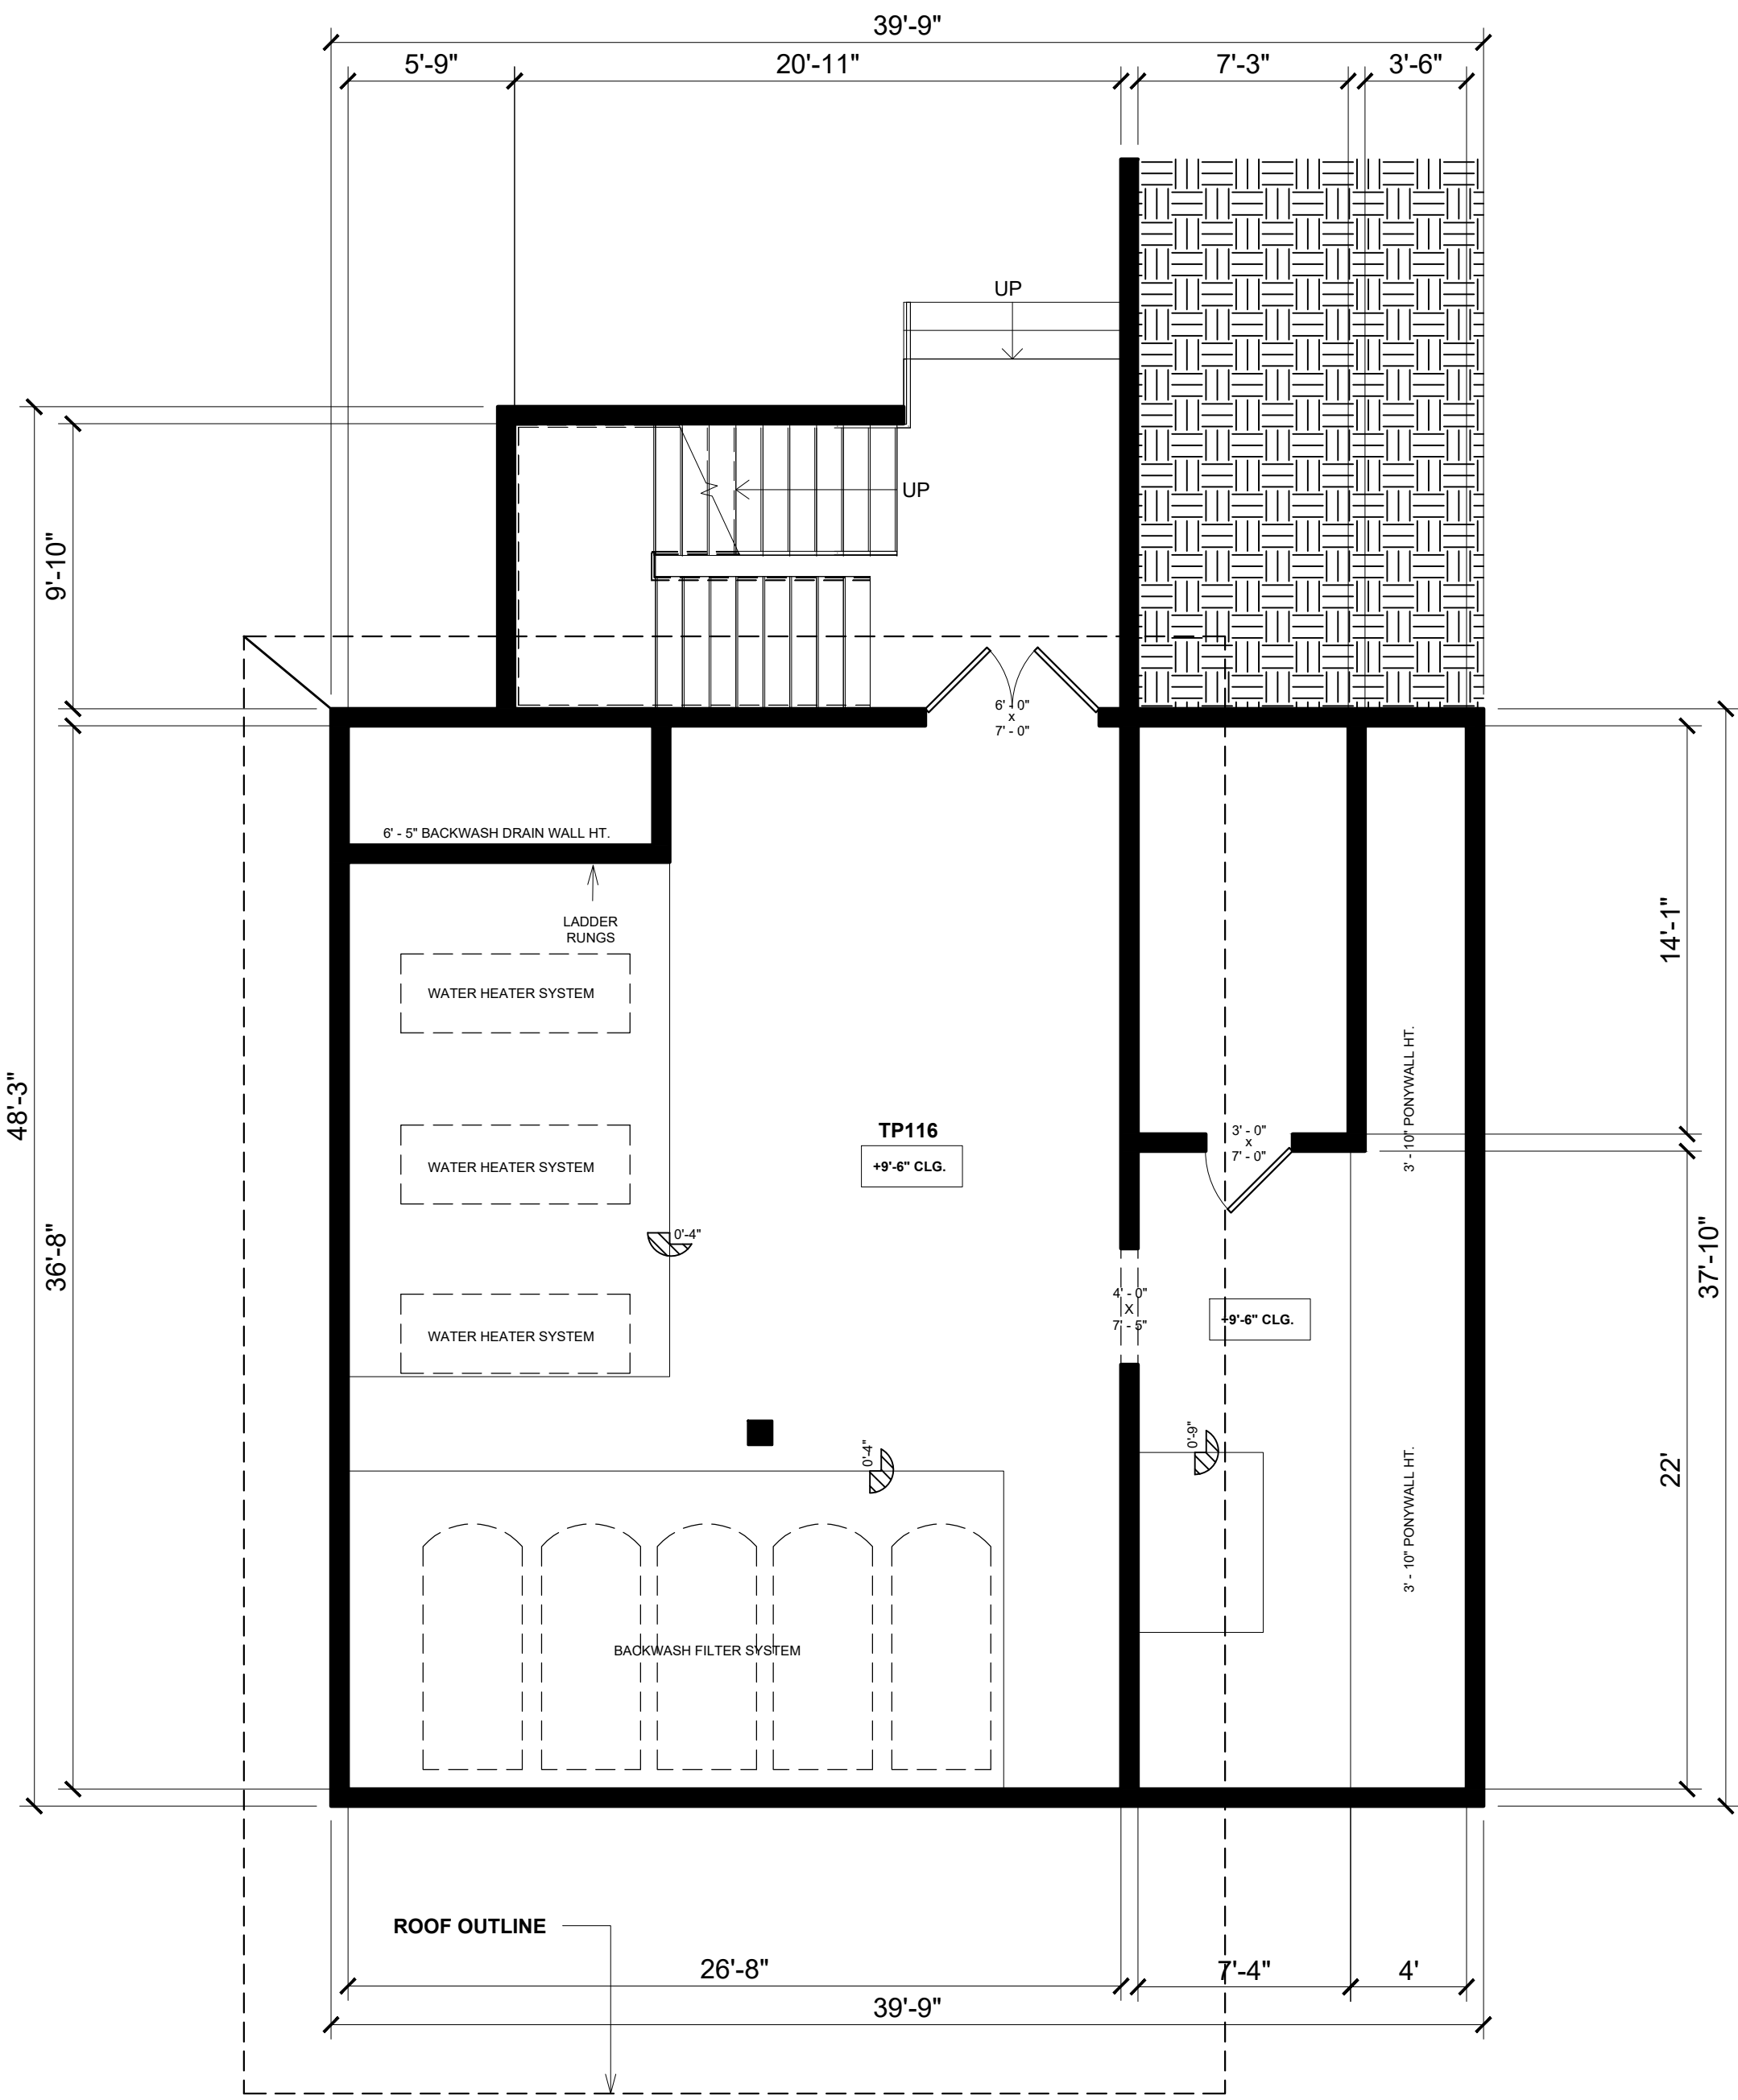

1 TAPER ATHLETIC PAVILLION (POOL HOUSE) - EXISTING GROUND FLOOR PLAN
3/16" = 1'-0"

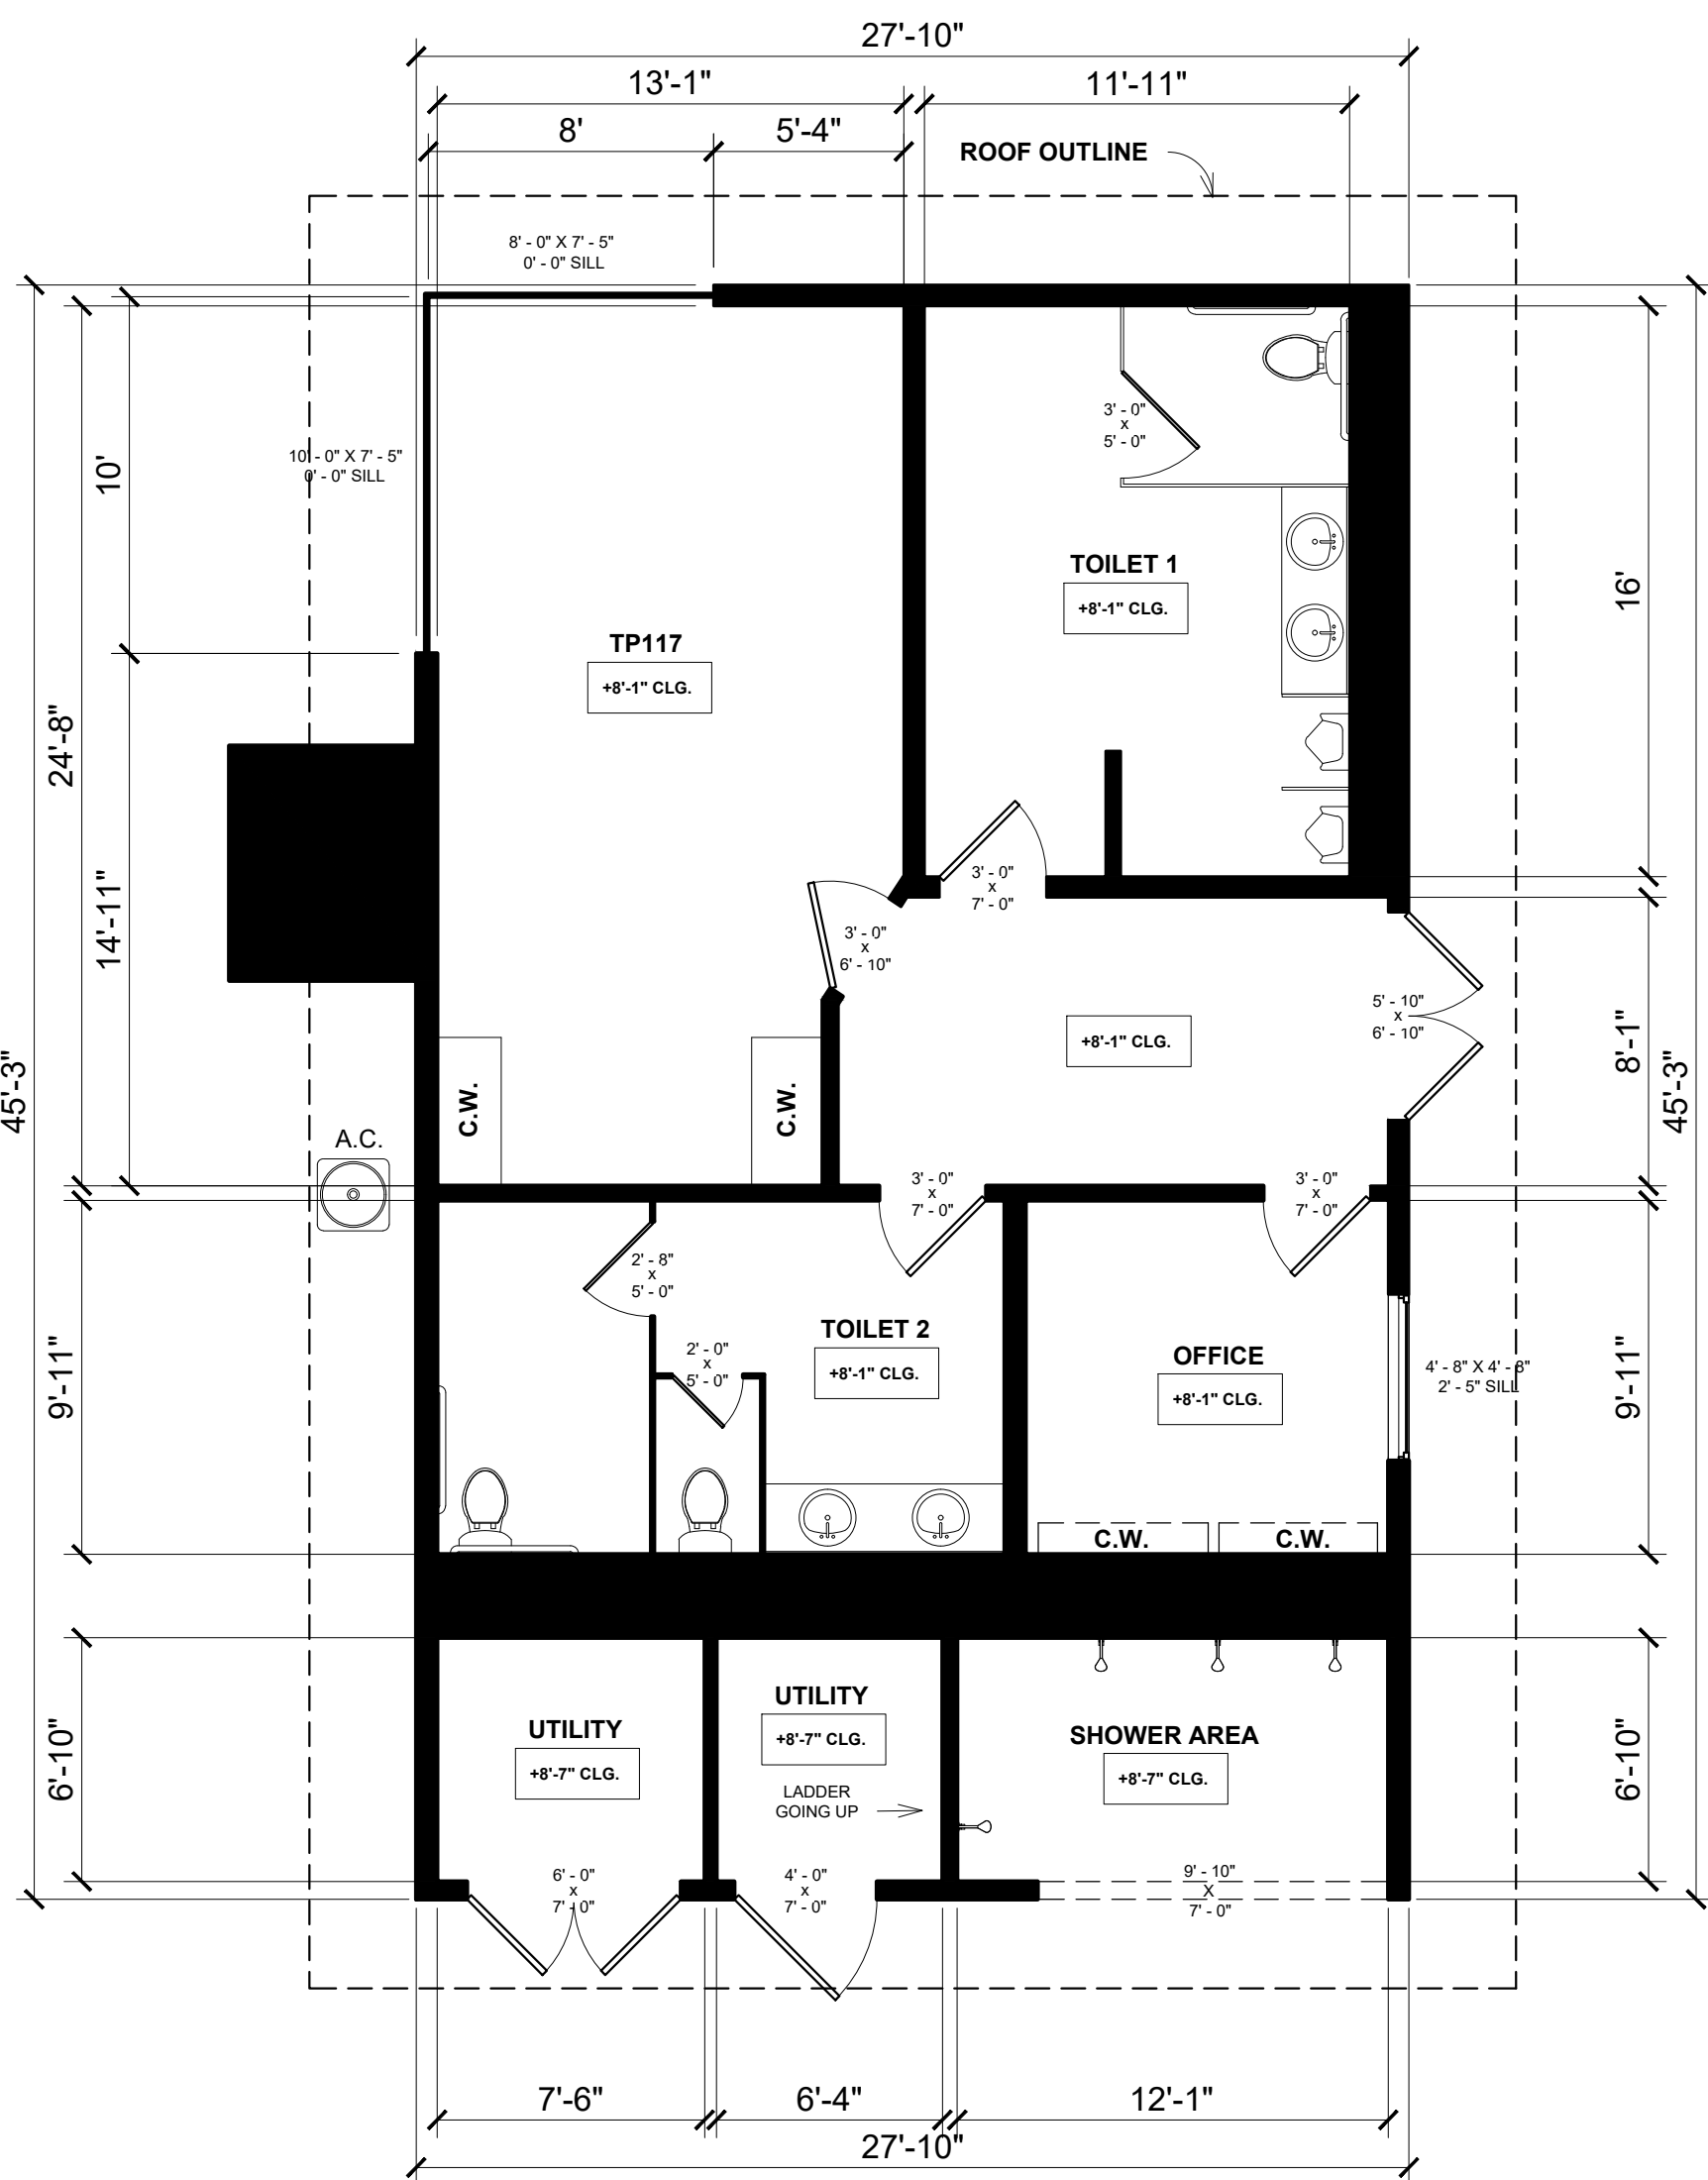

2 TAPER ATHLETIC PAVILLION (POOL HOUSE) - EXISTING SECOND FLOOR PLAN
3/16" = 1'-0"

FLOOR PLAN LEGEND		HARVARD WESTLAKE SCHOOL ABLA AS BUILT LA 21255 BURBANK BLVD, STE 120 WOODLAND HILLS, CA 91367 WWW.ASBUILT.LA.COM INFO@ASBUILT.LA.COM (818)-208-3616
	WINDOW WIDTH X HEIGHT - SILL HEIGHT	
C.W.	CASEWORK / CABINETRY / BUILT-INS	
C.T.	COUNTERTOP / ISLAND	
F.P.	FIREPLACE	
T.O.	TOP OF	
B.O.	BOTTOM OF	
+X' - X' CLG.	CEILING AT HIGHEST POINT	
+X' - X'	LEVEL CHANGE	
X'	STEP DIRECTION & HEIGHT	
NOTES REGARDING AREA SIZING		DRAWN BY: E.P.
* AREA MEASUREMENTS ARE BASED ON TOTAL SQUARE FOOTAGE MEASURED FROM THE INTERIOR SIDE OF THE WALLS IN ADDITION TO THE EXTERIOR SIDE OF WALLS. ** AREA CALCULATIONS ARE COMPLEMENTARY AND WILL NOT NECESSARILY MATCH WHAT IS ON BUILDING OR REAL ESTATE RECORDS. *** IT'S THE RESPONSIBILITY OF THE PROJECT DESIGN PROFESSIONAL TO DETERMINE THE PROPER BREAKDOWN OF SPACES SIZES AS REQUIRED PER LOCAL REGULATIONS, BUILDING AND PLANNING CODES AND PROVIDE COMPLIANCE DOCUMENTATION AS REQUIRED. **** WE RECOMMEND TO ALL OUR CUSTOMERS TO GET A LAND SURVEY OF THEIR PROPERTY WHICH PROVIDES ANOTHER LEVEL OF ACCURACY, SIZING INFORMATION FOR THE PROPERTY, BOUNDARIES, AND AS IS OFTEN REQUIRED BY CITY BUILDING & PLANNING DEPARTMENTS FOR PLAN CHECK REVIEWS.		CHECKED BY: F.P.S.
		DATE: 11/01/2025
		PROJECT ID: 3700
		SHEET SIZE: 48" X 36"
SCOPE OF WORK		
As Built Set		
AREA CALCULATIONS		
TP101	189 SF	
TP102	552 SF	
TP103	130 SF	
TP104	151 SF	
TP105	130 SF	
TP106	164 SF	
TP107	355 SF	
TP108	207 SF	
TP109	372 SF	
TP110	1381 SF	
TP111	2894 SF	
TP112	1113 SF	
TP113	1102 SF	
TP114	10482 SF	
TP115	101 SF	
TP116	1415 SF	
TP117	307 SF	
PROJECT ADDRESS:		
3700 Coldwater Canyon Ave. Los Angeles, CA 91604		
SHEET TITLE:		
Taper Pavillion Floor Plans		
SCALE:		AS NOTED
SHEET NUMBER:		AB-112