




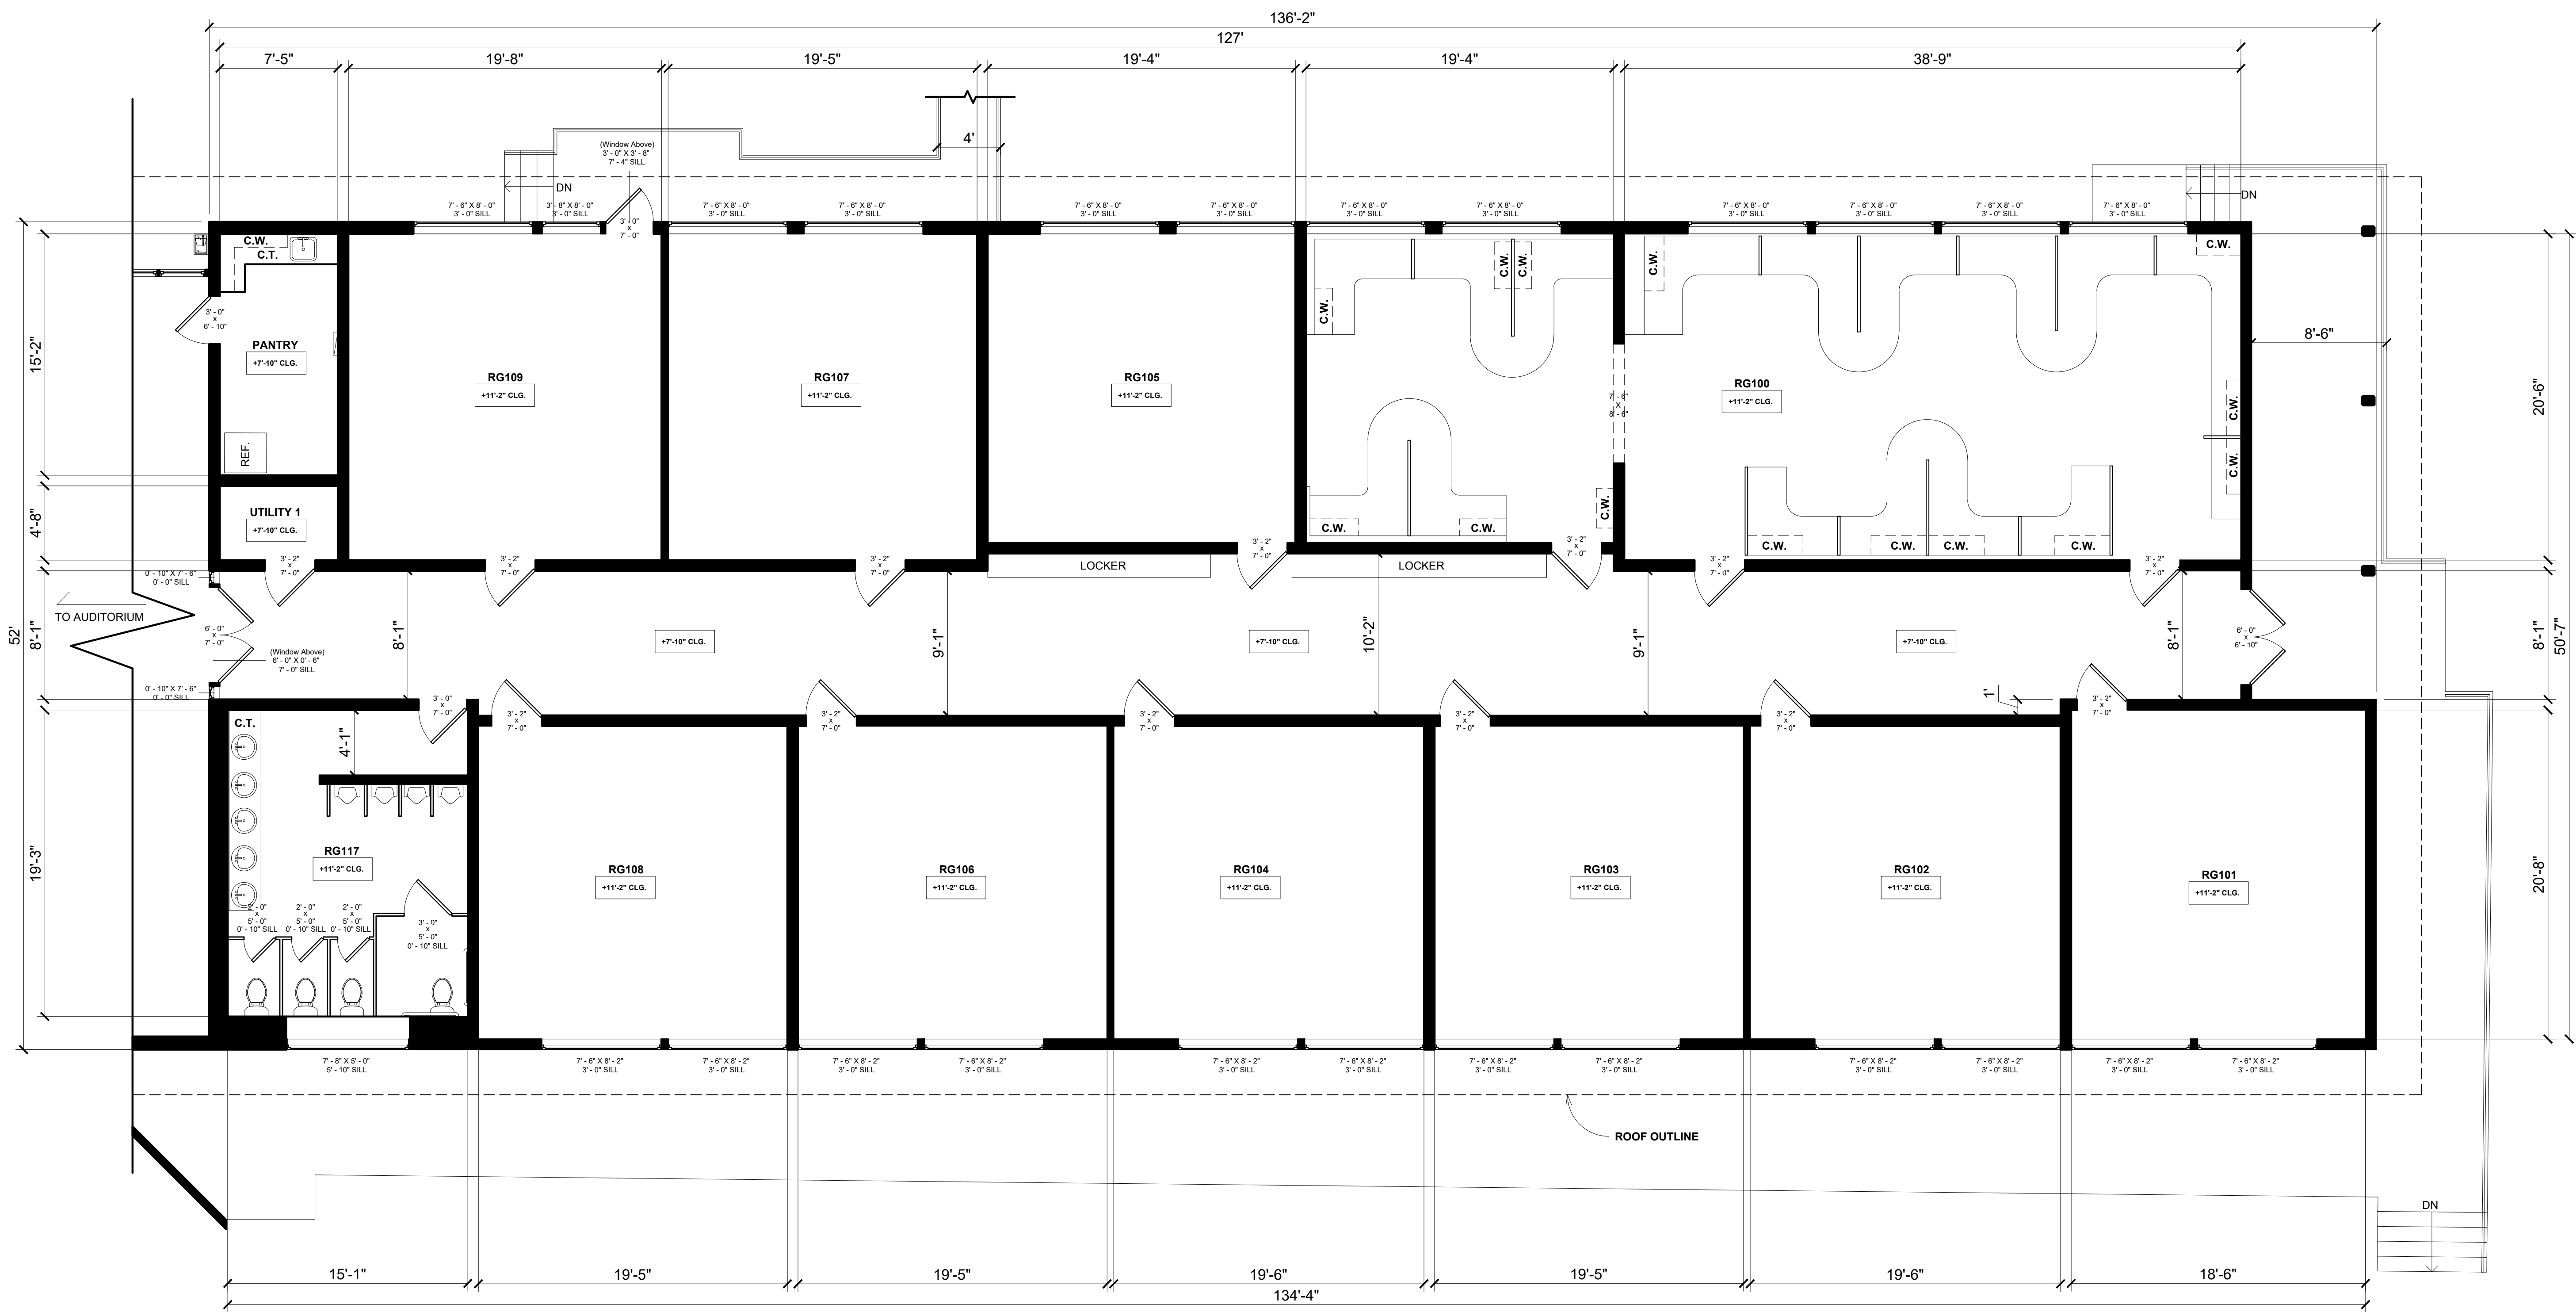


1 RUGBY BUILDING (CLASSROOMS) - EXISTING 1ST FLOOR PLAN
3/16" = 1'-0"

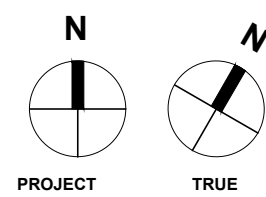


FLOOR PLAN LEGEND		HARVARD WESTLAKE SCHOOL A B L A AS BUILT LA 21255 BURBANK BLVD, STE 120 WOODLAND HILLS, CA 91367 WWW.ASBUILT.LA.COM INFO@ASBUILT.LA.COM (818)-208-3616	
	WINDOW WIDTH X HEIGHT - SILL HEIGHT		
C.W.	CASEWORK / CABINETRY / BUILT-INS		
C.T.	COUNTERTOP / ISLAND		
F.P.	FIREPLACE		
T.O.	TOP OF		
B.O.	BOTTOM OF		
+X' - X' CLG.	CEILING AT HIGHEST POINT		
+X' - X'	LEVEL CHANGE		
X'	STEP DIRECTION & HEIGHT		
NOTES REGARDING AREA SIZING		DRAWN BY:	E.P.
* AREA MEASUREMENTS ARE BASED ON TOTAL SQUARE FOOTAGE MEASURED FROM THE INTERIOR SIDE OF THE WALLS IN ADDITION TO THE EXTERIOR SIDE OF WALLS. ** AREA CALCULATIONS ARE COMPLIMENTARY AND WILL NOT NECESSARILY MATCH WHAT IS ON BUILDING OR REAL ESTATE RECORDS. *** IT'S THE RESPONSIBILITY OF THE PROJECT DESIGN PROFESSIONAL TO DETERMINE THE PROPER BREAKDOWN OF SPACES SIZES AS REQUIRED PER LOCAL REGULATIONS, BUILDING AND PLANNING CODES AND PROVIDE COMPLIANCE DOCUMENTATION AS REQUIRED. **** WE RECOMMEND TO ALL OUR CUSTOMERS TO GET A LAND SURVEY OF THEIR PROPERTY WHICH PROVIDES ANOTHER LEVEL OF ACCURACY, SIZING INFORMATION FOR THE PROPERTY, BOUNDARIES, AND AS IS OFTEN REQUIRED BY CITY BUILDING & PLANNING DEPARTMENTS FOR PLAN CHECK REVIEWS.		CHECKED BY:	N.D.B.
		DATE:	11/01/2025
		PROJECT ID	4578
		SHEET SIZE	48" X 36"
		DELIVERABLES	2D CAD & PDF
		SCOPE OF WORK	
		As Built Set	

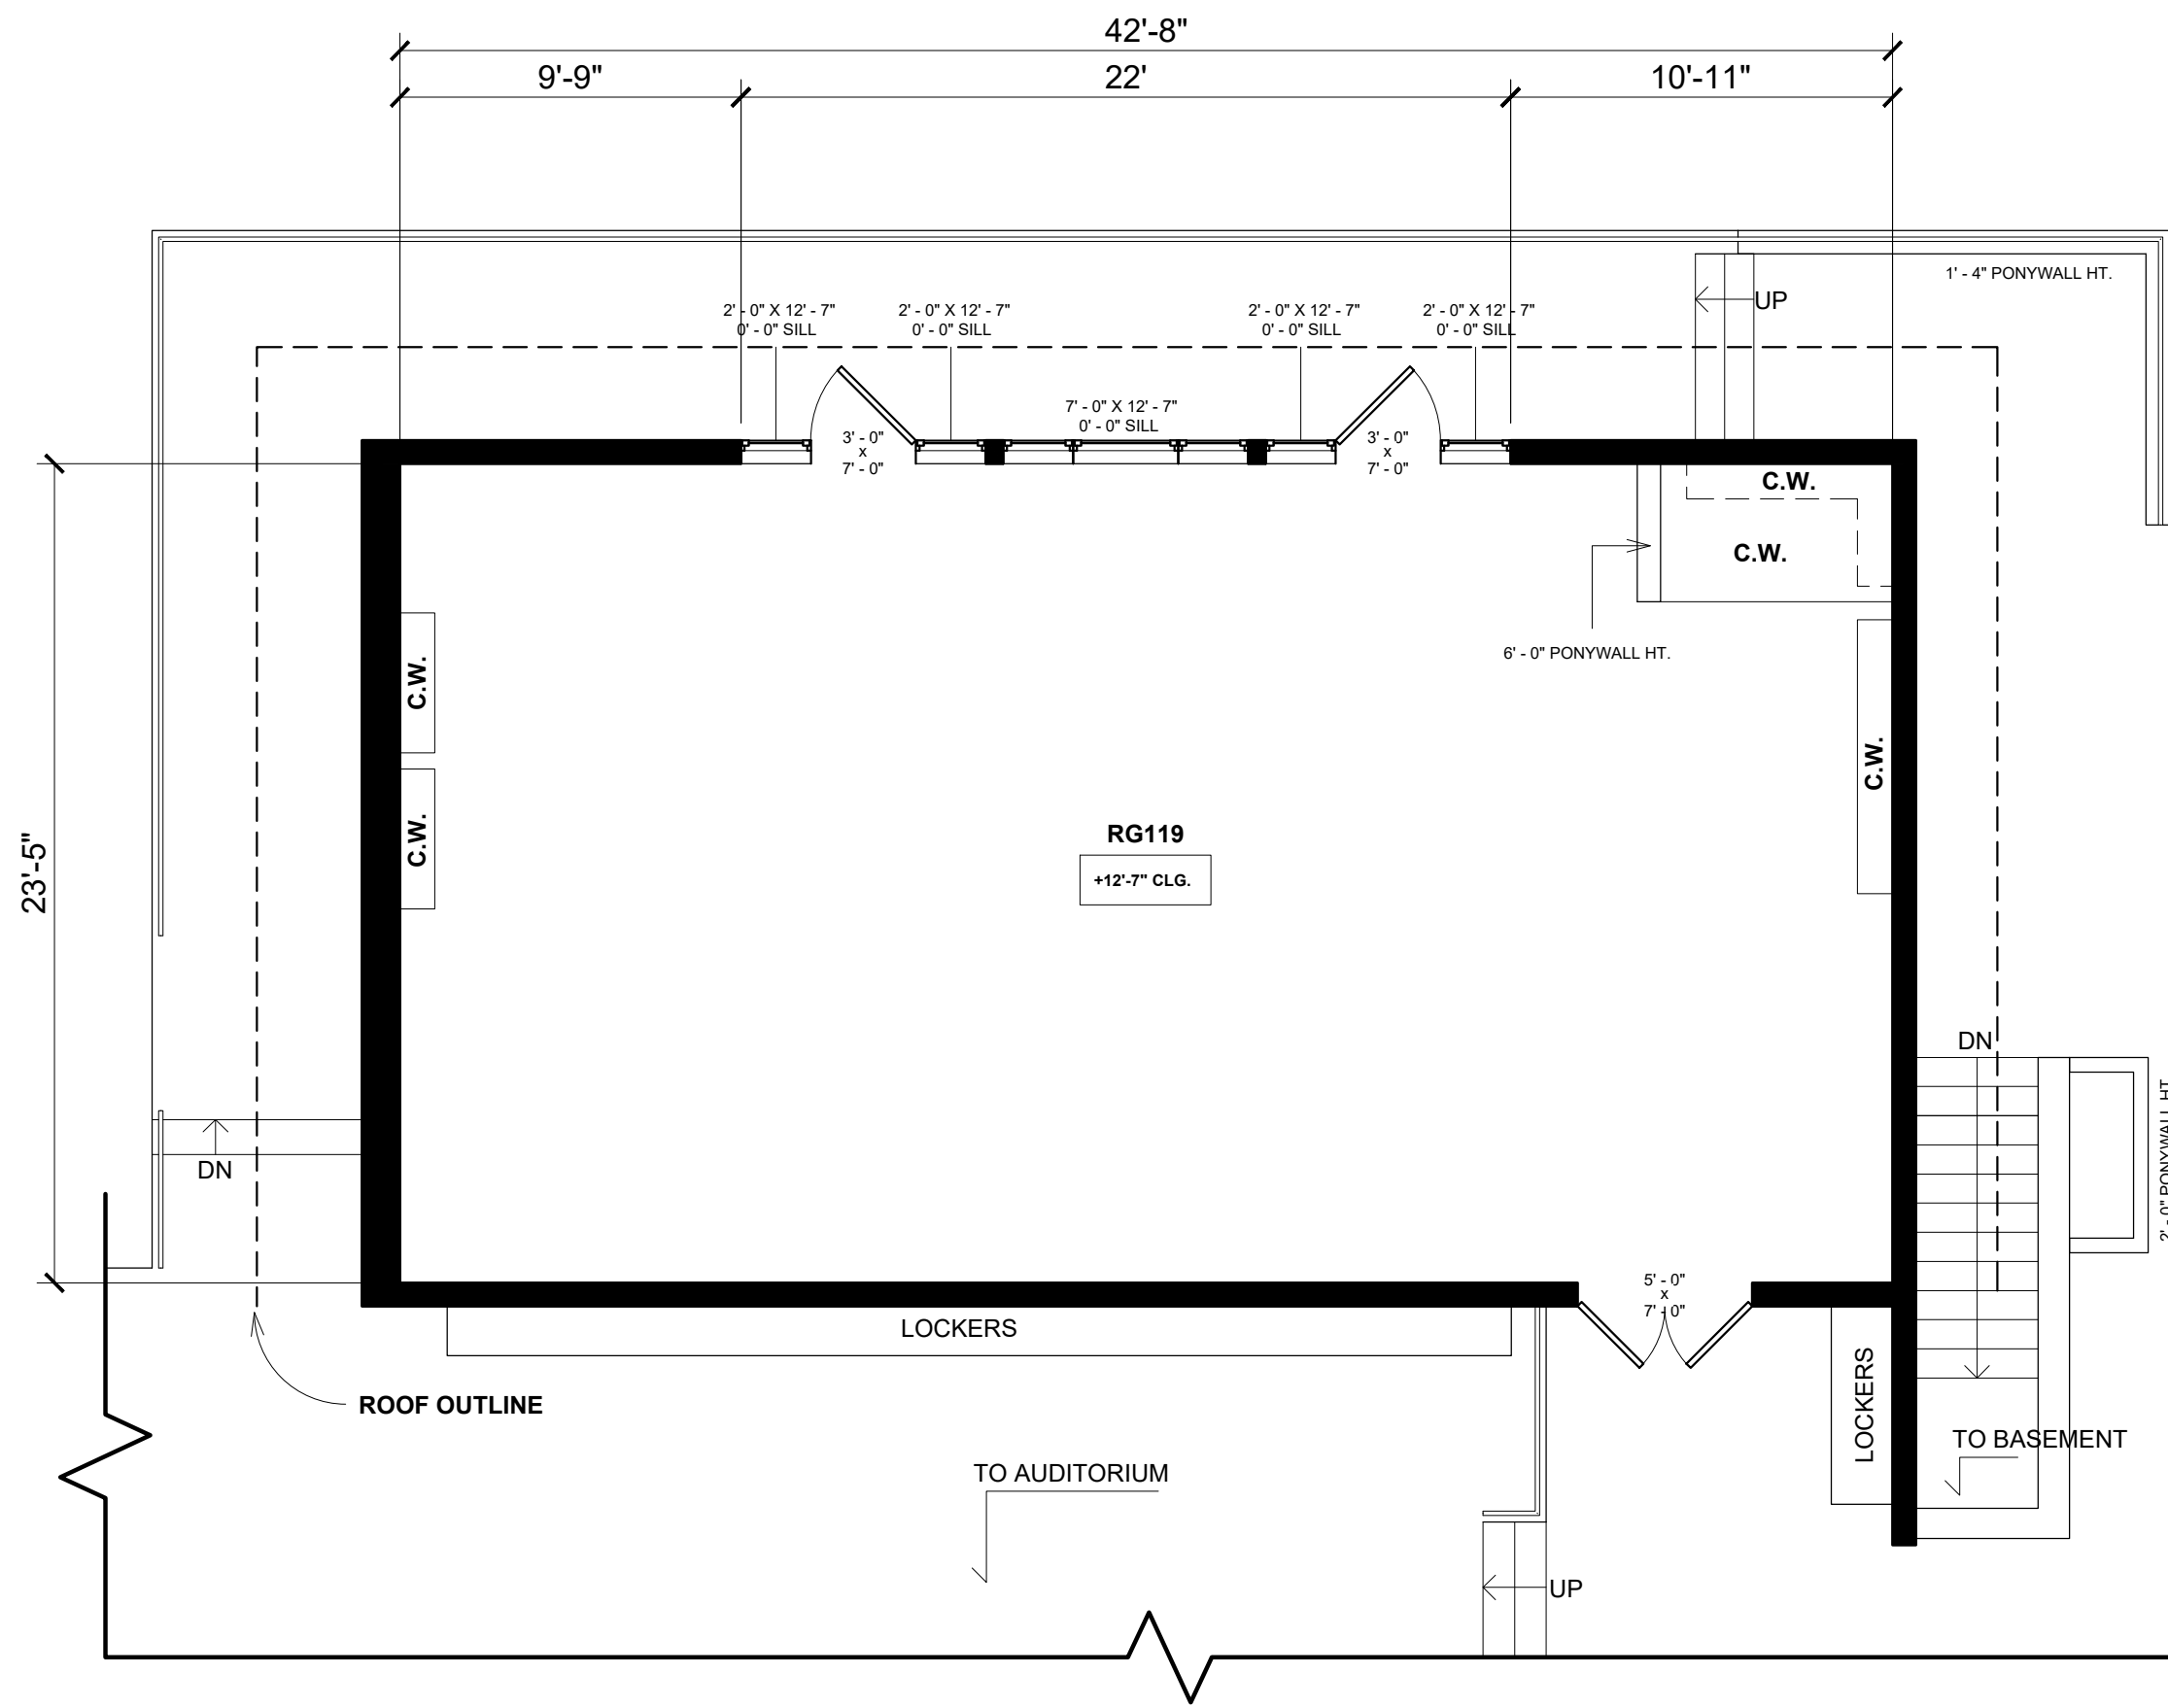


2 RUGBY BUILDING (DRAMA LAB) - EXISTING 1ST FLOOR PLAN
3/16" = 1'-0"

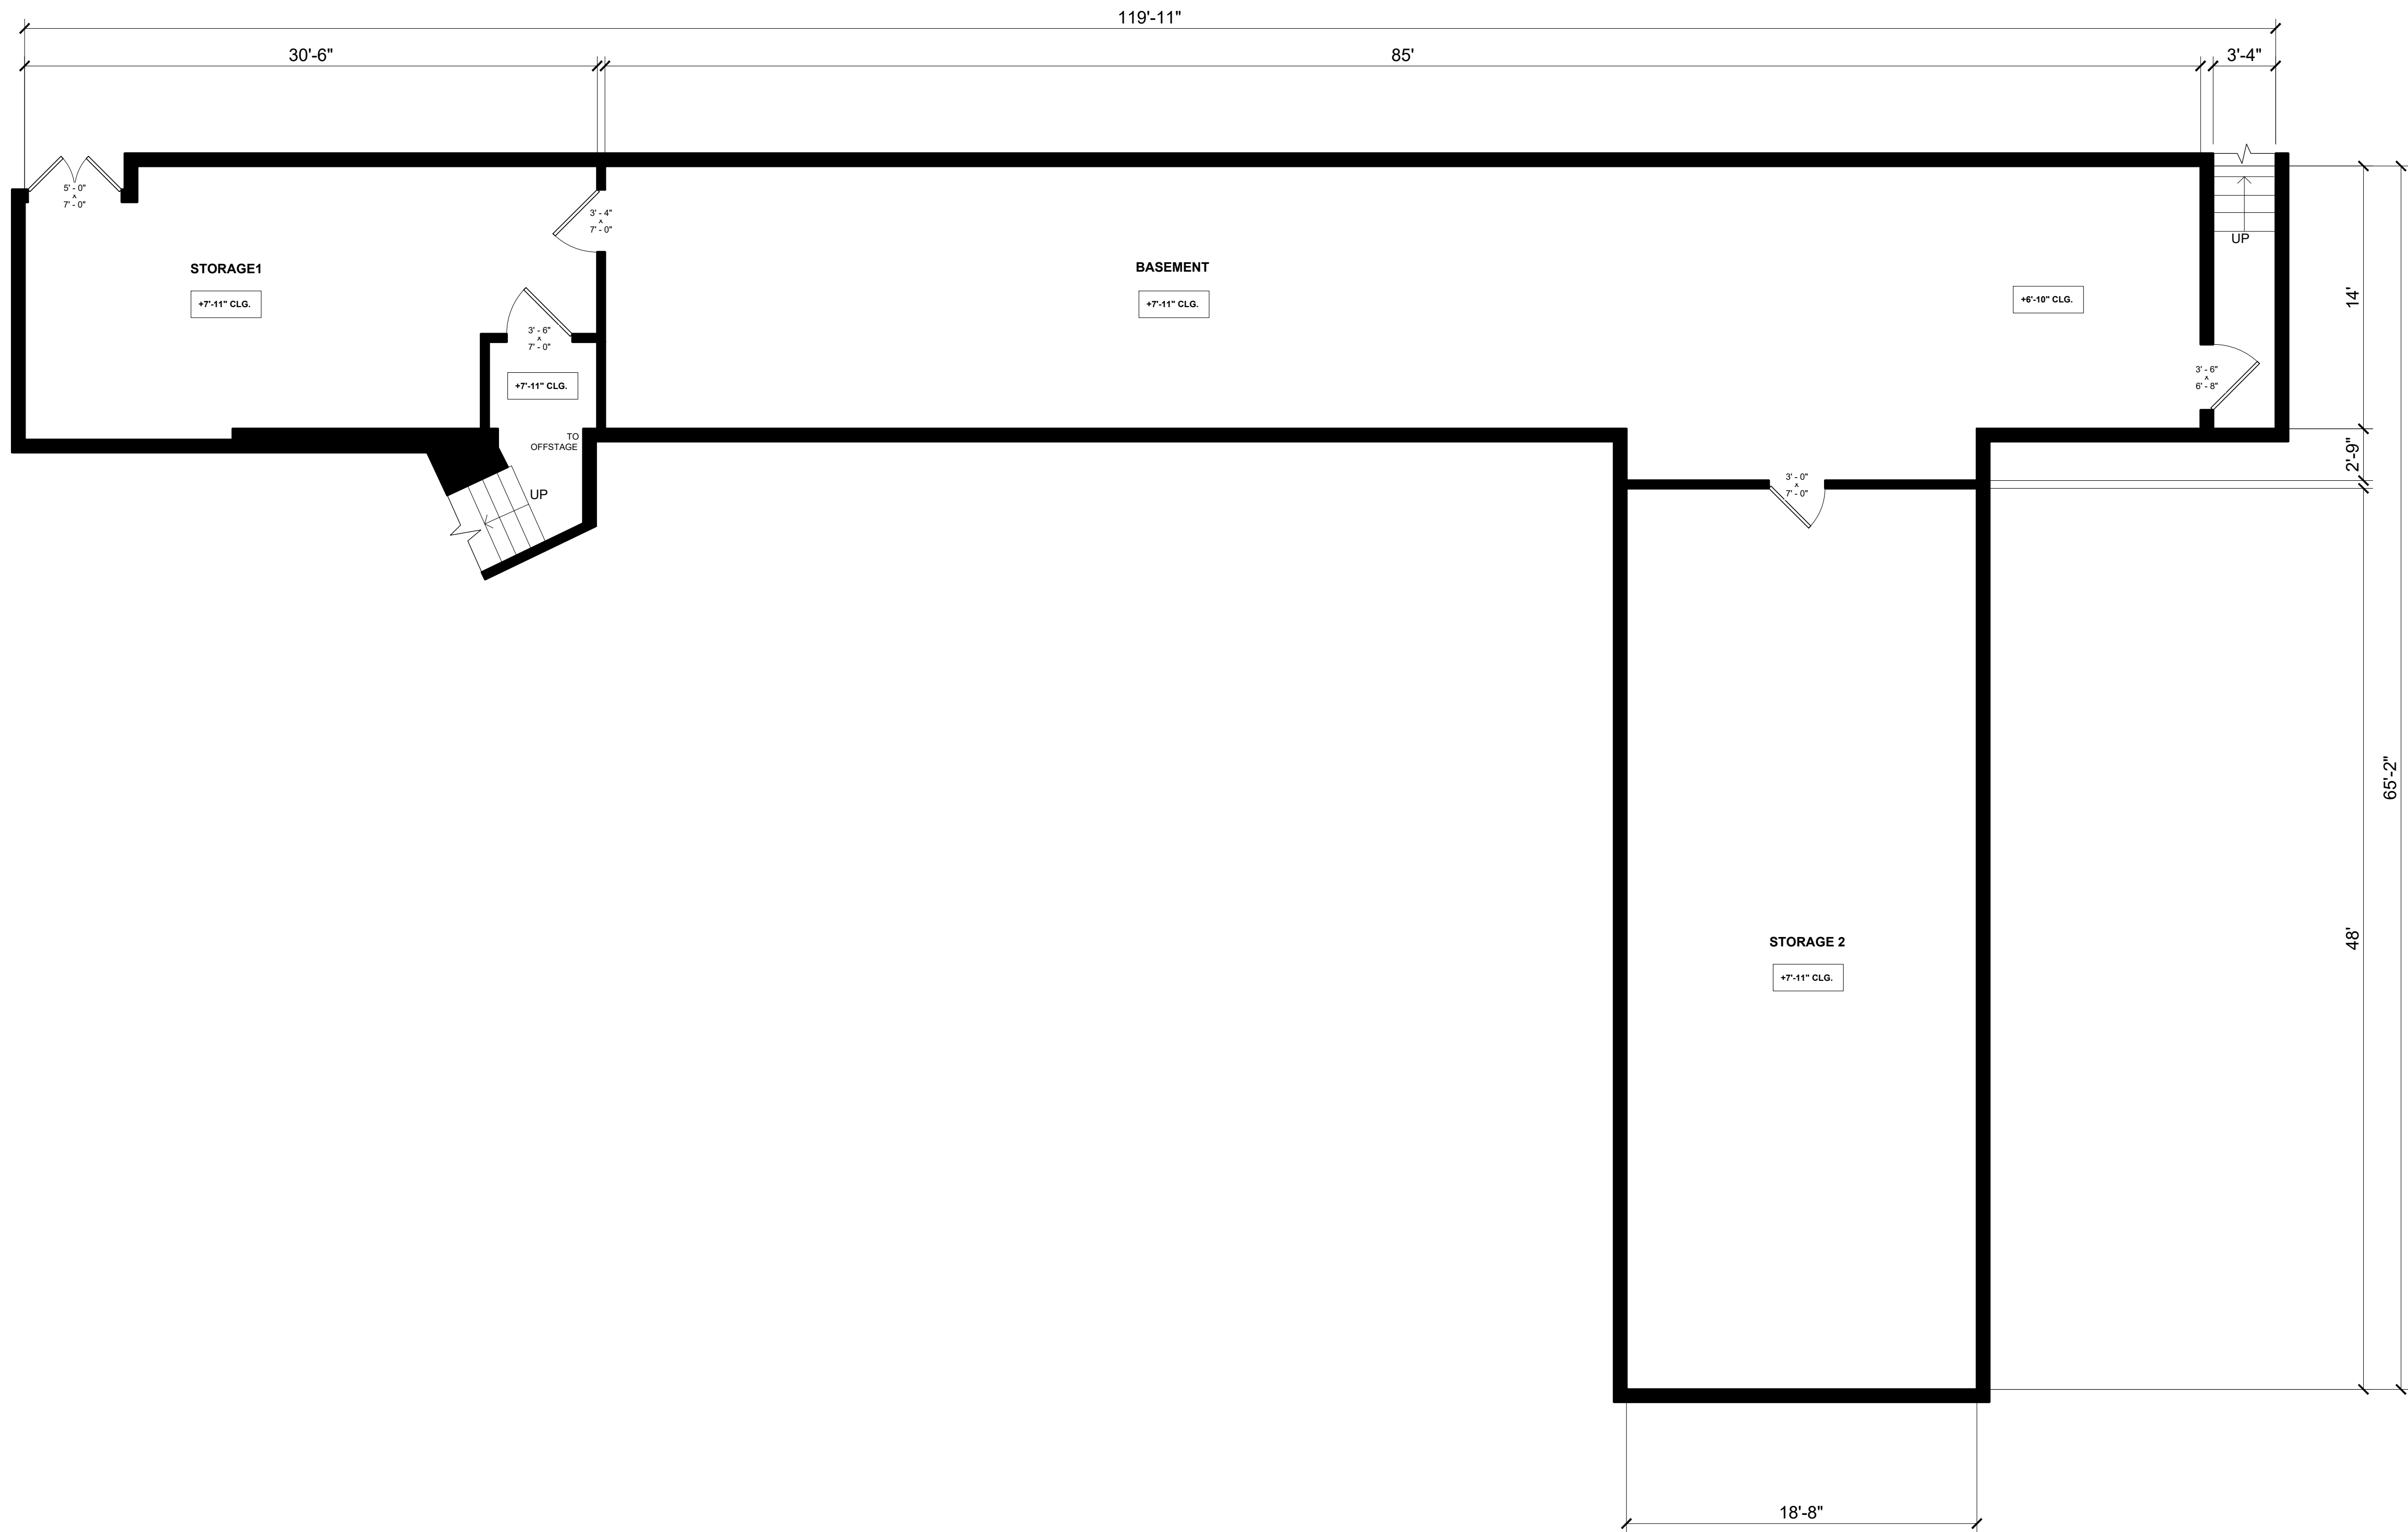


1 RUGBY BUILDING (AUDITORIUM) - EXISTING BASEMENT PLAN
3/16" = 1'-0"




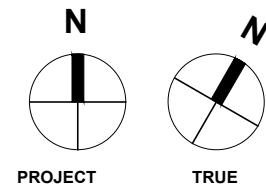


FLOOR PLAN LEGEND		HARVARD WESTLAKE SCHOOL ABLA AS BUILT LA 21255 BURBANK BLVD, STE 120 WOODLAND HILLS, CA 91367 WWW.ASBUILTLA.COM INFO@ASBUILTLA.COM (818)-208-3616	
	WINDOW WIDTH X HEIGHT - SILL HEIGHT		
C.W.	CASEWORK / CABINETRY / BUILT-INS		
C.T.	COUNTERTOP / ISLAND		
F.P.	FIREPLACE		
T.O.	TOP OF		
B.O.	BOTTOM OF		
+X" - X" CLG.	CEILING AT HIGHEST POINT		
+X" - X"	LEVEL CHANGE		
X" - X"	STEP DIRECTION & HEIGHT		
NOTES REGARDING AREA SIZING		DRAWN BY:	E.P.
* AREA MEASUREMENTS ARE BASED ON TOTAL SQUARE FOOTAGE MEASURED FROM THE INTERIOR SIDE OF THE WALLS IN ADDITION TO THE EXTERIOR SIDE OF WALLS. ** AREA CALCULATIONS ARE COMPLIMENTARY AND WILL NOT NECESSARILY MATCH WHAT IS ON BUILDING OR REAL ESTATE RECORDS. *** IT'S THE RESPONSIBILITY OF THE PROJECT DESIGN PROFESSIONAL TO DETERMINE THE PROPER BREAKDOWN OF SPACES SIZES AS REQUIRED PER LOCAL REGULATIONS, BUILDING AND PLANNING CODES AND PROVIDE COMPLIANCE DOCUMENTATION AS REQUIRED. **** WE RECOMMEND TO ALL OUR CUSTOMERS TO GET A LAND SURVEY OF THEIR PROPERTY WHICH PROVIDES ANOTHER LEVEL OF ACCURACY, SIZING INFORMATION FOR THE PROPERTY, BOUNDARIES, AND AS IS OFTEN REQUIRED BY CITY BUILDING & PLANNING DEPARTMENTS FOR PLAN CHECK REVIEWS.		CHECKED BY:	N.D.B.
		DATE:	11/01/2025
		PROJECT ID	4578
		SHEET SIZE	48" X 36"
		DELIVERABLES	2D CAD & PDF
SCOPE OF WORK			
		As Built Set	
AREA CALCULATIONS			
RG100	1183 SF		
RG101	362 SF		
RG102	383 SF		
RG103	382 SF		
RG104	383 SF		
RG105	375 SF		
RG106	362 SF		
RG107	398 SF		
RG108	382 SF		
RG109	403 SF		
RG110	895 SF		
RG111	3129 SF		
RG112	1408 SF		
RG113	404 SF		
RG114	488 SF		
RG115	104 SF		
RG116	104 SF		
RG117	300 SF		
RG118	296 SF		
RG119	999 SF		
Existing Auditorium Basement - Interior	2573 SF		
Existing Classroom Bldg. - Exterior	6586 SF		
Existing Auditorium 1ST FLR - Exterior	7311 SF		
Existing Auditorium 2ND FLR - Exterior	7311 SF		
PROJECT ADDRESS:			
		3700 Coldwater Canyon Ave. Los Angeles, CA 91604	
SHEET TITLE:			
		Rugby Building Floor Plans	
SCALE:		AS NOTED	
SHEET NUMBER:		AB-106	

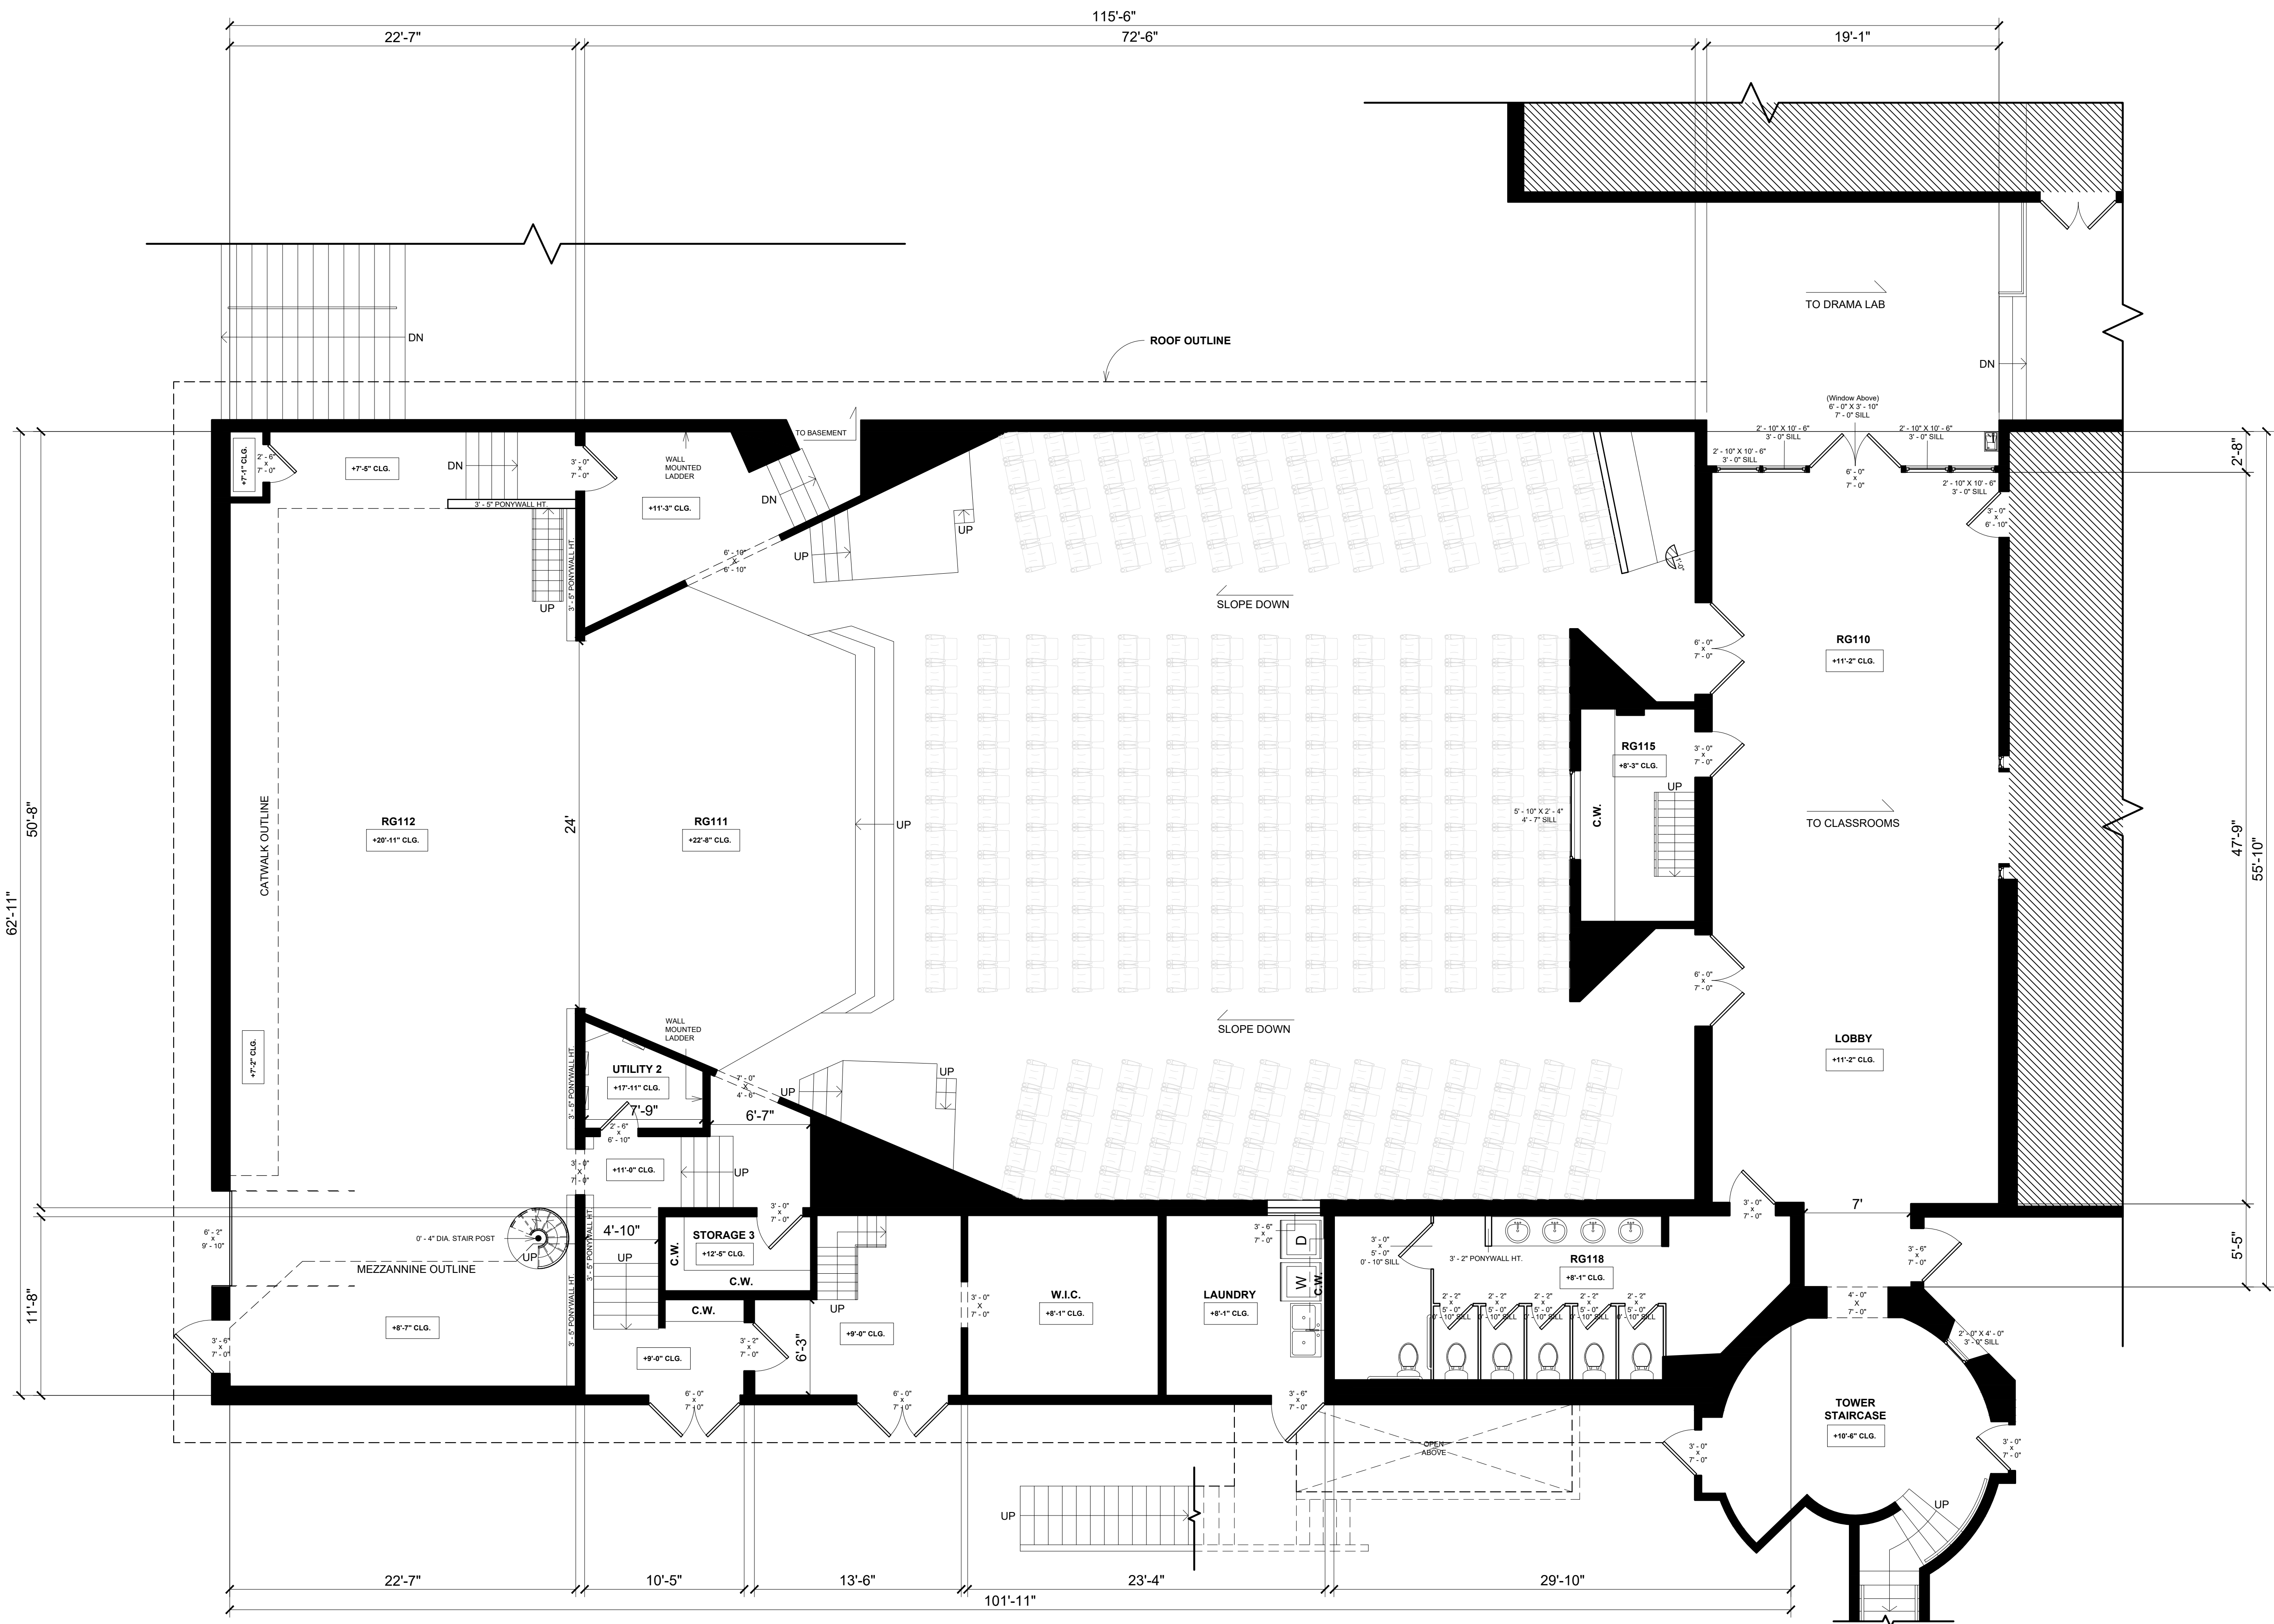

1 RUGBY BUILDING (AUDITORIUM) - EXISTING 1ST FLOOR PLAN
3/16" = 1'-0"

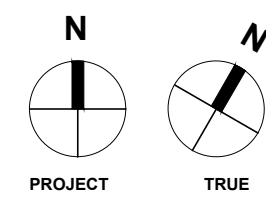

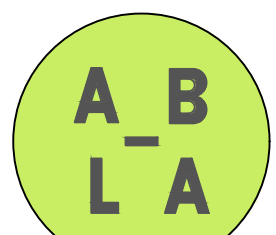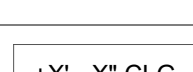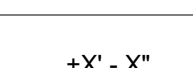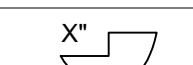
FLOOR PLAN LEGEND		HARVARD WESTLAKE SCHOOL  AS BUILT LA 21255 BURBANK BLVD, STE 120 WOODLAND HILLS, CA 91367 WWW.ASBUILT.LA.COM INFO@ASBUILT.LA.COM (818)-208-3616	
	WINDOW WIDTH X HEIGHT - SILL HEIGHT		
C.W.	CASEWORK / CABINETRY / BUILT-INS		
C.T.	COUNTERTOP / ISLAND		
F.P.	FIREPLACE		
T.O.	TOP OF		
B.O.	BOTTOM OF		
	CEILING AT HIGHEST POINT		
	LEVEL CHANGE		
	STEP DIRECTION & HEIGHT		
NOTES REGARDING AREA SIZING		DRAWN BY:	E.P.
* AREA MEASUREMENTS ARE BASED ON TOTAL SQUARE FOOTAGE MEASURED FROM THE INTERIOR SIDE OF THE WALLS IN ADDITION TO THE EXTERIOR SIDE OF WALLS. ** AREA CALCULATIONS ARE COMPLIMENTARY AND WILL NOT NECESSARILY MATCH WHAT IS ON BUILDING OR REAL ESTATE RECORDS. *** IT'S THE RESPONSIBILITY OF THE PROJECT DESIGN PROFESSIONAL TO DETERMINE THE PROPER BREAKDOWN OF SPACES SIZES AS REQUIRED PER LOCAL REGULATIONS, BUILDING AND PLANNING CODES AND PROVIDE COMPLIANCE DOCUMENTATION AS REQUIRED. **** WE RECOMMEND TO ALL OUR CUSTOMERS TO GET A LAND SURVEY OF THEIR PROPERTY WHICH PROVIDES ANOTHER LEVEL OF ACCURACY, SIZING INFORMATION FOR THE PROPERTY, BOUNDARIES, AND AS IS OFTEN REQUIRED BY CITY BUILDING & PLANNING DEPARTMENTS FOR PLAN CHECK REVIEWS.		CHECKED BY:	N.D.B.
		DATE:	11/01/2025
		PROJECT ID	4578
		SHEET SIZE	48" X 36"
		DELIVERABLES	2D CAD & PDF
		SCOPE OF WORK	
		As Built Set	
		AREA CALCULATIONS	
		RG100	1183 SF
		RG101	382 SF
RG102	383 SF		
RG103	382 SF		
RG104	383 SF		
RG105	375 SF		
RG106	382 SF		
RG107	398 SF		
RG108	382 SF		
RG109	403 SF		
RG110	895 SF		
RG111	3129 SF		
RG112	1408 SF		
RG113	404 SF		
RG114	488 SF		
RG115	104 SF		
RG116	104 SF		
RG117	300 SF		
RG118	296 SF		
RG119	999 SF		
Existing Auditorium Basement - Interior	2573 SF		
Existing Classroom Bldg. - Exterior	6586 SF		
Existing Auditorium 1ST FLR - Exterior	7311 SF		
Existing Auditorium 2ND FLR - Exterior	7311 SF		
PROJECT ADDRESS:			
3700 Coldwater Canyon Ave. Los Angeles, CA 91604			
SHEET TITLE:			
Rugby Building Floor Plans			
SCALE:			
AS NOTED			
SHEET NUMBER:			
AB-107			

AREA CALCULATIONS

RG100	1183 SF
RG101	362 SF
RG102	383 SF
RG103	382 SF
RG104	383 SF
RG105	375 SF
RG106	362 SF
RG107	398 SF
RG108	382 SF
RG109	403 SF
RG110	895 SF
RG111	3129 SF
RG112	1408 SF
RG113	404 SF
RG114	488 SF
RG115	104 SF
RG116	104 SF
RG117	300 SF
RG118	236 SF
RG119	999 SF
Existing Auditorium Basement - Interior	2573 SF
Existing Classroom Bldg. - Exterior	6586 SF
Existing Auditorium 1ST FLR - Exterior	7311 SF
Existing Auditorium 2ND FLR - Exterior	7311 SF

1 RUGBY BUILDING (AUDITORIUM) - EXISTING 2ND FLOOR PLAN
3/16" = 1'-0"

2 RUGBY BUILDING (TOWER STAIRCASE) - EXISTING 3RD FLOOR PLAN
3/16" = 1'-0"

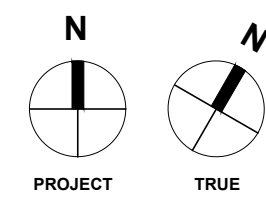

FLOOR PLAN LEGEND		HARVARD WESTLAKE SCHOOL ABLA AS BUILT LA 21255 BURBANK BLVD, STE 120 WOODLAND HILLS, CA 91367 WWW.ASBUILTLA.COM INFO@ASBUILTLA.COM (818)-208-3616	
	WINDOW WIDTH X HEIGHT - SILL HEIGHT		
C.W.	CASEWORK / CABINETRY / BUILT-INS		
C.T.	COUNTERTOP / ISLAND		
F.P.	FIREPLACE		
T.O.	TOP OF		
B.O.	BOTTOM OF		
+X' - X' CLG.	CEILING AT HIGHEST POINT	NOTES REGARDING AREA SIZING * AREA MEASUREMENTS ARE BASED ON TOTAL SQUARE FOOTAGE MEASURED FROM THE INTERIOR SIDE OF THE WALLS IN ADDITION TO THE EXTERIOR SIDE OF WALLS. ** AREA CALCULATIONS ARE COMPLEMENTARY AND WILL NOT NECESSARILY MATCH WHAT IS ON BUILDING OR REAL ESTATE RECORDS. *** IT'S THE RESPONSIBILITY OF THE PROJECT DESIGN PROFESSIONAL TO DETERMINE THE PROPER BREAKDOWN OF SPACES SIZES AS REQUIRED PER LOCAL REGULATIONS, BUILDING AND PLANNING CODES AND PROVIDE COMPLIANCE DOCUMENTATION AS REQUIRED. **** WE RECOMMEND TO ALL OUR CUSTOMERS TO GET A LAND SURVEY OF THEIR PROPERTY WHICH PROVIDES ANOTHER LEVEL OF ACCURACY, SIZING INFORMATION FOR THE PROPERTY, BOUNDARIES, AND AS IS OFTEN REQUIRED BY CITY BUILDING & PLANNING DEPARTMENTS FOR PLAN CHECK REVIEWS.	
+X' - X'	LEVEL CHANGE		
X'	STEP DIRECTION & HEIGHT		
		DRAWN BY:	E.P.
		CHECKED BY:	N.D.B.
		DATE:	11/01/2025
		PROJECT ID	4578
		SHEET SIZE	48" X 36"
		DELIVERABLES	2D CAD & PDF
		SCOPE OF WORK	
		As Built Set	
		AREA CALCULATIONS	
		RG100	1183 SF
		RG101	362 SF
		RG102	383 SF
		RG103	382 SF
		RG104	383 SF
		RG105	375 SF
		RG106	362 SF
		RG107	398 SF
		RG108	382 SF
		RG109	403 SF
		RG110	895 SF
		RG111	3129 SF
		RG112	1408 SF
		RG113	404 SF
		RG114	488 SF
		RG115	104 SF
		RG116	104 SF
		RG117	300 SF
		RG118	236 SF
		RG119	999 SF
		Existing Auditorium Basement - Interior	2573 SF
		Existing Classroom Bldg. - Exterior	6586 SF
		Existing Auditorium 1ST FLR - Exterior	7311 SF
		Existing Auditorium 2ND FLR - Exterior	7311 SF
		PROJECT ADDRESS:	
		3700 Coldwater Canyon Ave. Los Angeles, CA 91604	
		SHEET TITLE:	
		Rugby Building Floor Plans	
		SCALE:	AS NOTED
		SHEET NUMBER:	AB-108