


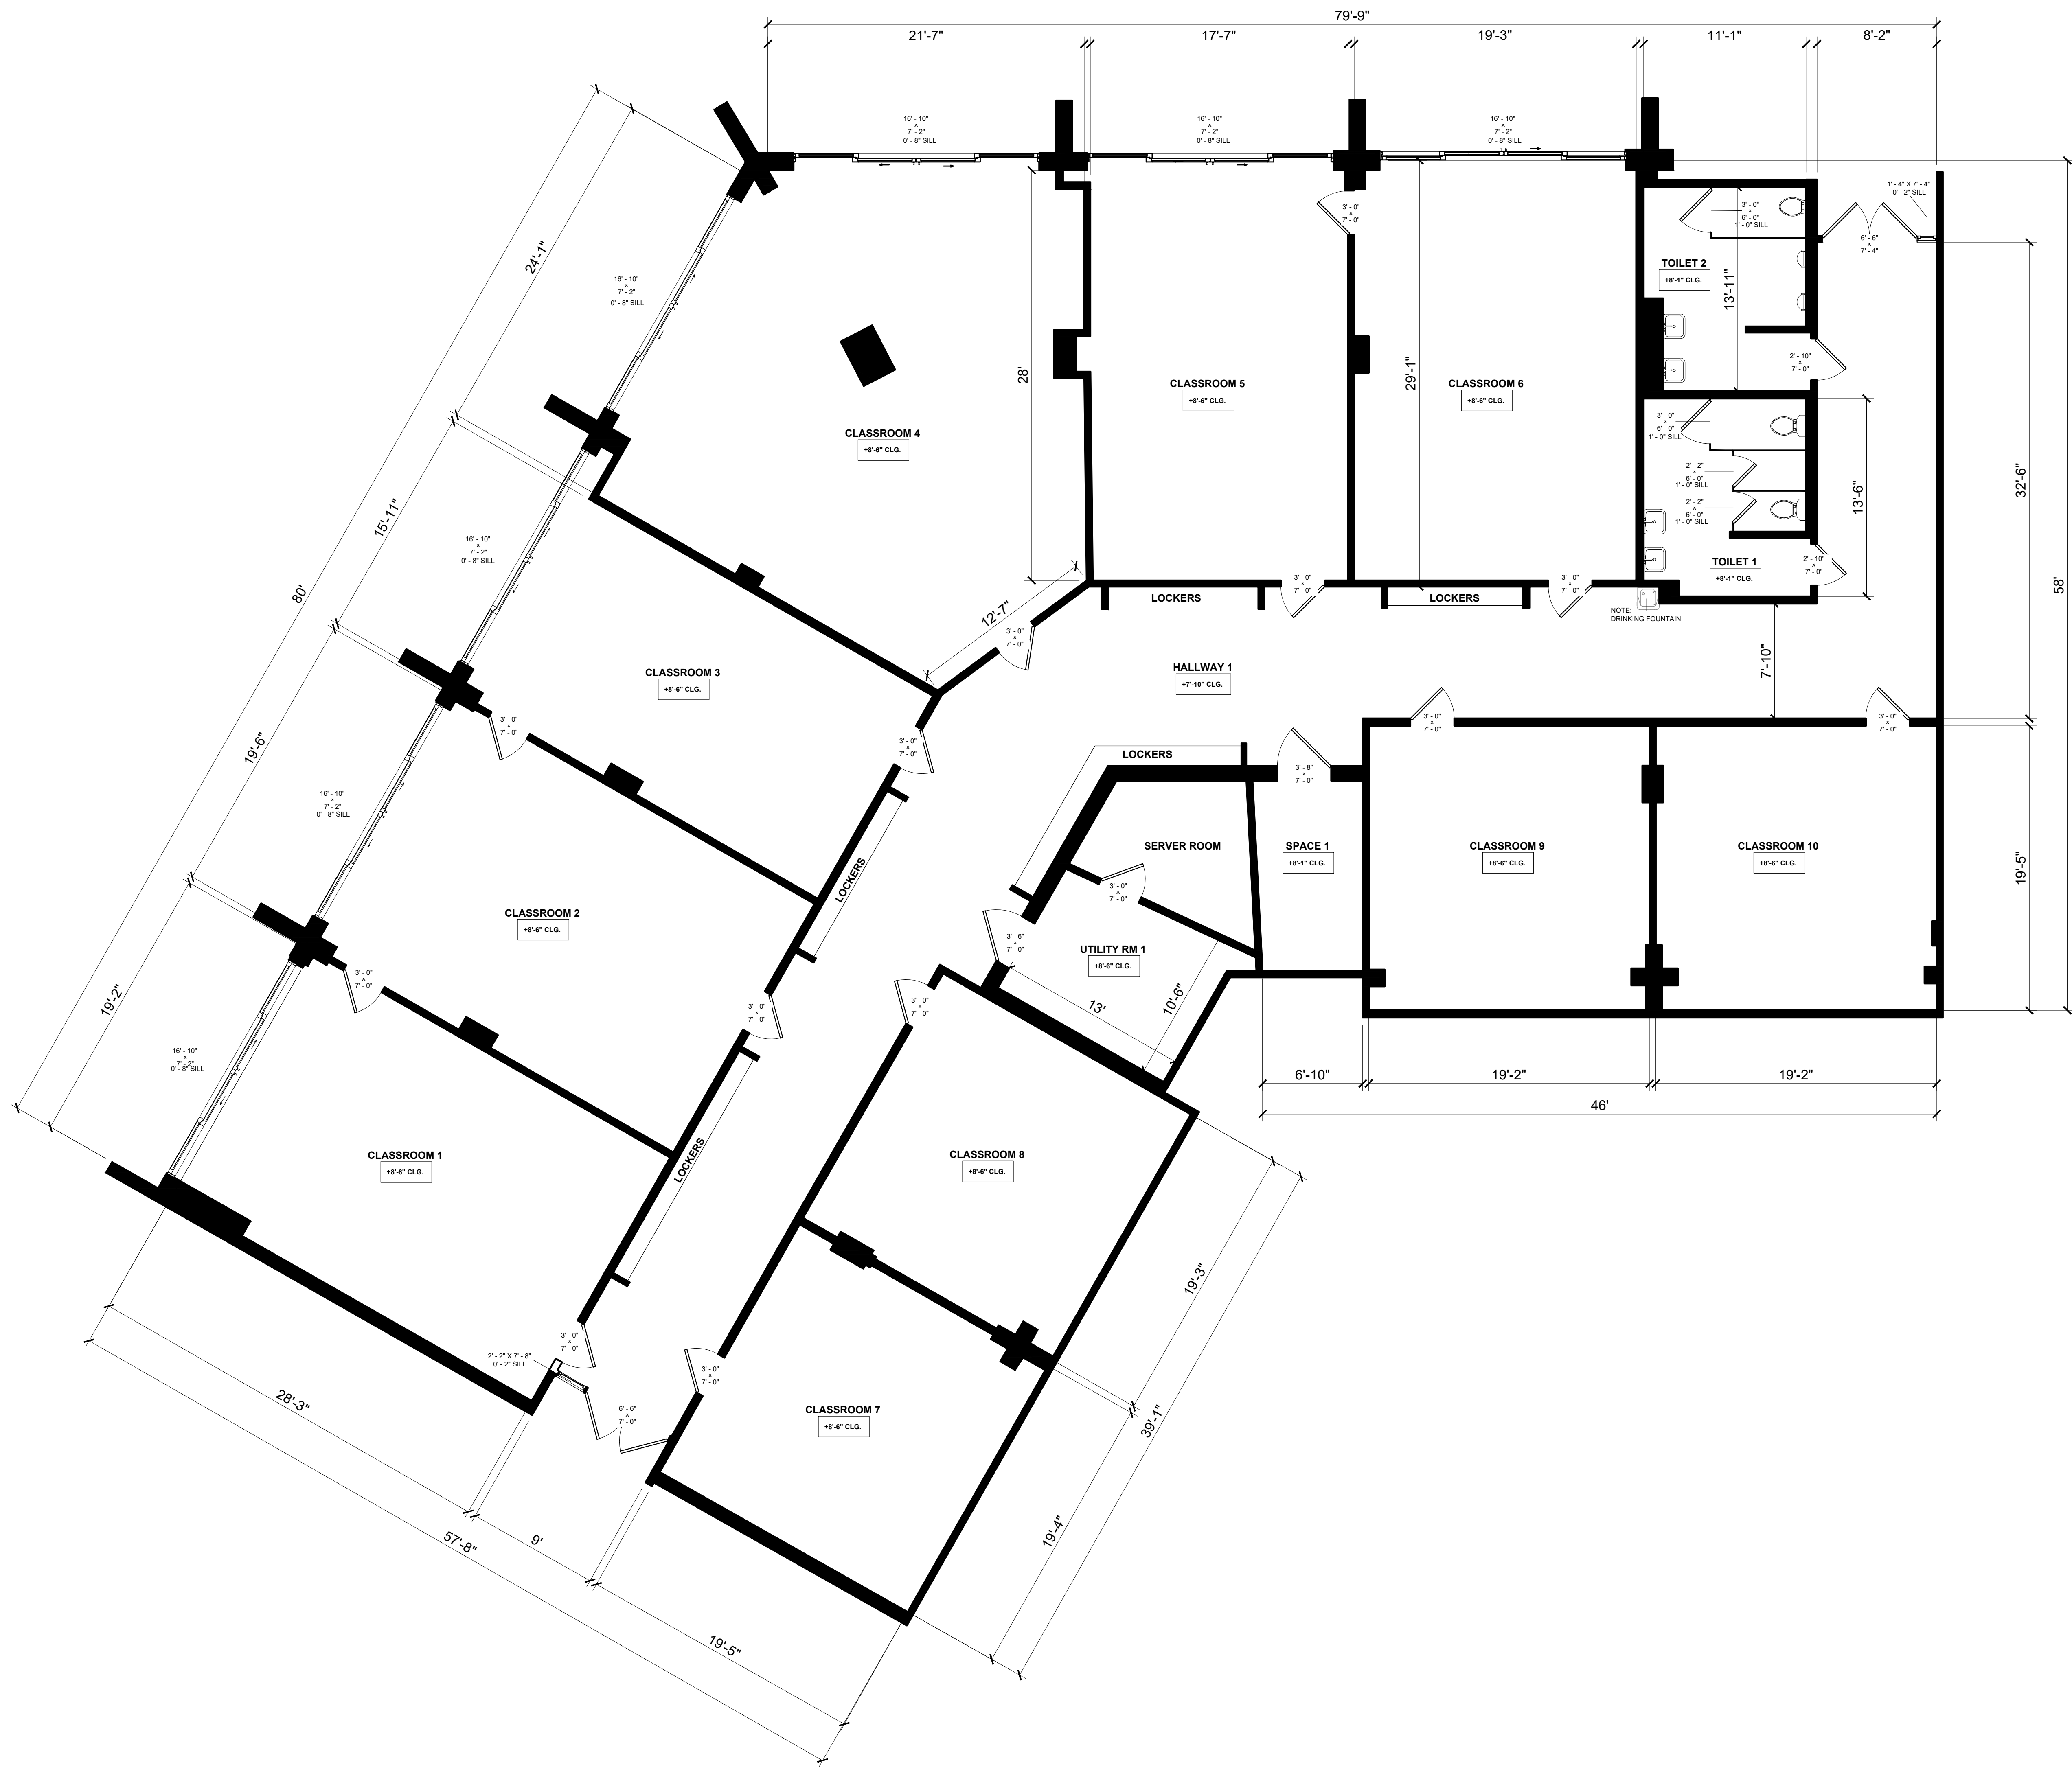

1 WORLD LANGUAGE CENTER - EXISTING FLOOR PLAN
3/16" = 1'-0"

FLOOR PLAN LEGEND	
	WINDOW WIDTH X HEIGHT - SILL HEIGHT
C.W.	CASEWORK / CABINETRY / BUILT-INS
C.T.	COUNTERTOP / ISLAND
F.P.	FIREPLACE
T.O.	TOP OF
B.O.	BOTTOM OF
+X' - X' CLG.	CEILING AT HIGHEST POINT
+X' - X'	LEVEL CHANGE
X'	STEP DIRECTION & HEIGHT

HARVARD
WESTLAKE
SCHOOL


A
B
L
A

AS BUILT LA
21255 BURBANK BLVD, STE 120
WOODLAND HILLS, CA 91367
WWW.ASBUILT.LA.COM
INFO@ASBUILT.LA.COM
(818)-208-3616

NOTES REGARDING AREA SIZING		DRAWN BY:	M.M.M
* AREA MEASUREMENTS ARE BASED ON TOTAL SQUARE FOOTAGE MEASURED FROM THE INTERIOR SIDE OF THE WALLS IN ADDITION TO THE EXTERIOR SIDE OF WALLS.		CHECKED BY:	F.P.S.
** AREA CALCULATIONS ARE COMPLIMENTARY AND WILL NOT NECESSARILY MATCH WHAT IS ON BUILDING OR REAL ESTATE RECORDS.		DATE:	11/01/2025
*** IT'S THE RESPONSIBILITY OF THE PROJECT DESIGN PROFESSIONAL TO DETERMINE THE PROPER BREAKDOWN OF SPACES SIZES AS REQUIRED PER LOCAL REGULATIONS, BUILDING AND PLANNING CODES AND PROVIDE COMPLIANCE DOCUMENTATION AS REQUIRED.		PROJECT ID	4578
**** WE RECOMMEND TO ALL OUR CUSTOMERS TO GET A LAND SURVEY OF THEIR PROPERTY WHICH PROVIDES ANOTHER LEVEL OF ACCURACY, SIZING INFORMATION FOR THE PROPERTY, BOUNDARIES, AND AS IS OFTEN REQUIRED BY CITY BUILDING & PLANNING DEPARTMENTS FOR PLAN CHECK REVIEWS.		SHEET SIZE	48" X 36"
SCOPE OF WORK			
As Built Set			

AREA CALCULATIONS	
Existing Classroom 1 - Interior 1ST FL	550 SF
Existing Classroom 2 - Interior 1ST FL	561 SF
Existing Classroom 3 - Interior 1ST FL	461 SF
Existing Classroom 4 - Interior 1ST FL	889 SF
Existing Classroom 5 - Interior 1ST FL	505 SF
Existing Classroom 6 - Interior 1ST FL	552 SF
Existing Classroom 7 - Interior 1ST FL	377 SF
Existing Classroom 8 - Interior 1ST FL	374 SF
Existing Classroom 9 - Interior 1ST FL	372 SF
Existing Classroom 10 - Interior 1ST FL	372 SF
Existing Toilet RM 1 - Interior 1ST FL	152 SF
Existing Toilet RM 2 - Interior 1ST FL	147 SF
Existing Hallway 1 - Interior 1ST FL	1355 SF
Existing Building - Interior - World Language Center	7280 SF
Existing Building - Interior - Music Library 1ST FL	8157 SF
Existing Building - Interior - Music Library 2ND FL	6982 SF
Existing Building - Interior - Beaver	8250 SF

PROJECT ADDRESS:	
3700 Coldwater Canyon Ave. Los Angeles, CA 91604	
SHEET TITLE:	
World Language Center Floor Plans	
SCALE:	
AS NOTED	
SHEET NUMBER:	
AB-113	

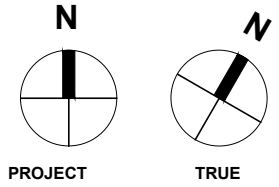



	PROJECT ADDRESS:	
	3700 Coldwater Canyon Ave. Los Angeles, CA 91604	
	SHEET TITLE:	
	Seaver Building Floor Plans	
	SCALE:	AS NOTED
	SHEET NUMBER:	AB-116

AS BUILT LA
21255 BURBANK BLVD, STE 120
WOODLAND HILLS, CA 91367
WWW.ASBUILT.LA.COM
INFO@ASBUILT.LA.COM
(818)-208-3616

[illegible]As Built Set

3700 Coldwater Canyon
Ave. Los Angeles, CA 91604

SHEET NUMBER: AB-116

