



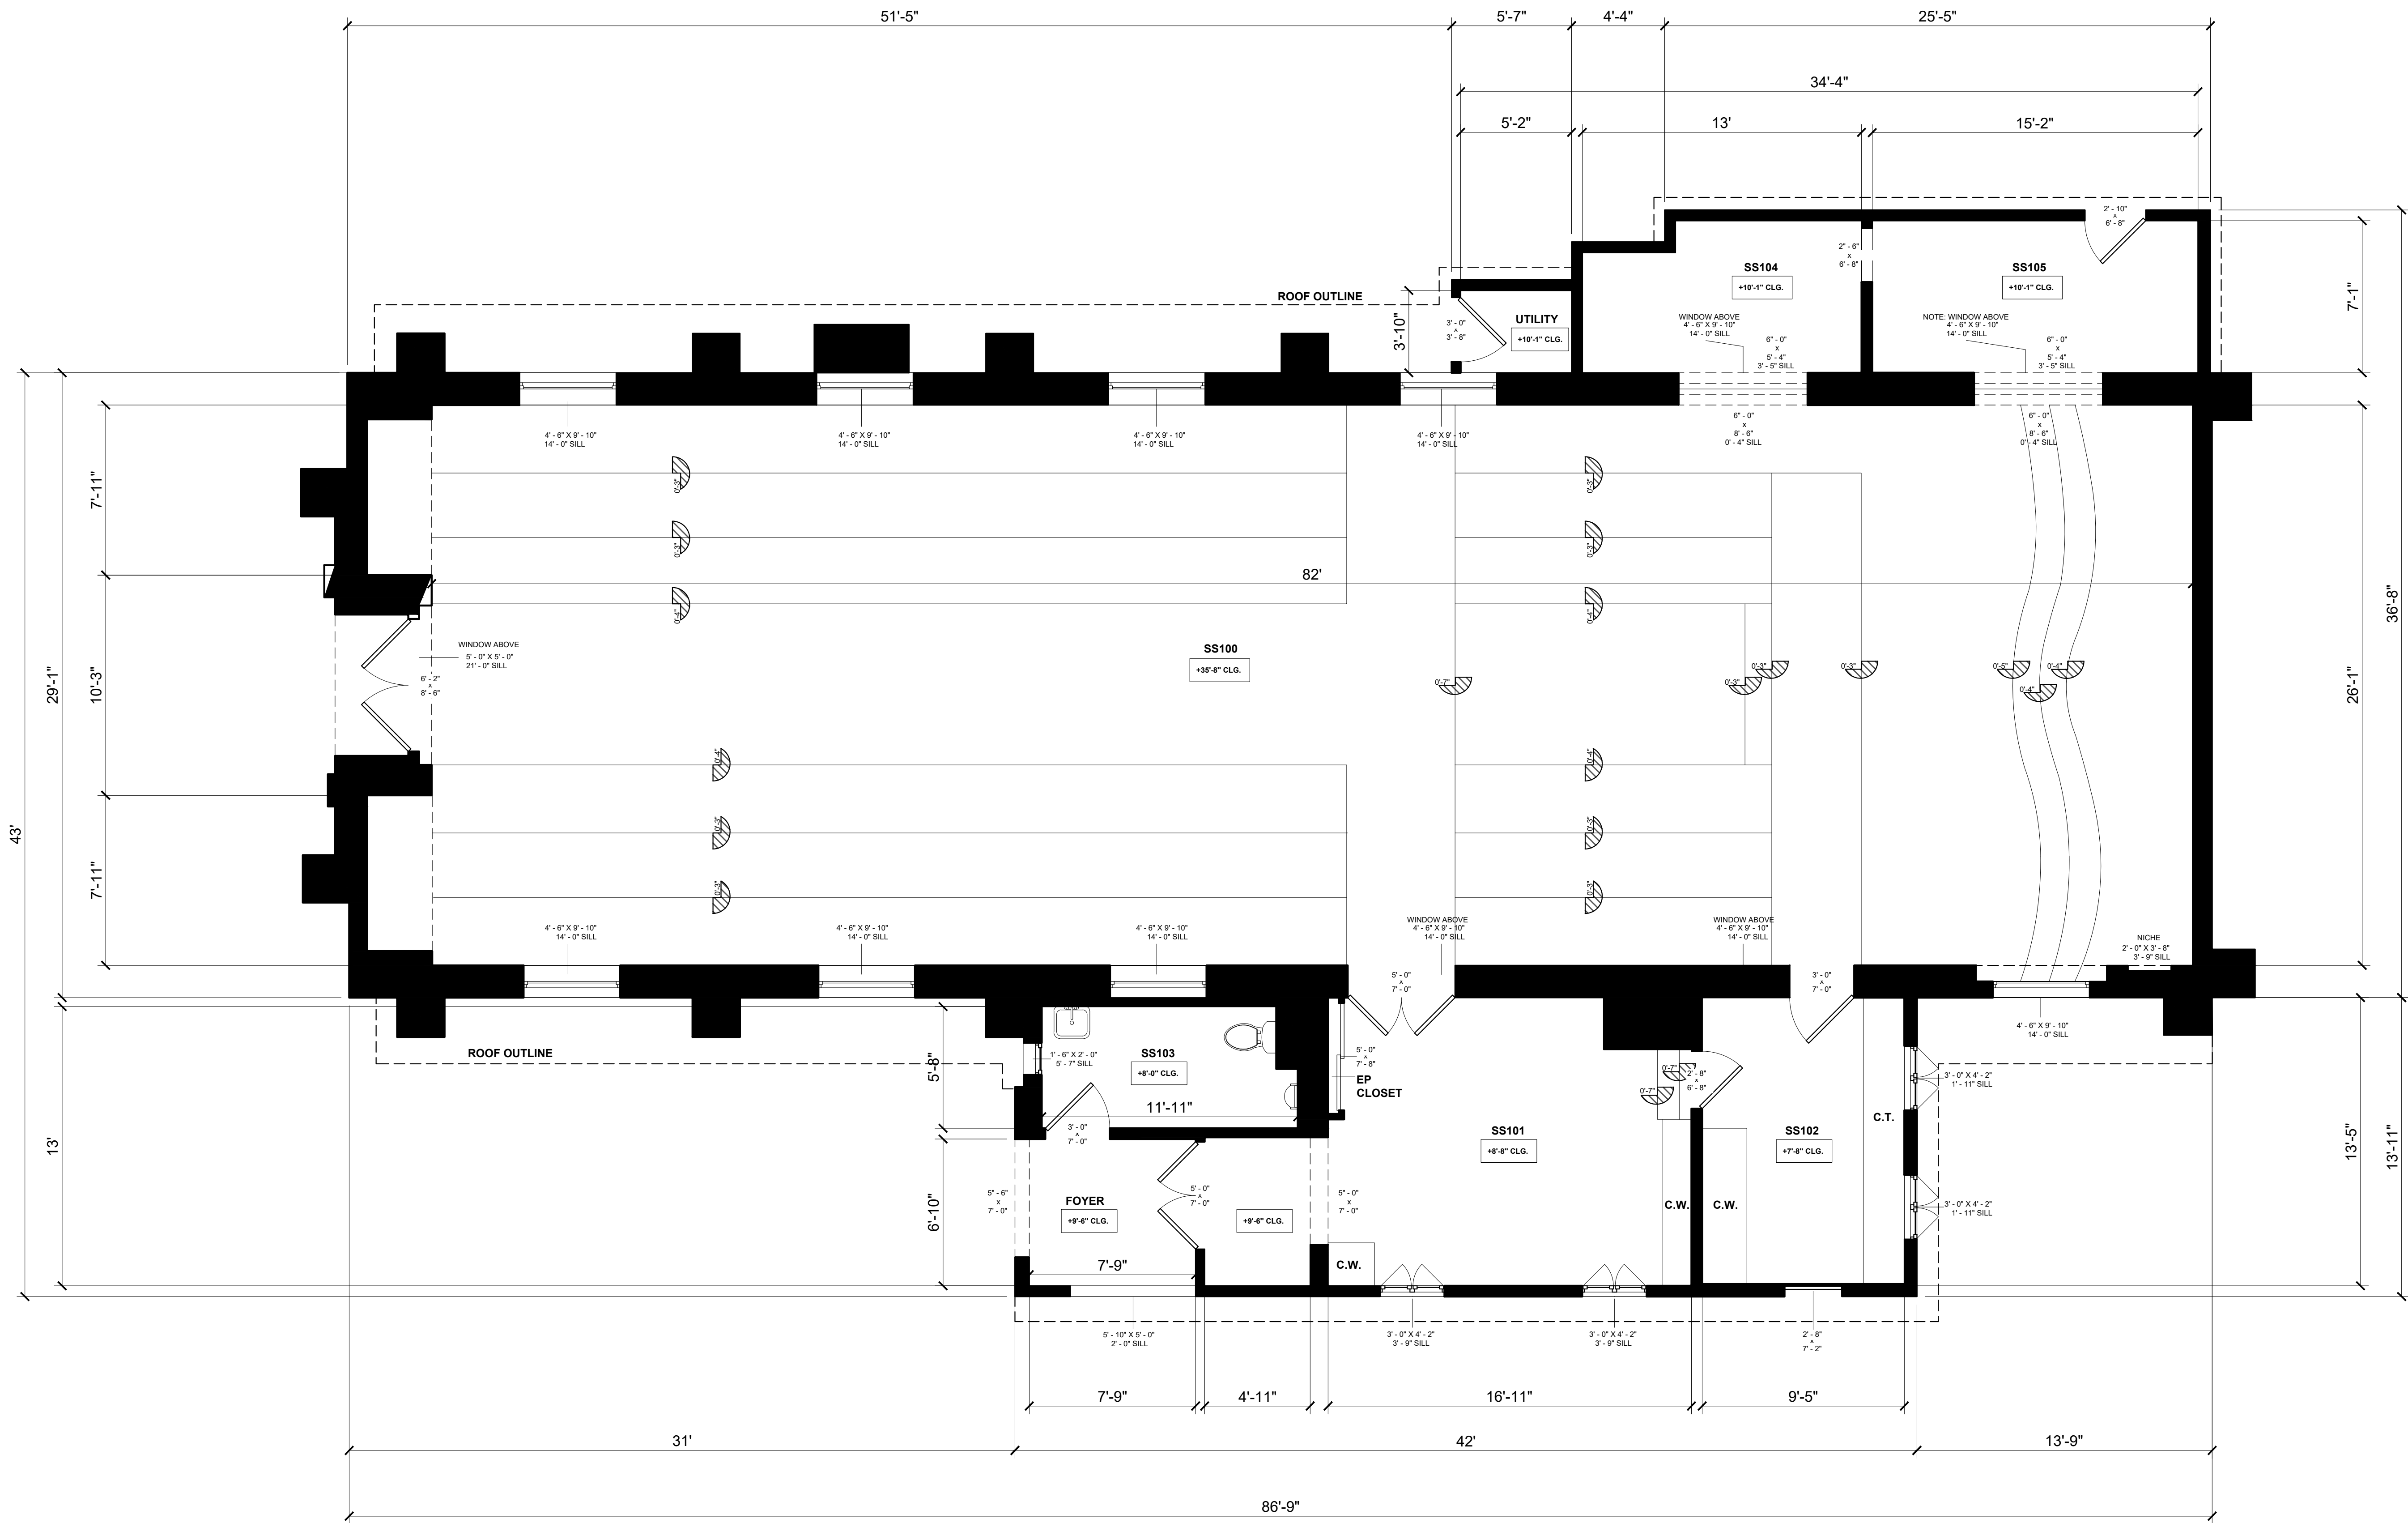

① St. Saviors Chapel - Floor Plan
1/4" = 1'-0"

FLOOR PLAN LEGEND	
	WINDOW WIDTH X HEIGHT - SILL HEIGHT
C.W.	CASEWORK / CABINETRY / BUILT-INS
C.T.	COUNTERTOP / ISLAND
F.P.	FIREPLACE
T.O.	TOP OF
B.O.	BOTTOM OF
+X" - X" CLG.	CEILING AT HIGHEST POINT
+X" - X"	LEVEL CHANGE
X"	STEP DIRECTION & HEIGHT

HARVARD WESTLAKE SCHOOL

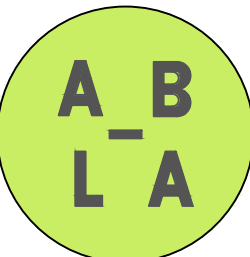

AS BUILT LA
21255 BURBANK BLVD, STE 120
WOODLAND HILLS, CA 91367
WWW.ASBUILT.LA.COM
INFO@ASBUILT.LA.COM
(818)-208-3616

NOTES REGARDING AREA SIZING	DRAWN BY:	M.M.
	CHECKED BY:	N.D.B.
	DATE:	11/01/2025
	PROJECT ID	4578
	SHEET SIZE	48" X 36"
* AREA MEASUREMENTS ARE BASED ON TOTAL SQUARE FOOTAGE MEASURED FROM THE INTERIOR SIDE OF THE WALLS IN ADDITION TO THE EXTERIOR SIDE OF WALLS.	DELIVERABLES	2D CAD & PDF
** AREA CALCULATIONS ARE COMPLIMENTARY AND WILL NOT NECESSARILY MATCH WHAT IS ON BUILDING OR REAL ESTATE RECORDS.	SCOPE OF WORK	
	As Built Set	
*** IT'S THE RESPONSIBILITY OF THE PROJECT DESIGN PROFESSIONAL TO DETERMINE THE PROPER BREAKDOWN OF SPACES SIZES AS REQUIRED PER LOCAL REGULATIONS, BUILDING AND PLANNING CODES AND PROVIDE COMPLIANCE DOCUMENTATION AS REQUIRED.		
**** WE RECOMMEND TO ALL OUR CUSTOMERS TO GET A LAND SURVEY OF THEIR PROPERTY WHICH PROVIDES ANOTHER LEVEL OF ACCURACY, SIZING INFORMATION FOR THE PROPERTY, BOUNDARIES, AND AS IS OFTEN REQUIRED BY CITY BUILDING & PLANNING DEPARTMENTS FOR PLAN CHECK REVIEWS.		

AREA CALCULATIONS	
SS100	2196 SF
SS101	257 SF
SS102	126 SF
SS103	65 SF
SS104	86 SF
SS105	107 SF
Existing Chapel - Exterior	3398 SF

PROJECT ADDRESS:	
3700 Coldwater Canyon Ave, Studio City, CA 91604	
SHEET TITLE:	
St. Saviors Chapel Floor Plan	
SCALE:	AS NOTED
SHEET NUMBER:	AB-125