




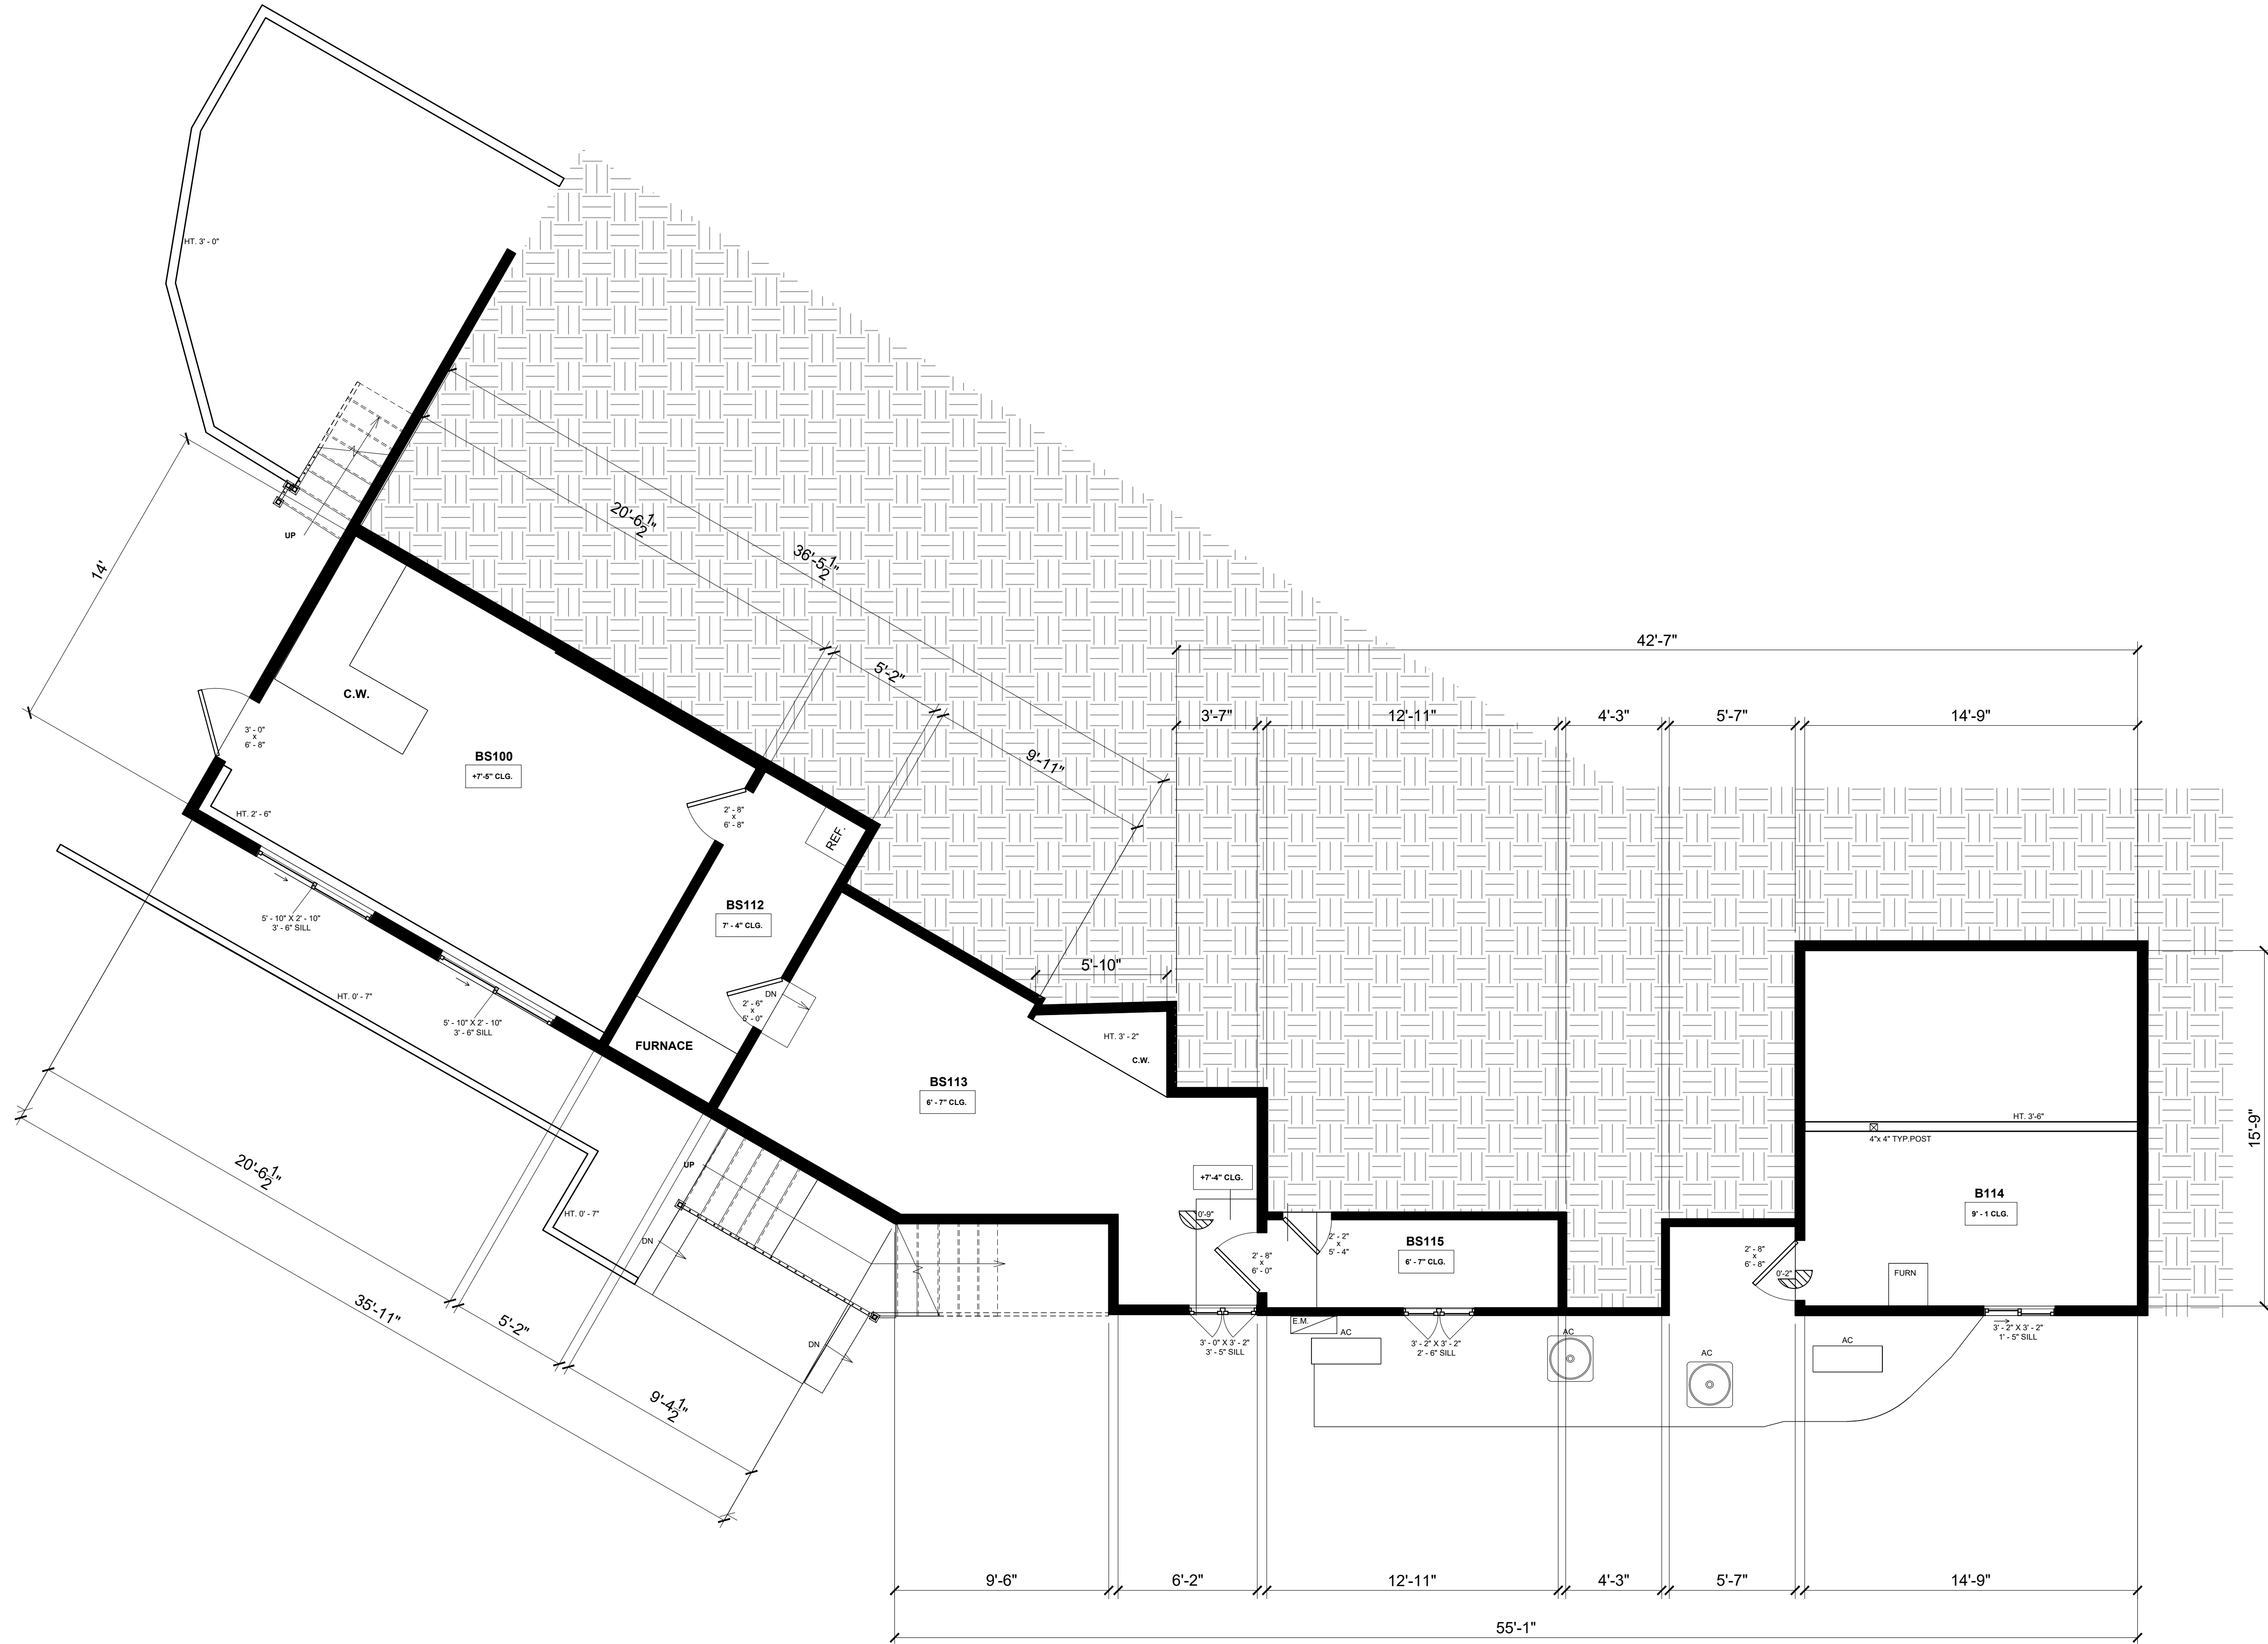


1 ALVAREZ BUSINESS OFFICE - EXISTING GROUND FLOOR PLAN  
1/4" = 1'-0"

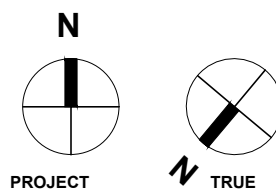

| FLOOR PLAN LEGEND                                                                                                                                                                                                                                                                                                                                                                                                                                                                                                                                                                                                                                                                                                                                                                        |                                     | <div>HARVARD<br/>WESTLAKE<br/>SCHOOL</div> <div><div>ABLA</div></div> <div>AS BUILT LA<br/>21255 BURBANK BLVD, STE 120<br/>WOODLAND HILLS, CA 91367<br/>WWW.ASBUILT.LA.COM<br/>INFO@ASBUILT.LA.COM<br/>(818)-208-3616</div> |
|------------------------------------------------------------------------------------------------------------------------------------------------------------------------------------------------------------------------------------------------------------------------------------------------------------------------------------------------------------------------------------------------------------------------------------------------------------------------------------------------------------------------------------------------------------------------------------------------------------------------------------------------------------------------------------------------------------------------------------------------------------------------------------------|-------------------------------------|-----------------------------------------------------------------------------------------------------------------------------------------------------------------------------------------------------------------------------|
|                                                                                                                                                                                                                                                                                                                                                                                                                                                                                                                                                                                                                                                                                                                                                                                          | WINDOW WIDTH X HEIGHT - SILL HEIGHT |                                                                                                                                                                                                                             |
| C.W.                                                                                                                                                                                                                                                                                                                                                                                                                                                                                                                                                                                                                                                                                                                                                                                     | CASEWORK / CABINETRY / BUILT-INS    |                                                                                                                                                                                                                             |
| C.T.                                                                                                                                                                                                                                                                                                                                                                                                                                                                                                                                                                                                                                                                                                                                                                                     | COUNTERTOP / ISLAND                 |                                                                                                                                                                                                                             |
| F.P.                                                                                                                                                                                                                                                                                                                                                                                                                                                                                                                                                                                                                                                                                                                                                                                     | FIREPLACE                           |                                                                                                                                                                                                                             |
| T.O.                                                                                                                                                                                                                                                                                                                                                                                                                                                                                                                                                                                                                                                                                                                                                                                     | TOP OF                              |                                                                                                                                                                                                                             |
| B.O.                                                                                                                                                                                                                                                                                                                                                                                                                                                                                                                                                                                                                                                                                                                                                                                     | BOTTOM OF                           |                                                                                                                                                                                                                             |
| +X" - X" CLG.                                                                                                                                                                                                                                                                                                                                                                                                                                                                                                                                                                                                                                                                                                                                                                            | CEILING AT HIGHEST POINT            |                                                                                                                                                                                                                             |
| +X" - X"                                                                                                                                                                                                                                                                                                                                                                                                                                                                                                                                                                                                                                                                                                                                                                                 | LEVEL CHANGE                        |                                                                                                                                                                                                                             |
| X"                                                                                                                                                                                                                                                                                                                                                                                                                                                                                                                                                                                                                                                                                                                                                                                       | STEP DIRECTION & HEIGHT             |                                                                                                                                                                                                                             |
| NOTES REGARDING AREA SIZING                                                                                                                                                                                                                                                                                                                                                                                                                                                                                                                                                                                                                                                                                                                                                              |                                     | DRAWN BY: PG                                                                                                                                                                                                                |
| * AREA MEASUREMENTS ARE BASED ON TOTAL SQUARE FOOTAGE MEASURED FROM THE INTERIOR SIDE OF THE WALLS IN ADDITION TO THE EXTERIOR SIDE OF WALLS.<br><br>** AREA CALCULATIONS ARE COMPLIMENTARY AND WILL NOT NECESSARILY MATCH WHAT IS ON BUILDING OR REAL ESTATE RECORDS.<br><br>*** IT'S THE RESPONSIBILITY OF THE PROJECT DESIGN PROFESSIONAL TO DETERMINE THE PROPER BREAKDOWN OF SPACES SIZES AS REQUIRED PER LOCAL REGULATIONS, BUILDING AND PLANNING CODES AND PROVIDE COMPLIANCE DOCUMENTATION AS REQUIRED.<br><br>**** WE RECOMMEND TO ALL OUR CUSTOMERS TO GET A LAND SURVEY OF THEIR PROPERTY WHICH PROVIDES ANOTHER LEVEL OF ACCURACY, SIZING INFORMATION FOR THE PROPERTY, BOUNDARIES, AND AS IS OFTEN REQUIRED BY CITY BUILDING & PLANNING DEPARTMENTS FOR PLAN CHECK REVIEWS. |                                     | CHECKED BY: F.P.S.                                                                                                                                                                                                          |
|                                                                                                                                                                                                                                                                                                                                                                                                                                                                                                                                                                                                                                                                                                                                                                                          |                                     | DATE: 11/01/2025                                                                                                                                                                                                            |
|                                                                                                                                                                                                                                                                                                                                                                                                                                                                                                                                                                                                                                                                                                                                                                                          |                                     | PROJECT ID: 4578                                                                                                                                                                                                            |
|                                                                                                                                                                                                                                                                                                                                                                                                                                                                                                                                                                                                                                                                                                                                                                                          |                                     | SHEET SIZE: 48" X 36"                                                                                                                                                                                                       |
|                                                                                                                                                                                                                                                                                                                                                                                                                                                                                                                                                                                                                                                                                                                                                                                          |                                     | 2D CAD & PDF                                                                                                                                                                                                                |
| SCOPE OF WORK                                                                                                                                                                                                                                                                                                                                                                                                                                                                                                                                                                                                                                                                                                                                                                            |                                     | As Built Set                                                                                                                                                                                                                |
| AREA CALCULATIONS                                                                                                                                                                                                                                                                                                                                                                                                                                                                                                                                                                                                                                                                                                                                                                        |                                     |                                                                                                                                                                                                                             |
| Existing Business Center - 1st FL Interior                                                                                                                                                                                                                                                                                                                                                                                                                                                                                                                                                                                                                                                                                                                                               |                                     | 653 SF                                                                                                                                                                                                                      |
| Existing Business Center - 1st FL Exterior                                                                                                                                                                                                                                                                                                                                                                                                                                                                                                                                                                                                                                                                                                                                               |                                     | 726.1 SF                                                                                                                                                                                                                    |
| Existing Business Center - 2nd FL Exterior                                                                                                                                                                                                                                                                                                                                                                                                                                                                                                                                                                                                                                                                                                                                               |                                     | 2123 SF                                                                                                                                                                                                                     |
| Existing Business Center - 2nd FL Exterior                                                                                                                                                                                                                                                                                                                                                                                                                                                                                                                                                                                                                                                                                                                                               |                                     | 2225 SF                                                                                                                                                                                                                     |
| BS100                                                                                                                                                                                                                                                                                                                                                                                                                                                                                                                                                                                                                                                                                                                                                                                    |                                     | 277 SF                                                                                                                                                                                                                      |
| BS101                                                                                                                                                                                                                                                                                                                                                                                                                                                                                                                                                                                                                                                                                                                                                                                    |                                     | 146 SF                                                                                                                                                                                                                      |
| BS102                                                                                                                                                                                                                                                                                                                                                                                                                                                                                                                                                                                                                                                                                                                                                                                    |                                     | 136 SF                                                                                                                                                                                                                      |
| BS103                                                                                                                                                                                                                                                                                                                                                                                                                                                                                                                                                                                                                                                                                                                                                                                    |                                     | 151 SF                                                                                                                                                                                                                      |
| BS104                                                                                                                                                                                                                                                                                                                                                                                                                                                                                                                                                                                                                                                                                                                                                                                    |                                     | 185 SF                                                                                                                                                                                                                      |
| BS105                                                                                                                                                                                                                                                                                                                                                                                                                                                                                                                                                                                                                                                                                                                                                                                    |                                     | 111 SF                                                                                                                                                                                                                      |
| BS106                                                                                                                                                                                                                                                                                                                                                                                                                                                                                                                                                                                                                                                                                                                                                                                    |                                     | 83 SF                                                                                                                                                                                                                       |
| BS107                                                                                                                                                                                                                                                                                                                                                                                                                                                                                                                                                                                                                                                                                                                                                                                    |                                     | 230 SF                                                                                                                                                                                                                      |
| BS108                                                                                                                                                                                                                                                                                                                                                                                                                                                                                                                                                                                                                                                                                                                                                                                    |                                     | 89 SF                                                                                                                                                                                                                       |
| BS109                                                                                                                                                                                                                                                                                                                                                                                                                                                                                                                                                                                                                                                                                                                                                                                    |                                     | 107 SF                                                                                                                                                                                                                      |
| BS110                                                                                                                                                                                                                                                                                                                                                                                                                                                                                                                                                                                                                                                                                                                                                                                    |                                     | 89 SF                                                                                                                                                                                                                       |
| BS111                                                                                                                                                                                                                                                                                                                                                                                                                                                                                                                                                                                                                                                                                                                                                                                    |                                     | 140 SF                                                                                                                                                                                                                      |
| BS112                                                                                                                                                                                                                                                                                                                                                                                                                                                                                                                                                                                                                                                                                                                                                                                    |                                     | 72 SF                                                                                                                                                                                                                       |
| BS113                                                                                                                                                                                                                                                                                                                                                                                                                                                                                                                                                                                                                                                                                                                                                                                    |                                     | 232 SF                                                                                                                                                                                                                      |
| BS114                                                                                                                                                                                                                                                                                                                                                                                                                                                                                                                                                                                                                                                                                                                                                                                    |                                     | 232 SF                                                                                                                                                                                                                      |
| BS115                                                                                                                                                                                                                                                                                                                                                                                                                                                                                                                                                                                                                                                                                                                                                                                    |                                     | 50 SF                                                                                                                                                                                                                       |
| BS116                                                                                                                                                                                                                                                                                                                                                                                                                                                                                                                                                                                                                                                                                                                                                                                    |                                     | 92 SF                                                                                                                                                                                                                       |
| BS117                                                                                                                                                                                                                                                                                                                                                                                                                                                                                                                                                                                                                                                                                                                                                                                    |                                     | 67 SF                                                                                                                                                                                                                       |
| BS118                                                                                                                                                                                                                                                                                                                                                                                                                                                                                                                                                                                                                                                                                                                                                                                    |                                     | 88 SF                                                                                                                                                                                                                       |
| BS119                                                                                                                                                                                                                                                                                                                                                                                                                                                                                                                                                                                                                                                                                                                                                                                    |                                     | 69 SF                                                                                                                                                                                                                       |
| BS120                                                                                                                                                                                                                                                                                                                                                                                                                                                                                                                                                                                                                                                                                                                                                                                    |                                     | 34 SF                                                                                                                                                                                                                       |
| BS121                                                                                                                                                                                                                                                                                                                                                                                                                                                                                                                                                                                                                                                                                                                                                                                    |                                     | 57 SF                                                                                                                                                                                                                       |
| BS122                                                                                                                                                                                                                                                                                                                                                                                                                                                                                                                                                                                                                                                                                                                                                                                    |                                     | 44 SF                                                                                                                                                                                                                       |
| PROJECT ADDRESS:                                                                                                                                                                                                                                                                                                                                                                                                                                                                                                                                                                                                                                                                                                                                                                         |                                     |                                                                                                                                                                                                                             |
| 3700 Coldwater Canyon Ave.<br>Los Angeles, CA 91604                                                                                                                                                                                                                                                                                                                                                                                                                                                                                                                                                                                                                                                                                                                                      |                                     |                                                                                                                                                                                                                             |
| SHEET TITLE:                                                                                                                                                                                                                                                                                                                                                                                                                                                                                                                                                                                                                                                                                                                                                                             |                                     |                                                                                                                                                                                                                             |
| Alvarez Business Office<br>Floor Plans                                                                                                                                                                                                                                                                                                                                                                                                                                                                                                                                                                                                                                                                                                                                                   |                                     |                                                                                                                                                                                                                             |
| SCALE:                                                                                                                                                                                                                                                                                                                                                                                                                                                                                                                                                                                                                                                                                                                                                                                   |                                     | AS NOTED                                                                                                                                                                                                                    |
| SHEET NUMBER:                                                                                                                                                                                                                                                                                                                                                                                                                                                                                                                                                                                                                                                                                                                                                                            |                                     | AB-121                                                                                                                                                                                                                      |

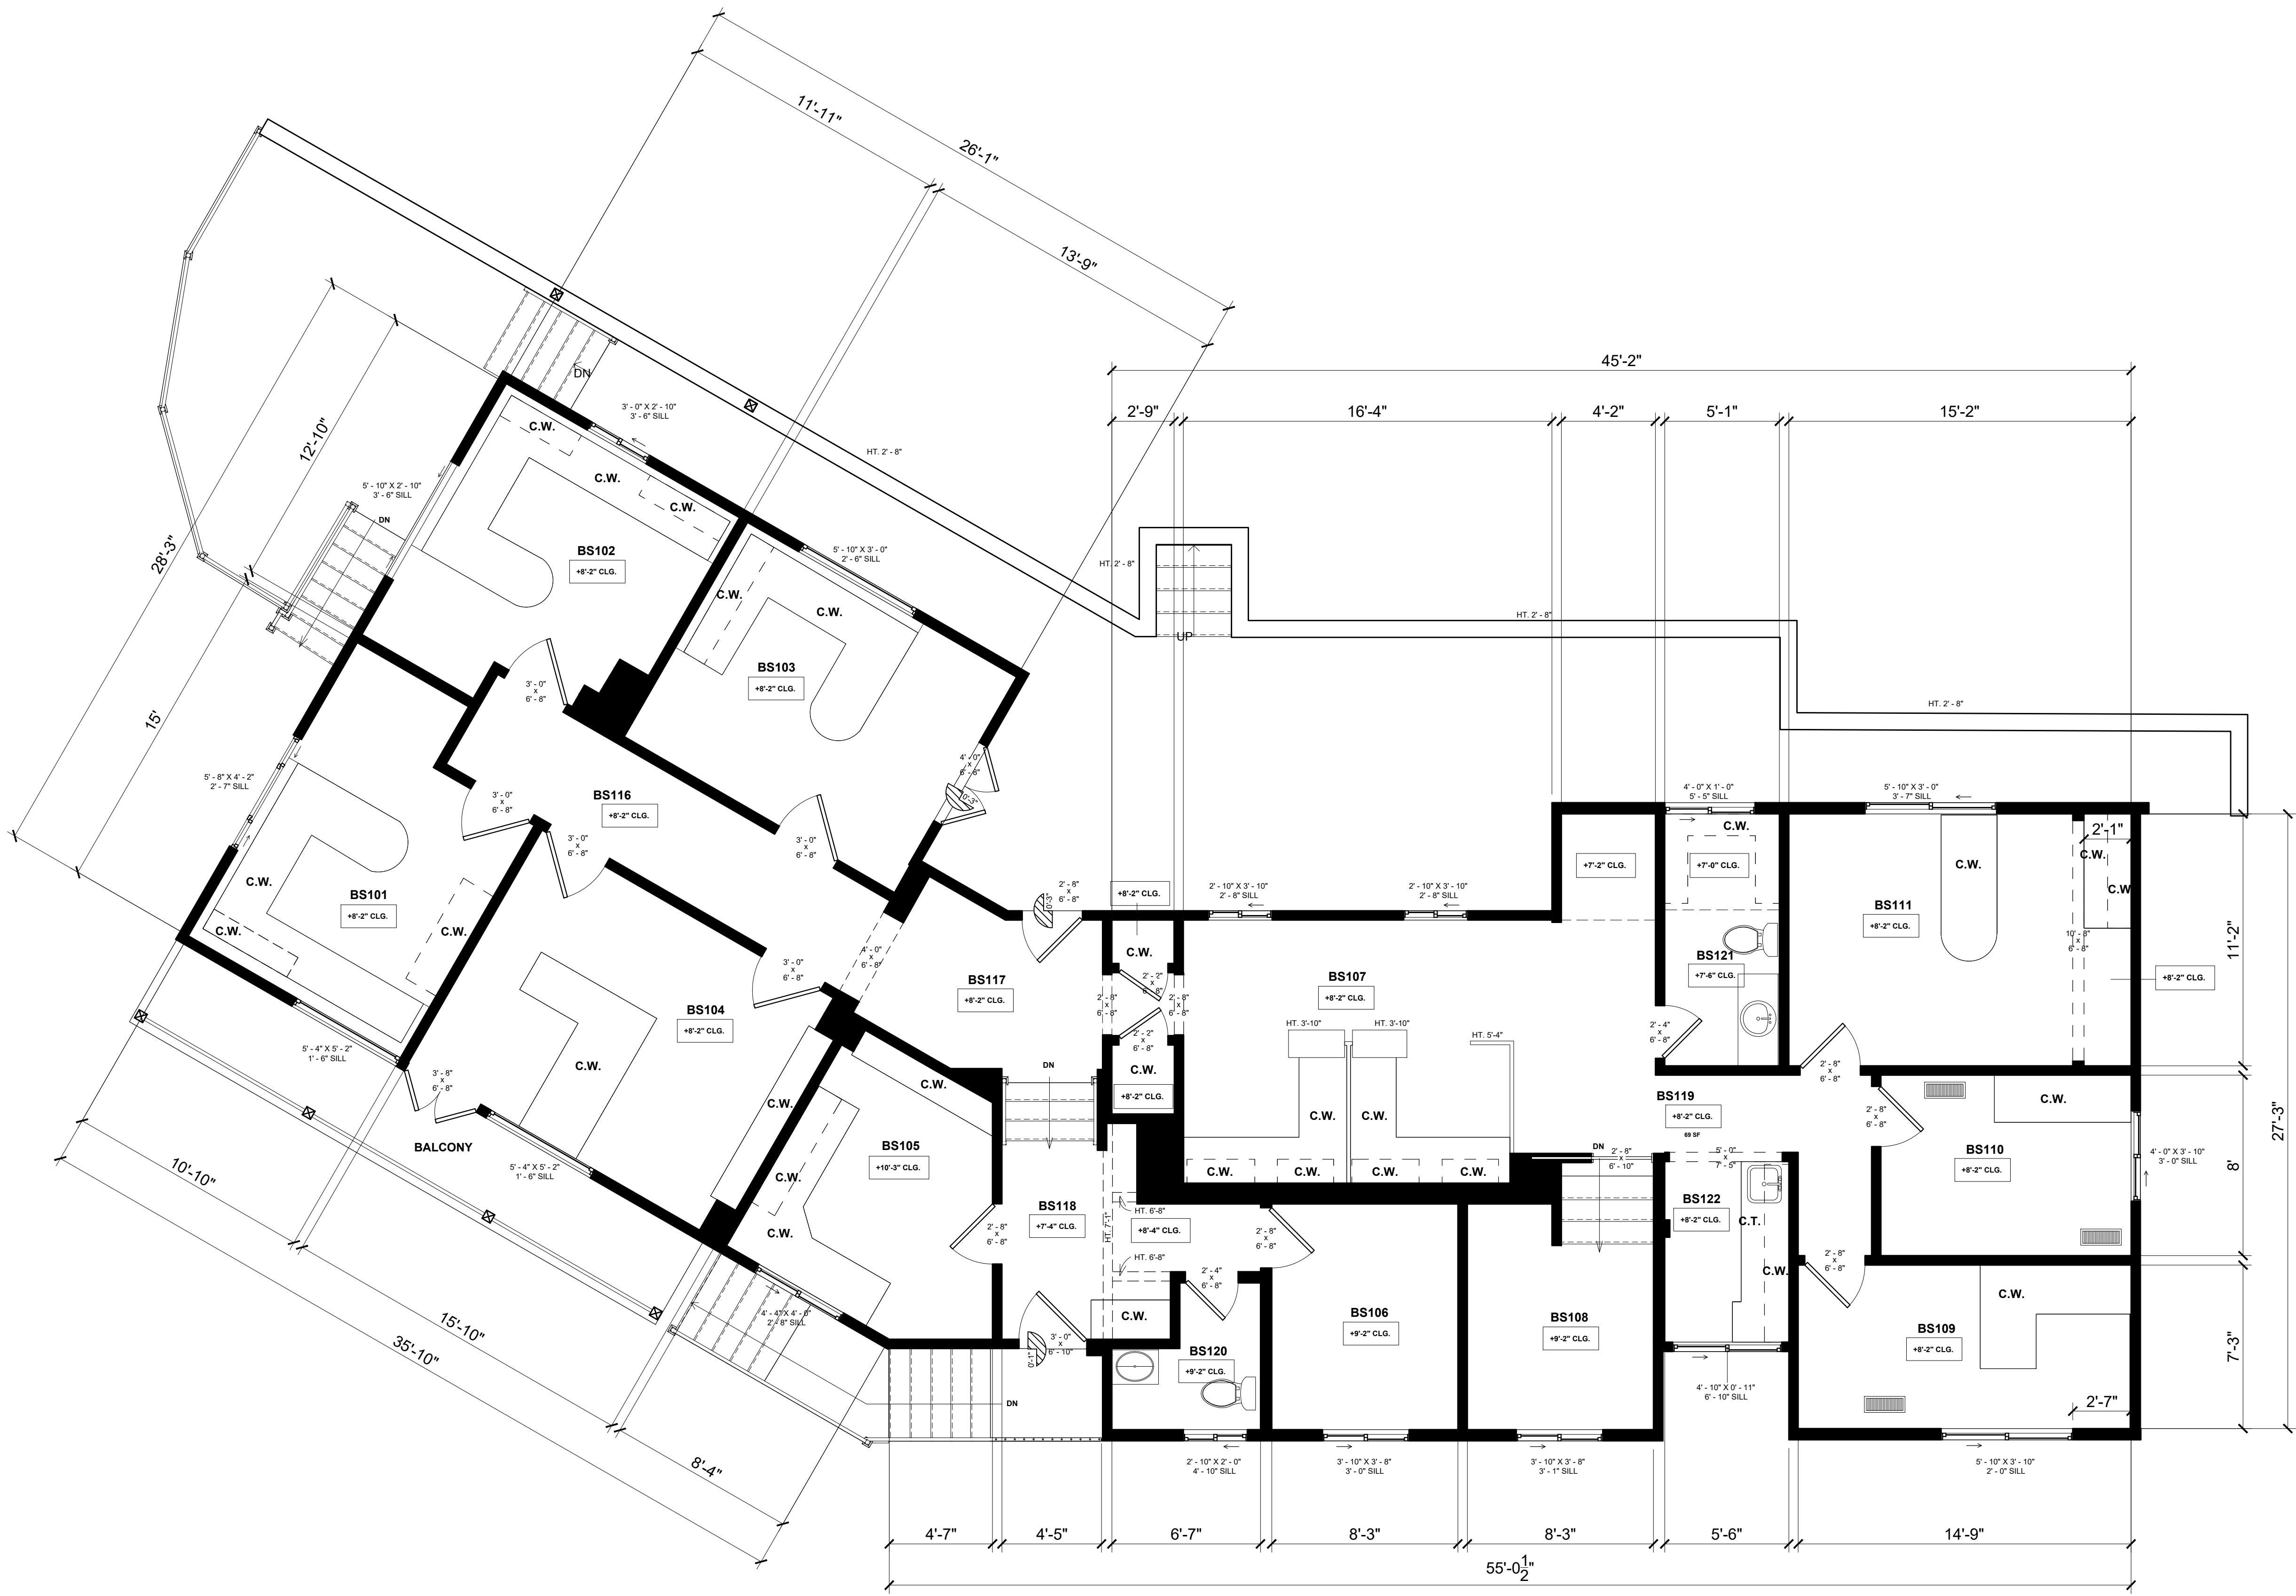

1 ALVAREZ BUSINESS OFFICE - EXISTING SECOND FLOOR PLAN  
1/4" = 1'-0"

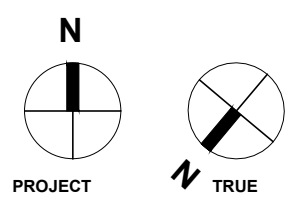

| FLOOR PLAN LEGEND                                                                                                                                                                                                                                                                                                                                                                                                                                                                                                                                                                                                                                                                                                                                                                                   |                                     | <div>HARVARD<br/>WESTLAKE<br/>SCHOOL</div> <div><div>ABLA</div><div>AS BUILT LA<br/>21255 BURBANK BLVD, STE 120<br/>WOODLAND HILLS, CA 91367<br/>WWW.ASBUILT.LA.COM<br/>INFO@ASBUILT.LA.COM<br/>(818)-208-3616</div></div> |  |              |  |
|-----------------------------------------------------------------------------------------------------------------------------------------------------------------------------------------------------------------------------------------------------------------------------------------------------------------------------------------------------------------------------------------------------------------------------------------------------------------------------------------------------------------------------------------------------------------------------------------------------------------------------------------------------------------------------------------------------------------------------------------------------------------------------------------------------|-------------------------------------|----------------------------------------------------------------------------------------------------------------------------------------------------------------------------------------------------------------------------|--|--------------|--|
|                                                                                                                                                                                                                                                                                                                                                                                                                                                                                                                                                                                                                                                                                                                                                                                                     | WINDOW WIDTH X HEIGHT - SILL HEIGHT |                                                                                                                                                                                                                            |  |              |  |
| C.W.                                                                                                                                                                                                                                                                                                                                                                                                                                                                                                                                                                                                                                                                                                                                                                                                | CASEWORK / CABINETRY / BUILT-INS    |                                                                                                                                                                                                                            |  |              |  |
| C.T.                                                                                                                                                                                                                                                                                                                                                                                                                                                                                                                                                                                                                                                                                                                                                                                                | COUNTERTOP / ISLAND                 |                                                                                                                                                                                                                            |  |              |  |
| F.P.                                                                                                                                                                                                                                                                                                                                                                                                                                                                                                                                                                                                                                                                                                                                                                                                | FIREPLACE                           |                                                                                                                                                                                                                            |  |              |  |
| T.O.                                                                                                                                                                                                                                                                                                                                                                                                                                                                                                                                                                                                                                                                                                                                                                                                | TOP OF                              |                                                                                                                                                                                                                            |  |              |  |
| B.O.                                                                                                                                                                                                                                                                                                                                                                                                                                                                                                                                                                                                                                                                                                                                                                                                | BOTTOM OF                           |                                                                                                                                                                                                                            |  |              |  |
| +X' - X' CLG.                                                                                                                                                                                                                                                                                                                                                                                                                                                                                                                                                                                                                                                                                                                                                                                       | CEILING AT HIGHEST POINT            |                                                                                                                                                                                                                            |  |              |  |
| +X' - X'                                                                                                                                                                                                                                                                                                                                                                                                                                                                                                                                                                                                                                                                                                                                                                                            | LEVEL CHANGE                        |                                                                                                                                                                                                                            |  |              |  |
| X'                                                                                                                                                                                                                                                                                                                                                                                                                                                                                                                                                                                                                                                                                                                                                                                                  | STEP DIRECTION & HEIGHT             |                                                                                                                                                                                                                            |  |              |  |
| NOTES REGARDING AREA SIZING                                                                                                                                                                                                                                                                                                                                                                                                                                                                                                                                                                                                                                                                                                                                                                         |                                     | DRAWN BY:                                                                                                                                                                                                                  |  | PG           |  |
| <p>* AREA MEASUREMENTS ARE BASED ON TOTAL SQUARE FOOTAGE MEASURED FROM THE INTERIOR SIDE OF THE WALLS IN ADDITION TO THE EXTERIOR SIDE OF WALLS.</p> <p>** AREA CALCULATIONS ARE COMPLIMENTARY AND WILL NOT NECESSARILY MATCH WHAT IS ON BUILDING OR REAL ESTATE RECORDS.</p> <p>*** IT'S THE RESPONSIBILITY OF THE PROJECT DESIGN PROFESSIONAL TO DETERMINE THE PROPER BREAKDOWN OF SPACES SIZES AS REQUIRED PER LOCAL REGULATIONS, BUILDING AND PLANNING CODES AND PROVIDE COMPLIANCE DOCUMENTATION AS REQUIRED.</p> <p>**** WE RECOMMEND TO ALL OUR CUSTOMERS TO GET A LAND SURVEY OF THEIR PROPERTY WHICH PROVIDES ANOTHER LEVEL OF ACCURACY, SIZING INFORMATION FOR THE PROPERTY, BOUNDARIES, AND AS IS OFTEN REQUIRED BY CITY BUILDING &amp; PLANNING DEPARTMENTS FOR PLAN CHECK REVIEWS.</p> |                                     | CHECKED BY:                                                                                                                                                                                                                |  | F.P.S.       |  |
|                                                                                                                                                                                                                                                                                                                                                                                                                                                                                                                                                                                                                                                                                                                                                                                                     |                                     | DATE:                                                                                                                                                                                                                      |  | 11/01/2025   |  |
|                                                                                                                                                                                                                                                                                                                                                                                                                                                                                                                                                                                                                                                                                                                                                                                                     |                                     | PROJECT ID                                                                                                                                                                                                                 |  | 4578         |  |
|                                                                                                                                                                                                                                                                                                                                                                                                                                                                                                                                                                                                                                                                                                                                                                                                     |                                     | SHEET SIZE                                                                                                                                                                                                                 |  | 48" X 36"    |  |
|                                                                                                                                                                                                                                                                                                                                                                                                                                                                                                                                                                                                                                                                                                                                                                                                     |                                     |                                                                                                                                                                                                                            |  | 2D CAD & PDF |  |
|                                                                                                                                                                                                                                                                                                                                                                                                                                                                                                                                                                                                                                                                                                                                                                                                     |                                     |                                                                                                                                                                                                                            |  |              |  |
|                                                                                                                                                                                                                                                                                                                                                                                                                                                                                                                                                                                                                                                                                                                                                                                                     |                                     |                                                                                                                                                                                                                            |  |              |  |
|                                                                                                                                                                                                                                                                                                                                                                                                                                                                                                                                                                                                                                                                                                                                                                                                     |                                     | SCOPE OF WORK                                                                                                                                                                                                              |  |              |  |
|                                                                                                                                                                                                                                                                                                                                                                                                                                                                                                                                                                                                                                                                                                                                                                                                     |                                     | As Built Set                                                                                                                                                                                                               |  |              |  |
|                                                                                                                                                                                                                                                                                                                                                                                                                                                                                                                                                                                                                                                                                                                                                                                                     |                                     |                                                                                                                                                                                                                            |  |              |  |
|                                                                                                                                                                                                                                                                                                                                                                                                                                                                                                                                                                                                                                                                                                                                                                                                     |                                     |                                                                                                                                                                                                                            |  |              |  |
| </                                                                                                                                                                                                                                                                                                                                                                                                                                                                                                                                                                                                                                                                                                                                                                                                  |                                     |                                                                                                                                                                                                                            |  |              |  |