

AS BUILT LA
21255 BURBANK BLVD, STE 120
WOODLAND HILLS, CA 91367
WWW.ASBUILT.LA.COM
INFO@ASBUILT.LA.COM
(818)-208-3616

NOTES REGARDING AREA SIZING * AREA MEASUREMENTS ARE BASED ON TOTAL SQUARE FOOTAGE MEASURED FROM THE INTERIOR SIDE OF THE WALLS IN ADDITION TO THE EXTERIOR SIDE OF WALLS. ** AREA CALCULATIONS ARE COMPLEMENTARY AND WILL NOT NECESSARILY MATCH WHAT IS ON BUILDING OR REAL ESTATE RECORDS. *** IT'S THE RESPONSIBILITY OF THE PROJECT DESIGN PROFESSIONAL TO DETERMINE THE PROPER BREAKDOWN OF SPACE SIZES AS REQUIRED PER LOCAL REGULATIONS, BUILDING AND PLANNING CODES AND OBTAINING COMPLIANCE DOCUMENTATION AS	DRAWN BY:	M.N
	CHECKED BY:	A.S
	DATE:	11/01/2025
	PROJECT ID	4578
	SHEET SIZE	48" X 36"

PROVIDE COMPLIANCE DOCUMENTATION AS REQUIRED.					
**** WE RECOMMEND TO ALL OUR CUSTOMERS TO GET A LAND SURVEY OF THEIR PROPERTY WHICH PROVIDES ANOTHER LEVEL OF ACCURACY. SIZING INFORMATION FOR THE PROPERTY, BOUNDARIES, AND AS IS OFTEN REQUIRED BY CITY BUILDING & PLANNING DEPARTMENTS FOR PLAN CHECK REVIEWS.	<table border="1"> <tr> <th colspan="2">SCOPE OF WORK</th> </tr> <tr> <td>As Built Set</td> <td></td> </tr> </table>	SCOPE OF WORK		As Built Set	
SCOPE OF WORK					
As Built Set					

AREA CALCULATIONS	
CH100	368 SF
CH101	938 SF
CH102	1231 SF
CH103	382 SF
CH104	1538 SF
CH105	510 SF
CH106	567 SF
CH107	281 SF
CH108	359 SF
CH109	196 SF
CH110	93 SF
CH111	59 SF
CH112	228 SF
Existing 1st Floor Hall - Interior	10950 SF
Existing 1st Floor Hall - Exterior	11447 SF
Existing 2nd Floor Hall - Interior	10763 SF
Existing 2nd Floor Hall - Exterior	11153 SF
Existing 3rd Floor Hall - Interior	10516 SF
Existing 3rd Floor Hall - Exterior	10988 SF

PROJECT ADDRESS:


3700 Coldwater Canyon Ave. Los Angeles, CA 91604

SHEET TITLE:

Chalmers Building
Floor Plans

SCALE: AS NOTED

SHEET NUMBER: AB-102

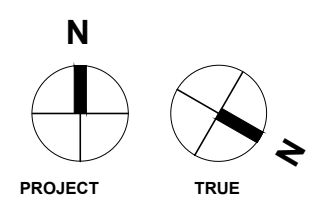

FLOOR PLAN LEGEND	
	WINDOW WIDTH X HEIGHT - SILL HEIGHT
C.W.	CASEWORK / CABINETRY / BUILT-INS
C.T.	COUNTERTOP / ISLAND
F.P.	FIREPLACE
T.O.	TOP OF
B.O.	BOTTOM OF
+X' - X' CLG.	CEILING AT HIGHEST POINT
+X' - X'	LEVEL CHANGE
	STEP DIRECTION & HEIGHT

HARVARD
WESTLAKE
SCHOOL

A
B
LA

AS BUILT LA
21255 BURBANK BLVD, STE 120
WOODLAND HILLS, CA 91367
WWW.ASBUILT.LA.COM
INFO@ASBUILT.LA.COM
(818)-208-3616

DRAWN BY:	M.N
CHECKED BY:	AS
DATE:	11/01/2025
PROJECT ID:	4578
SHEET SIZE:	48" X 36"

SCOPE OF WORK

As Built Set

AREA CALCULATIONS	
CH113	757 SF
CH114	1435 SF
CH115	1560 SF
CH116	235 SF
CH117	271 SF
CH118	130 SF
CH119	102 SF
CH120	141 SF
CH121	147 SF
CH122	141 SF
CH123	169 SF
CH124	107 SF
CH125	96 SF
CH126	94 SF
CH127	130 SF
CH128	131 SF
CH129	129 SF
CH130	130 SF
CH131	127 SF
CH132	128 SF
CH133	127 SF
CH134	114 SF
CH135	113 SF
CH136	60 SF
CH137	130 SF
CH138	135 SF
CH139	788 SF

PROJECT ADDRESS:


3700 Coldwater Canyon Ave. Los Angeles, CA 91604

SHEET TITLE:

Chalmers Building
Floor Plans

SCALE: AS NOTED

SHEET NUMBER: AB-103

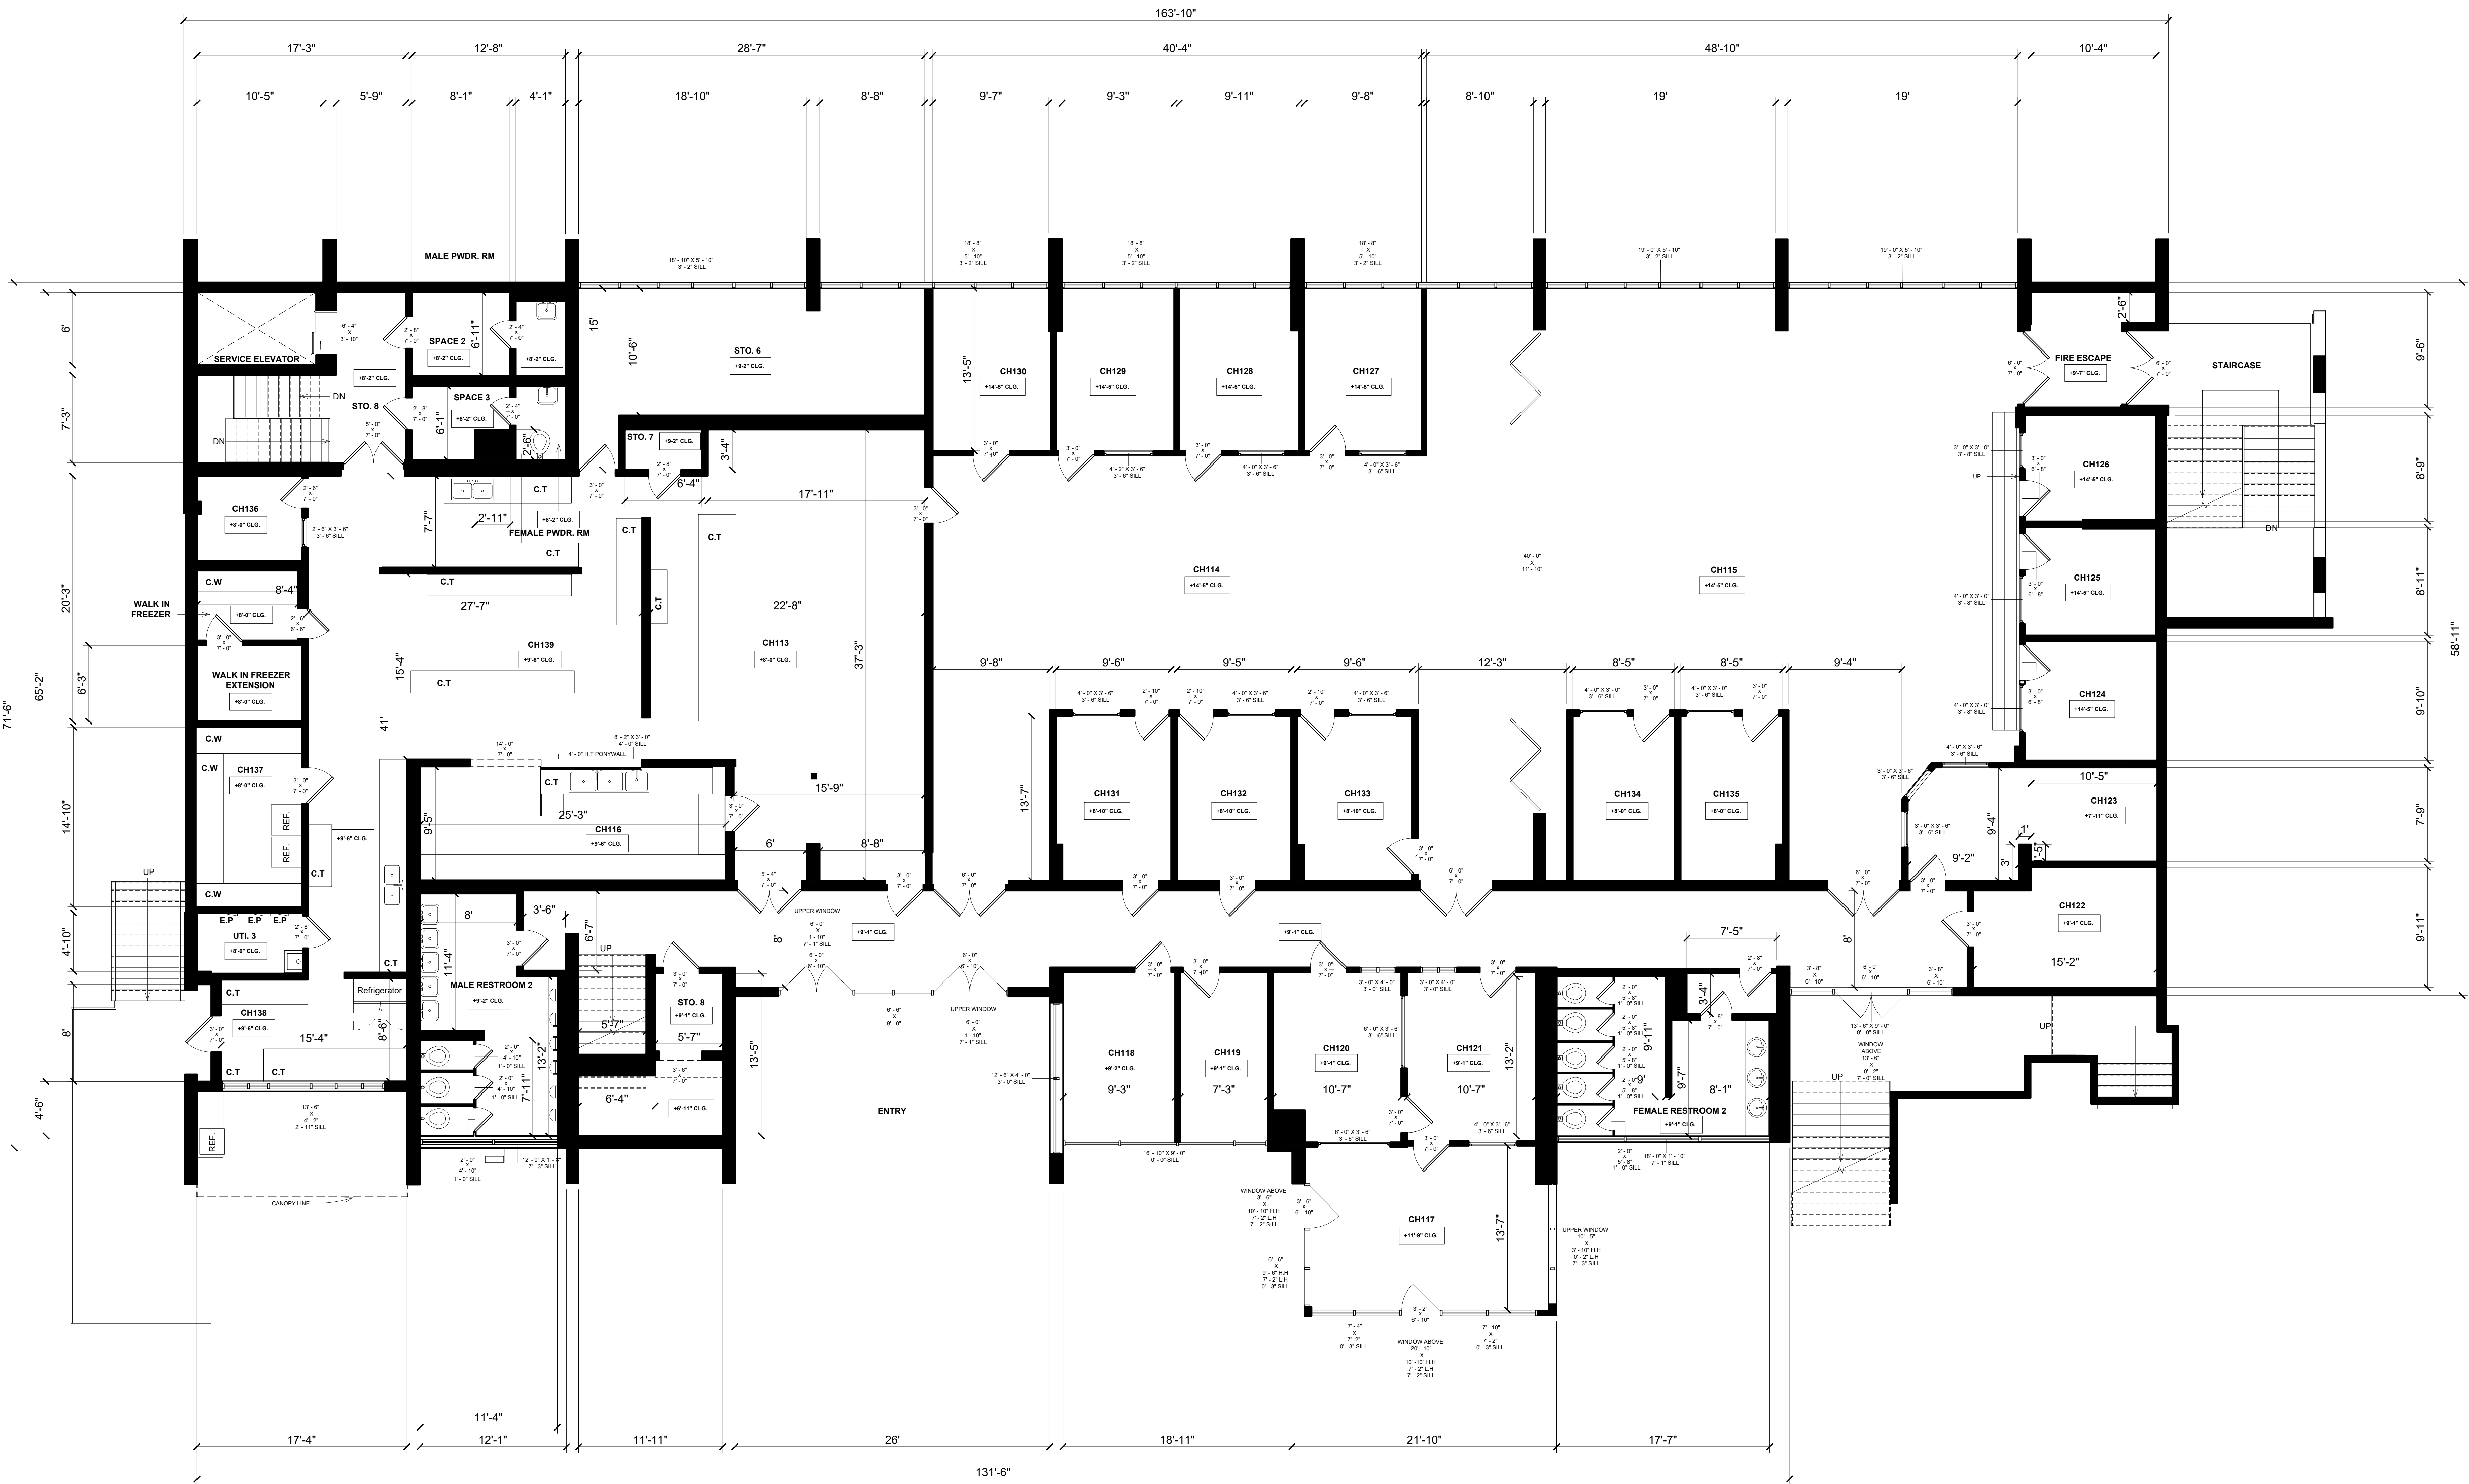

FLOOR PLAN LEGEND

	WINDOW WIDTH X HEIGHT - SILL HEIGHT
C.W.	CASEWORK / CABINETRY / BUILT-INS
C.T.	COUNTERTOP / ISLAND
F.P.	FIREPLACE
T.O.	TOP OF
B.O.	BOTTOM OF
+X' - X' CLG.	CEILING AT HIGHEST POINT
+X' - X'	LEVEL CHANGE
	STEP DIRECTION & HEIGHT

HARVARD
WESTLAKE
SCHOOL

ABLA

AS BUILT LA
21255 BURBANK BLVD, STE 120
WOODLAND HILLS, CA 91367
WWW.ASBUILT.LA.COM
INFO@ASBUILT.LA.COM
(818)-208-3616

DRAWN BY:

M.N

CHECKED BY:

A.S

DATE:

11/01/2025

PROJECT ID:

4578

SHEET SIZE:

48" X 36"

SCOPE OF WORK

As Built Set

AREA CALCULATIONS

CH140	1472 SF
CH141	461 SF
CH142	168 SF
CH143	387 SF
CH144	380 SF
CH145	380 SF
CH146	380 SF
CH147	382 SF
CH148	388 SF
CH149	718 SF
CH150	728 SF
CH151	728 SF
CH152	388 SF
CH153	610 SF

PROJECT ADDRESS:

3700 Coldwater Canyon Ave. Los Angeles, CA 91604

SHEET TITLE:

Chalmers Building Floor Plans

SCALE:

AS NOTED

SHEET NUMBER:

AB-104

