


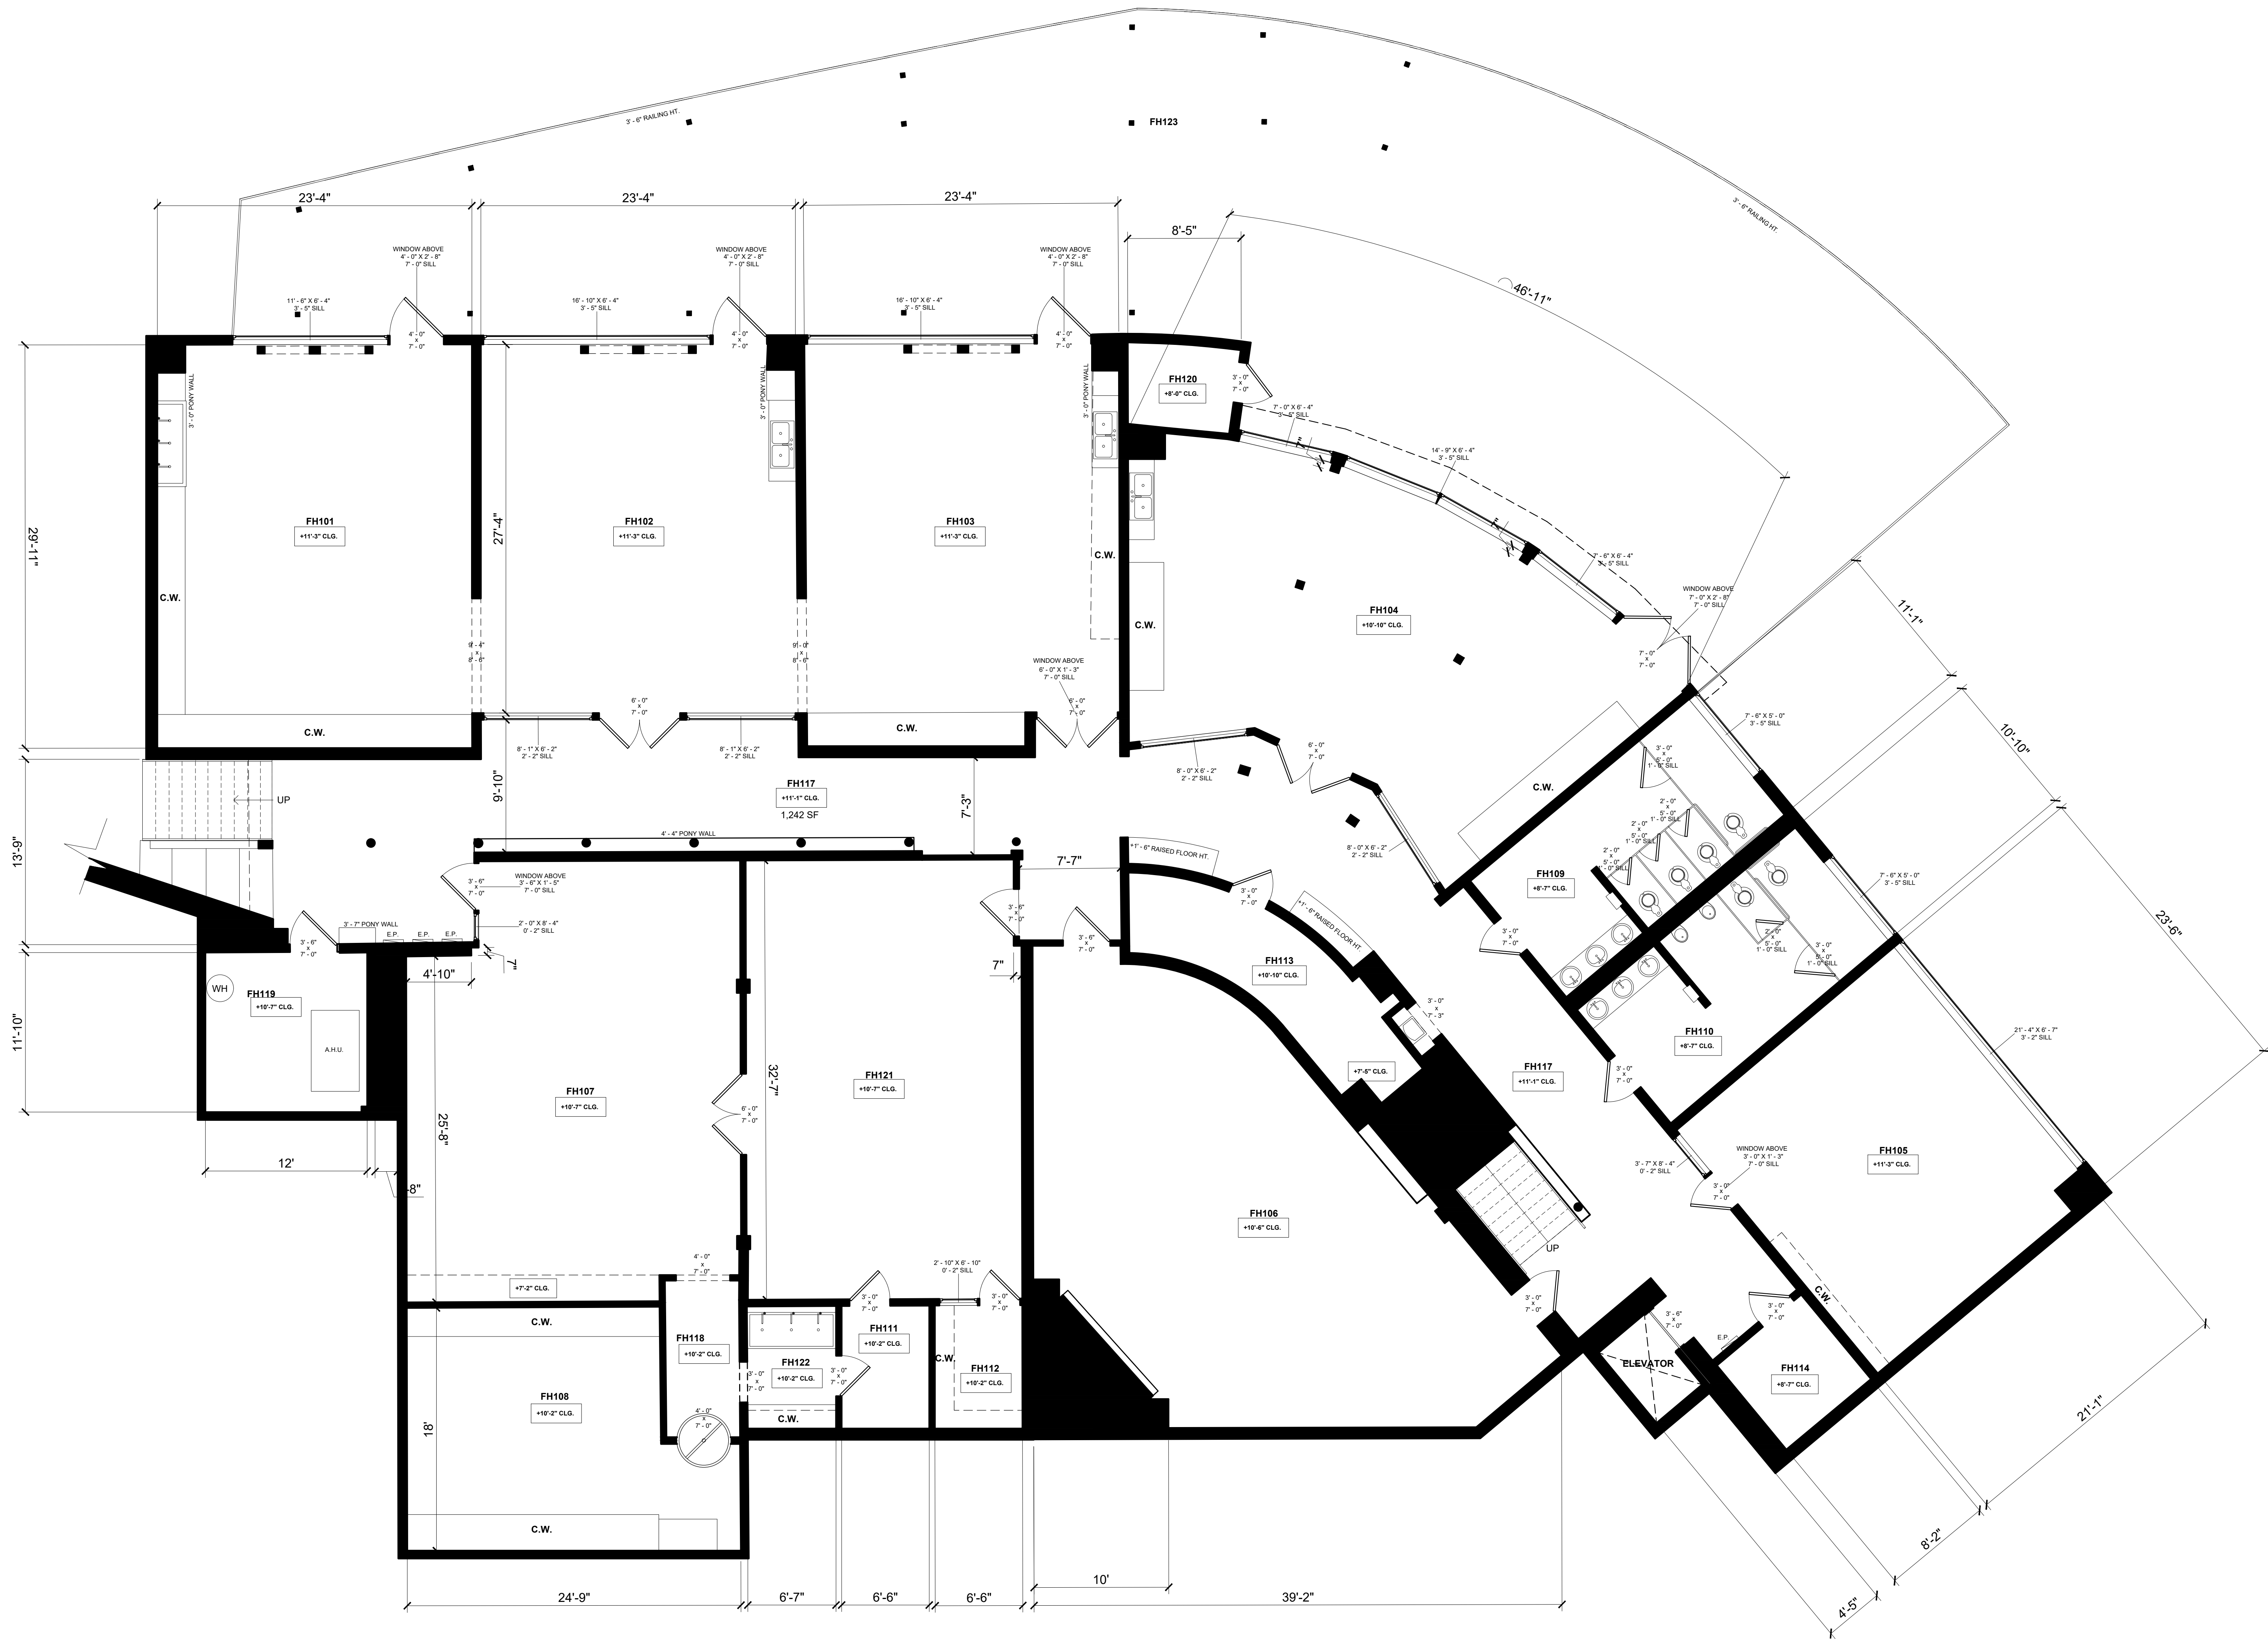

1 FELDMAN HALL - EXISTING GROUND FLOOR PLAN
3/16" = 1'-0"

FLOOR PLAN LEGEND	
	WINDOW WIDTH X HEIGHT - SILL HEIGHT
C.W.	CASEWORK / CABINETRY / BUILT-INS
C.T.	COUNTERTOP / ISLAND
F.P.	FIREPLACE
T.O.	TOP OF
B.O.	BOTTOM OF
+X' - X' CLG.	CEILING AT HIGHEST POINT
+X' - X'	LEVEL CHANGE
X'	STEP DIRECTION & HEIGHT

HARVARD
WESTLAKE
SCHOOL


ABLA


AS BUILT LA
21255 BURBANK BLVD, STE 120
WOODLAND HILLS, CA 91367
WWW.ASBUILT.LA.COM
INFO@ASBUILT.LA.COM
(818)-208-3616

NOTES REGARDING AREA SIZING		DRAWN BY:	J.H.B.
		CHECKED BY:	F.P.S.
* AREA MEASUREMENTS ARE BASED ON TOTAL SQUARE FOOTAGE MEASURED FROM THE INTERIOR SIDE OF THE WALLS IN ADDITION TO THE EXTERIOR SIDE OF WALLS.		DATE:	11/01/2025
		PROJECT ID	4578
** AREA CALCULATIONS ARE COMPLIMENTARY AND WILL NOT NECESSARILY MATCH WHAT IS ON BUILDING OR REAL ESTATE RECORDS.		SHEET SIZE	48" X 36"
*** IT'S THE RESPONSIBILITY OF THE PROJECT DESIGN PROFESSIONAL TO DETERMINE THE PROPER BREAKDOWN OF SPACES SIZES AS REQUIRED PER LOCAL REGULATIONS, BUILDING AND PLANNING CODES AND PROVIDE COMPLIANCE DOCUMENTATION AS REQUIRED.			
**** WE RECOMMEND TO ALL OUR CUSTOMERS TO GET A LAND SURVEY OF THEIR PROPERTY WHICH PROVIDES ANOTHER LEVEL OF ACCURACY, SIZING INFORMATION FOR THE PROPERTY, BOUNDARIES, AND AS IS OFTEN REQUIRED BY CITY BUILDING & PLANNING DEPARTMENTS FOR PLAN CHECK REVIEWS.			
		SCOPE OF WORK	
		As Built Set	

AREA CALCULATIONS	
Existing Residence 1ST FL - Interior	9,135 SF
Existing Residence 2ND FL - Interior	4,631 SF
Existing Residence 2ND FL - Exterior	5,068 SF
FH101	694 SF
FH102	637 SF
FH103	672 SF
FH104	799 SF
FH105	490 SF
FH106	886 SF
FH107	760 SF
FH108	386 SF
FH109	234 SF
FH110	230 SF
FH111	60 SF
FH112	60 SF
FH113	152 SF
FH114	66 SF
FH115	162 SF
FH116	211 SF
FH117	1,242 SF
FH118	64 SF
FH119	142 SF
FH120	53 SF
FH121	661 SF
FH122	60 SF
FH123	2,953 SF
FH124	726 SF
FH125	706 SF
FH126	711 SF
FH127	917 SF
FH128	492 SF
FH129	491 SF
FH130	51 SF

PROJECT ADDRESS:	
3700 Coldwater Canyon Ave. Los Angeles, CA 91604	
SHEET TITLE:	
Feldman Hall Floor Plans	
SCALE:	AS NOTED
SHEET NUMBER:	AB-119

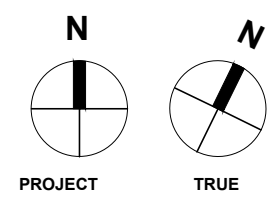

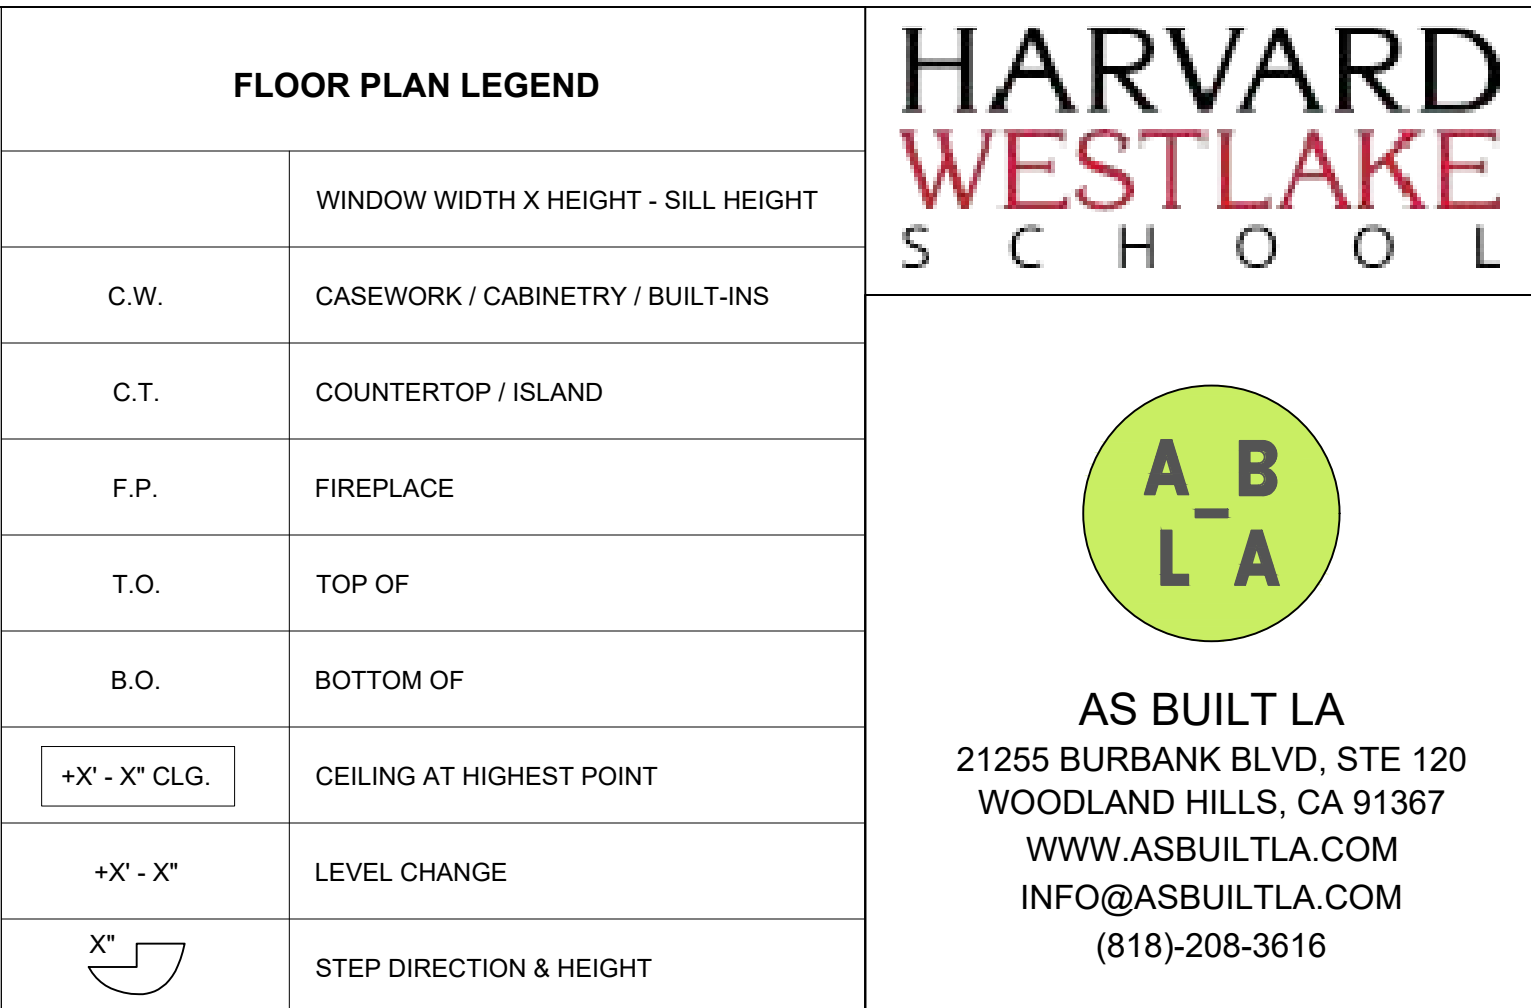

NOTES REGARDING AREA SIZING	DRAWN BY:	J.H.B.
* AREA MEASUREMENTS ARE BASED ON TOTAL SQUARE FOOTAGE MEASURED FROM THE INTERIOR SIDE OF THE WALLS IN ADDITION TO THE EXTERIOR SIDE OF WALLS. ** AREA CALCULATIONS ARE COMPLEMENTARY AND WILL NOT NECESSARILY MATCH WHAT IS ON BUILDING OR REAL ESTATE RECORDS. *** IT'S THE RESPONSIBILITY OF THE PROJECT DESIGN PROFESSIONAL TO DETERMINE THE PROPER BREAKDOWN OF SPACES SIZES AS REQUIRED PER LOCAL REGULATIONS, BUILDING AND PLANNING CODES AND BUILDING FORM LAYOUT CODES AND SECTION 4.0	CHECKED BY:	F.P.S.
	DATE:	11/01/2025
	PROJECT ID	4578
	SHEET SIZE	48" X 36"

**** WE RECOMMEND TO ALL OUR CUSTOMERS TO GET A LAND SURVEY OF THEIR PROPERTY WHICH PROVIDES ANOTHER LEVEL OF ACCURACY. SIZING INFORMATION FOR THE PROPERTY, BOUNDARIES, AND AS IS OFTEN REQUIRED BY CITY BUILDING & PLANNING DEPARTMENTS FOR PLAN CHECK REVIEWS.	As Built Set
--	---------------------

SCOPE OF WORK

As Built Set

PROJECT ADDRESS:

3700 Coldwater Canyon
Ave. Los Angeles, CA 91604

SHEET TITLE:

Feldman Hall
Floor Plans

SCALE: AS NOTED

SHEET NUMBER: AB-120