




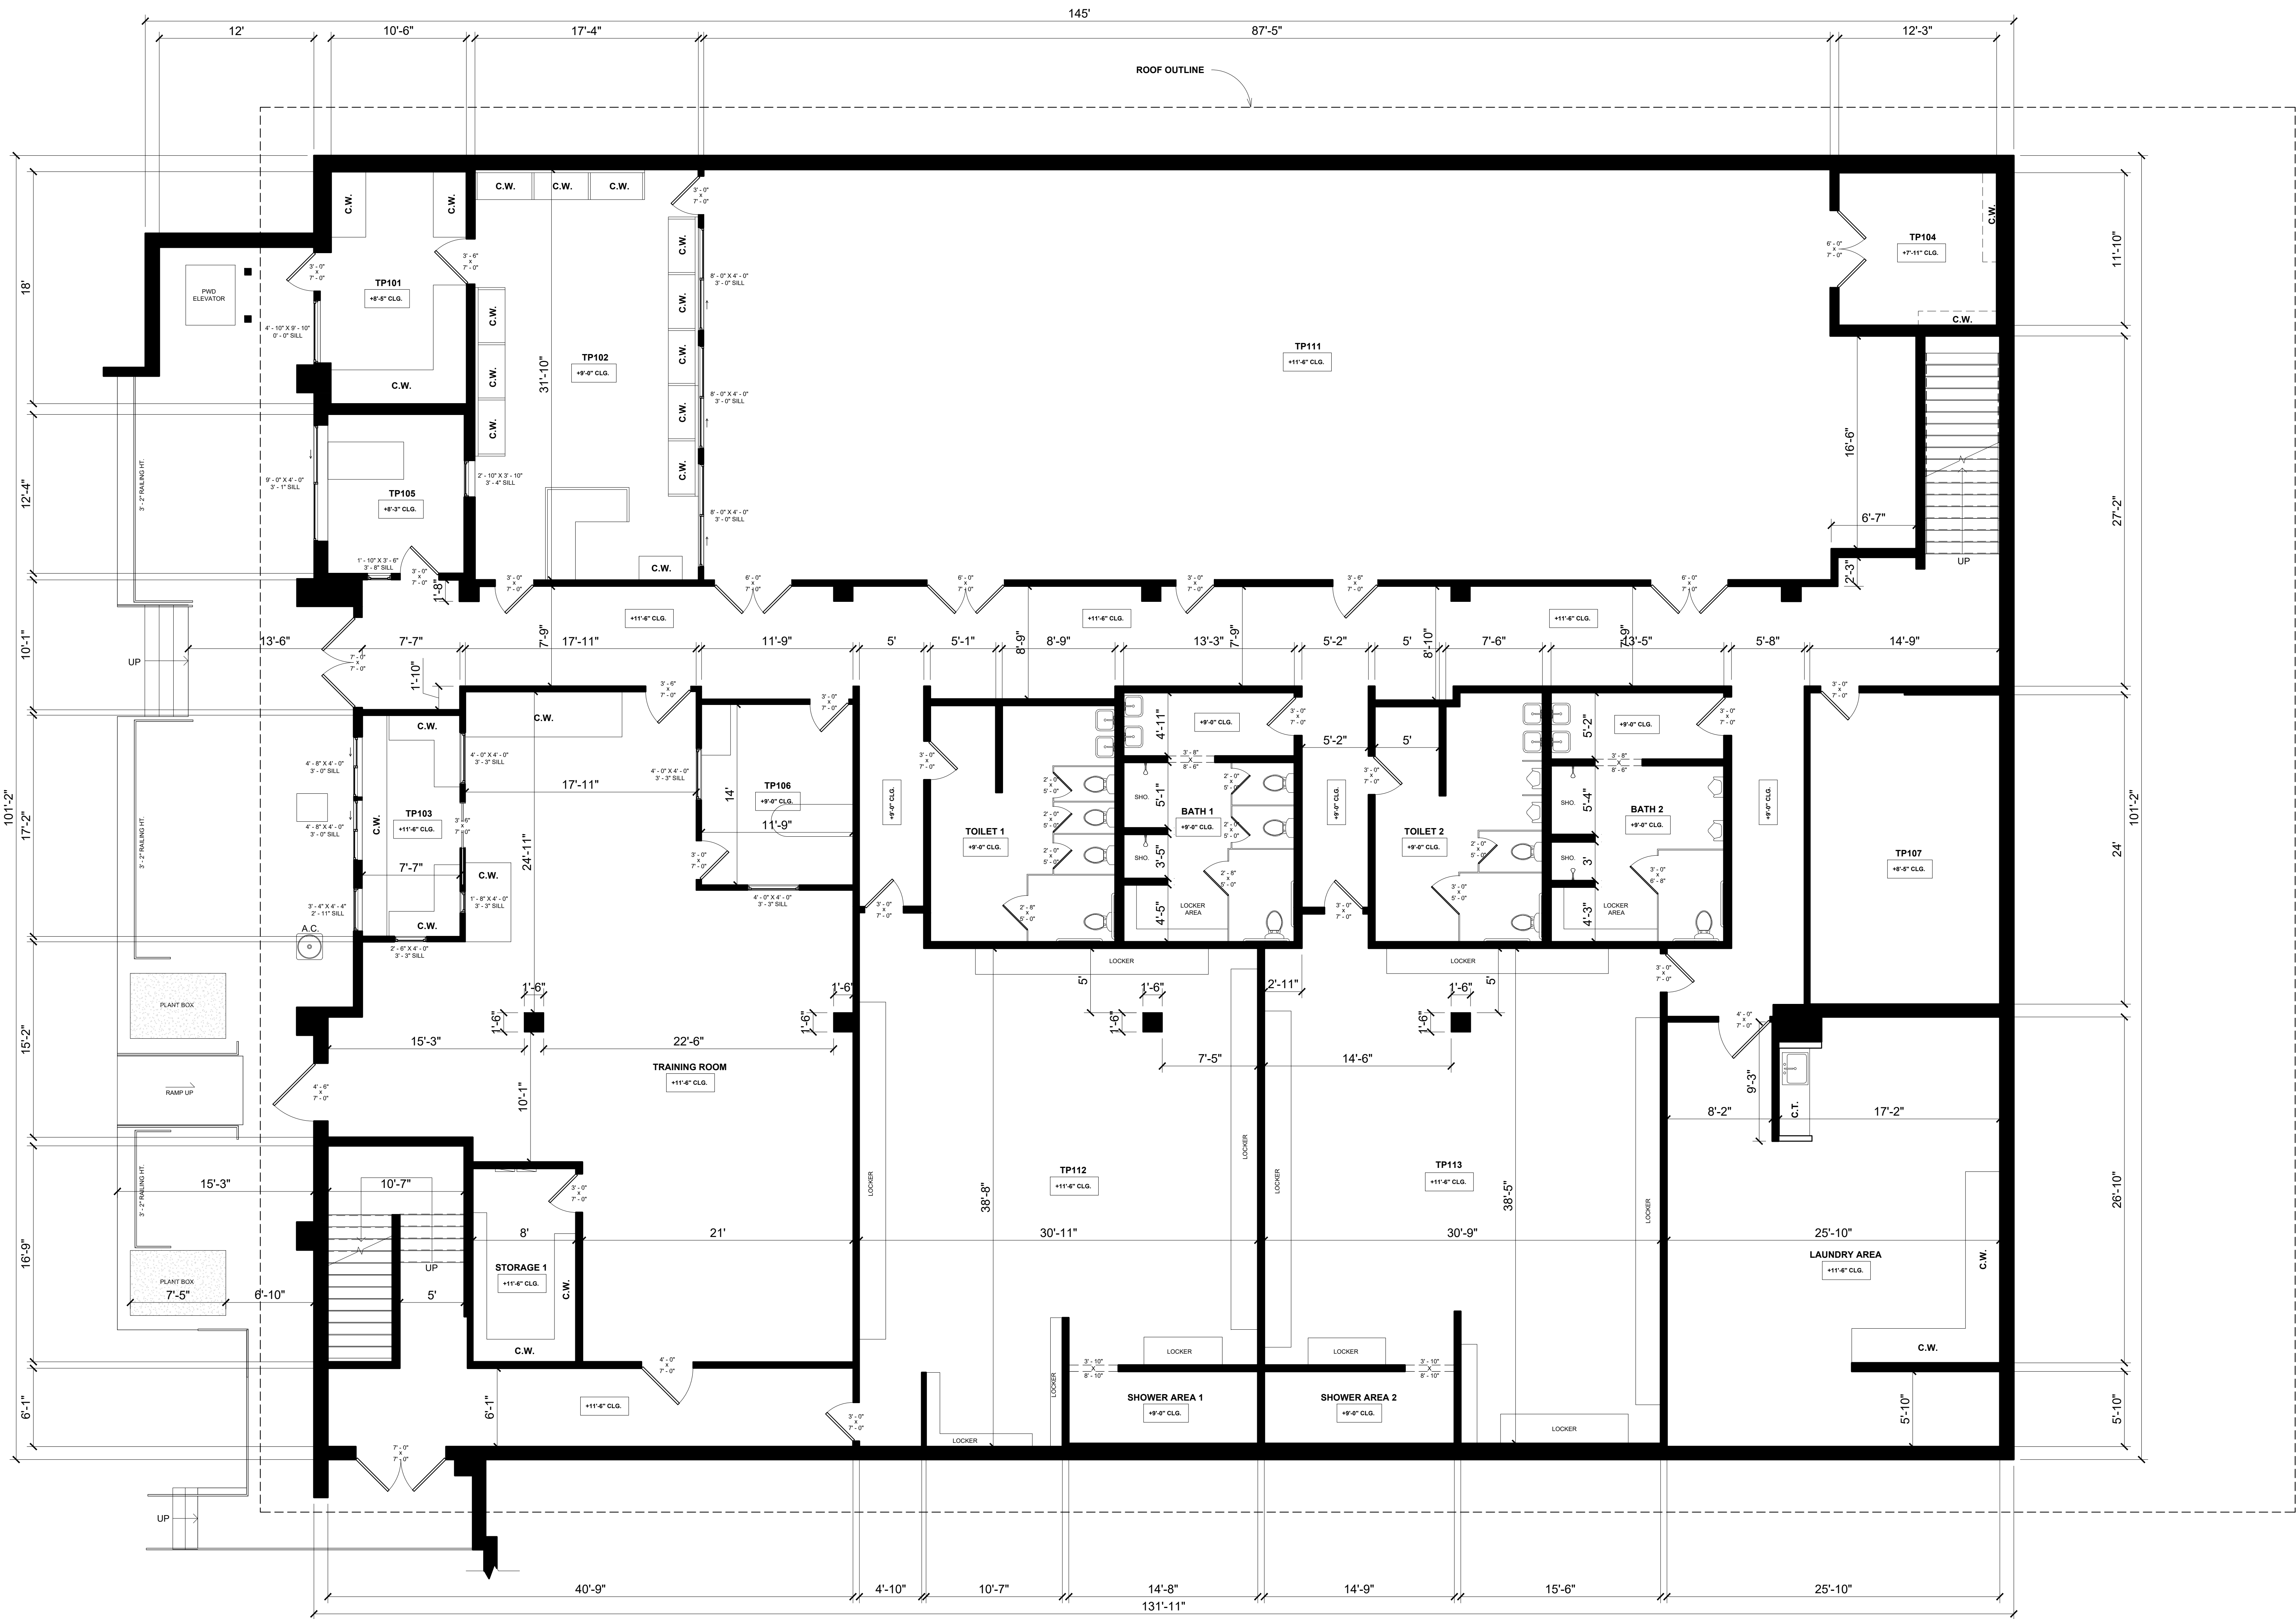


① TAPER ATHLETIC PAVILLION - EXISTING GROUND FLOOR PLAN
3/16" = 1'-0"

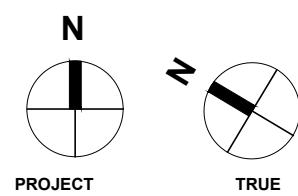



FLOOR PLAN LEGEND		HARVARD WESTLAKE SCHOOL ABLA AS BUILT LA 21255 BURBANK BLVD, STE 120 WOODLAND HILLS, CA 91367 WWW.ASBUILT.LA.COM INFO@ASBUILT.LA.COM (818)-208-3616	
	WINDOW WIDTH X HEIGHT - SILL HEIGHT		
C.W.	CASEWORK / CABINETRY / BUILT-INS		
C.T.	COUNTERTOP / ISLAND		
F.P.	FIREPLACE		
T.O.	TOP OF		
B.O.	BOTTOM OF		
+X' - X' CLG.	CEILING AT HIGHEST POINT	DRAWN BY: E.P. CHECKED BY: F.P.S. DATE: 11/01/2025 PROJECT ID: 3700 SHEET SIZE: 48" X 36" 2D CAD & PDF	
+X' - X'	LEVEL CHANGE		
X'	STEP DIRECTION & HEIGHT	SCOPE OF WORK	
NOTES REGARDING AREA SIZING		As Built Set	
		AREA CALCULATIONS	
		TP101 189 SF TP102 552 SF TP103 130 SF TP104 151 SF TP105 130 SF TP106 164 SF TP107 355 SF TP108 207 SF TP109 372 SF TP110 1381 SF TP111 2894 SF TP112 1113 SF TP113 1102 SF TP114 10482 SF TP115 101 SF TP116 1415 SF TP117 307 SF	
		PROJECT ADDRESS:	
* AREA MEASUREMENTS ARE BASED ON TOTAL SQUARE FOOTAGE MEASURED FROM THE INTERIOR SIDE OF THE WALLS IN ADDITION TO THE EXTERIOR SIDE OF WALLS.		3700 Coldwater Canyon Ave. Los Angeles, CA 91604	
		SHEET TITLE:	
** AREA CALCULATIONS ARE COMPLEMENTARY AND WILL NOT NECESSARILY MATCH WHAT IS ON BUILDING OR REAL ESTATE RECORDS.		Taper Pavillion Floor Plans	
		SCALE: AS NOTED	
*** IT'S THE RESPONSIBILITY OF THE PROJECT DESIGN PROFESSIONAL TO DETERMINE THE PROPER BREAKDOWN OF SPACES SIZES AS REQUIRED PER LOCAL REGULATIONS, BUILDING AND PLANNING CODES AND PROVIDE COMPLIANCE DOCUMENTATION AS REQUIRED.		SHEET NUMBER: AB-109	
**** WE RECOMMEND TO ALL OUR CUSTOMERS TO GET A LAND SURVEY OF THEIR PROPERTY WHICH PROVIDES ANOTHER LEVEL OF ACCURACY, SIZING INFORMATION FOR THE PROPERTY, BOUNDARIES, AND AS IS OFTEN REQUIRED BY CITY BUILDING & PLANNING DEPARTMENTS FOR PLAN CHECK REVIEWS.			

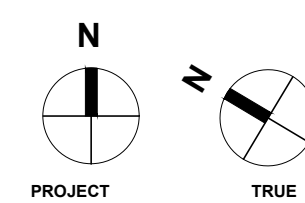

HARVARD
WESTLAKE
S C H O O L

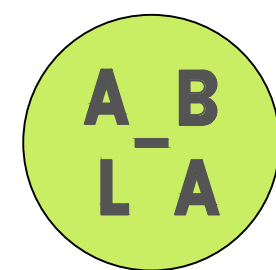

AS BUILT LA
21255 BURBANK BLVD, STE 120
WOODLAND HILLS, CA 91367
WWW.ASBUILT.LA.COM
INFO@ASBUILT.LA.COM
(818)-208-3616

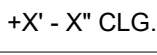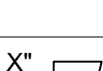FLOOR PLAN LEGEND	
	WINDOW WIDTH X HEIGHT - SILL HEIGHT
C.W.	CASEWORK / CABINETRY / BUILT-INS
C.T.	COUNTERTOP / ISLAND
F.P.	FIREPLACE
T.O.	TOP OF
B.O.	BOTTOM OF
	CEILING AT HIGHEST POINT
+X' - X"	LEVEL CHANGE
	STEP DIRECTION & HEIGHT

NOTES REGARDING AREA SIZING * AREA MEASUREMENTS ARE BASED ON TOTAL SQUARE FOOTAGE MEASURED FROM THE INTERIOR SIDE OF THE WALLS IN ADDITION TO THE EXTERIOR SIDE OF WALLS. ** AREA CALCULATIONS ARE COMPLEMENTARY AND WILL NOT NECESSARILY MATCH WHAT IS ON BUILDING OR REAL ESTATE RECORDS. *** IT'S THE RESPONSIBILITY OF THE PROJECT DESIGN PROFESSIONAL, TO DETERMINE THE PROPER BREAKDOWN OF SPACES SIZES AS REQUIRED PER LOCAL REGULATIONS, BUILDING AND PLANNING CODES AND BUILDING COMPLIANCE CODES, IN ADDITION AS	DRAWN BY:	E.P.
	CHECKED BY:	F.P.S.
	DATE:	11/01/2025
	PROJECT ID	3700
	SHEET SIZE	48" X 36"

***** WE RECOMMEND TO ALL OUR CUSTOMERS TO GET A LAND SURVEY OF THEIR PROPERTY WHICH PROVIDES ANOTHER LEVEL OF ACCURACY, SIZING INFORMATION FOR THE PROPERTY, BOUNDARIES, AND AS IS OFTEN REQUIRED BY CITY BUILDING & PLANNING DEPARTMENTS FOR PLAN CHECK REVIEWS.	SCOPE OF WORK
	As Built Set

AREA CALCULATIONS	
TP101	189 SF
TP102	552 SF
TP103	130 SF
TP104	151 SF
TP105	130 SF
TP106	164 SF
TP107	355 SF
TP108	207 SF
TP109	372 SF
TP110	1381 SF
TP111	2894 SF
TP112	1113 SF
TP113	1102 SF
TP114	10482 SF
TP115	101 SF
TP116	1415 SF
TP117	307 SF

PROJECT ADDRESS:


3700 Coldwater Canyon Ave. Los Angeles, CA 91604

SHEET TITLE:


Taper Pavillion Floor Plans

SCALE: AS NOTED

SHEET NUMBER: AB-110

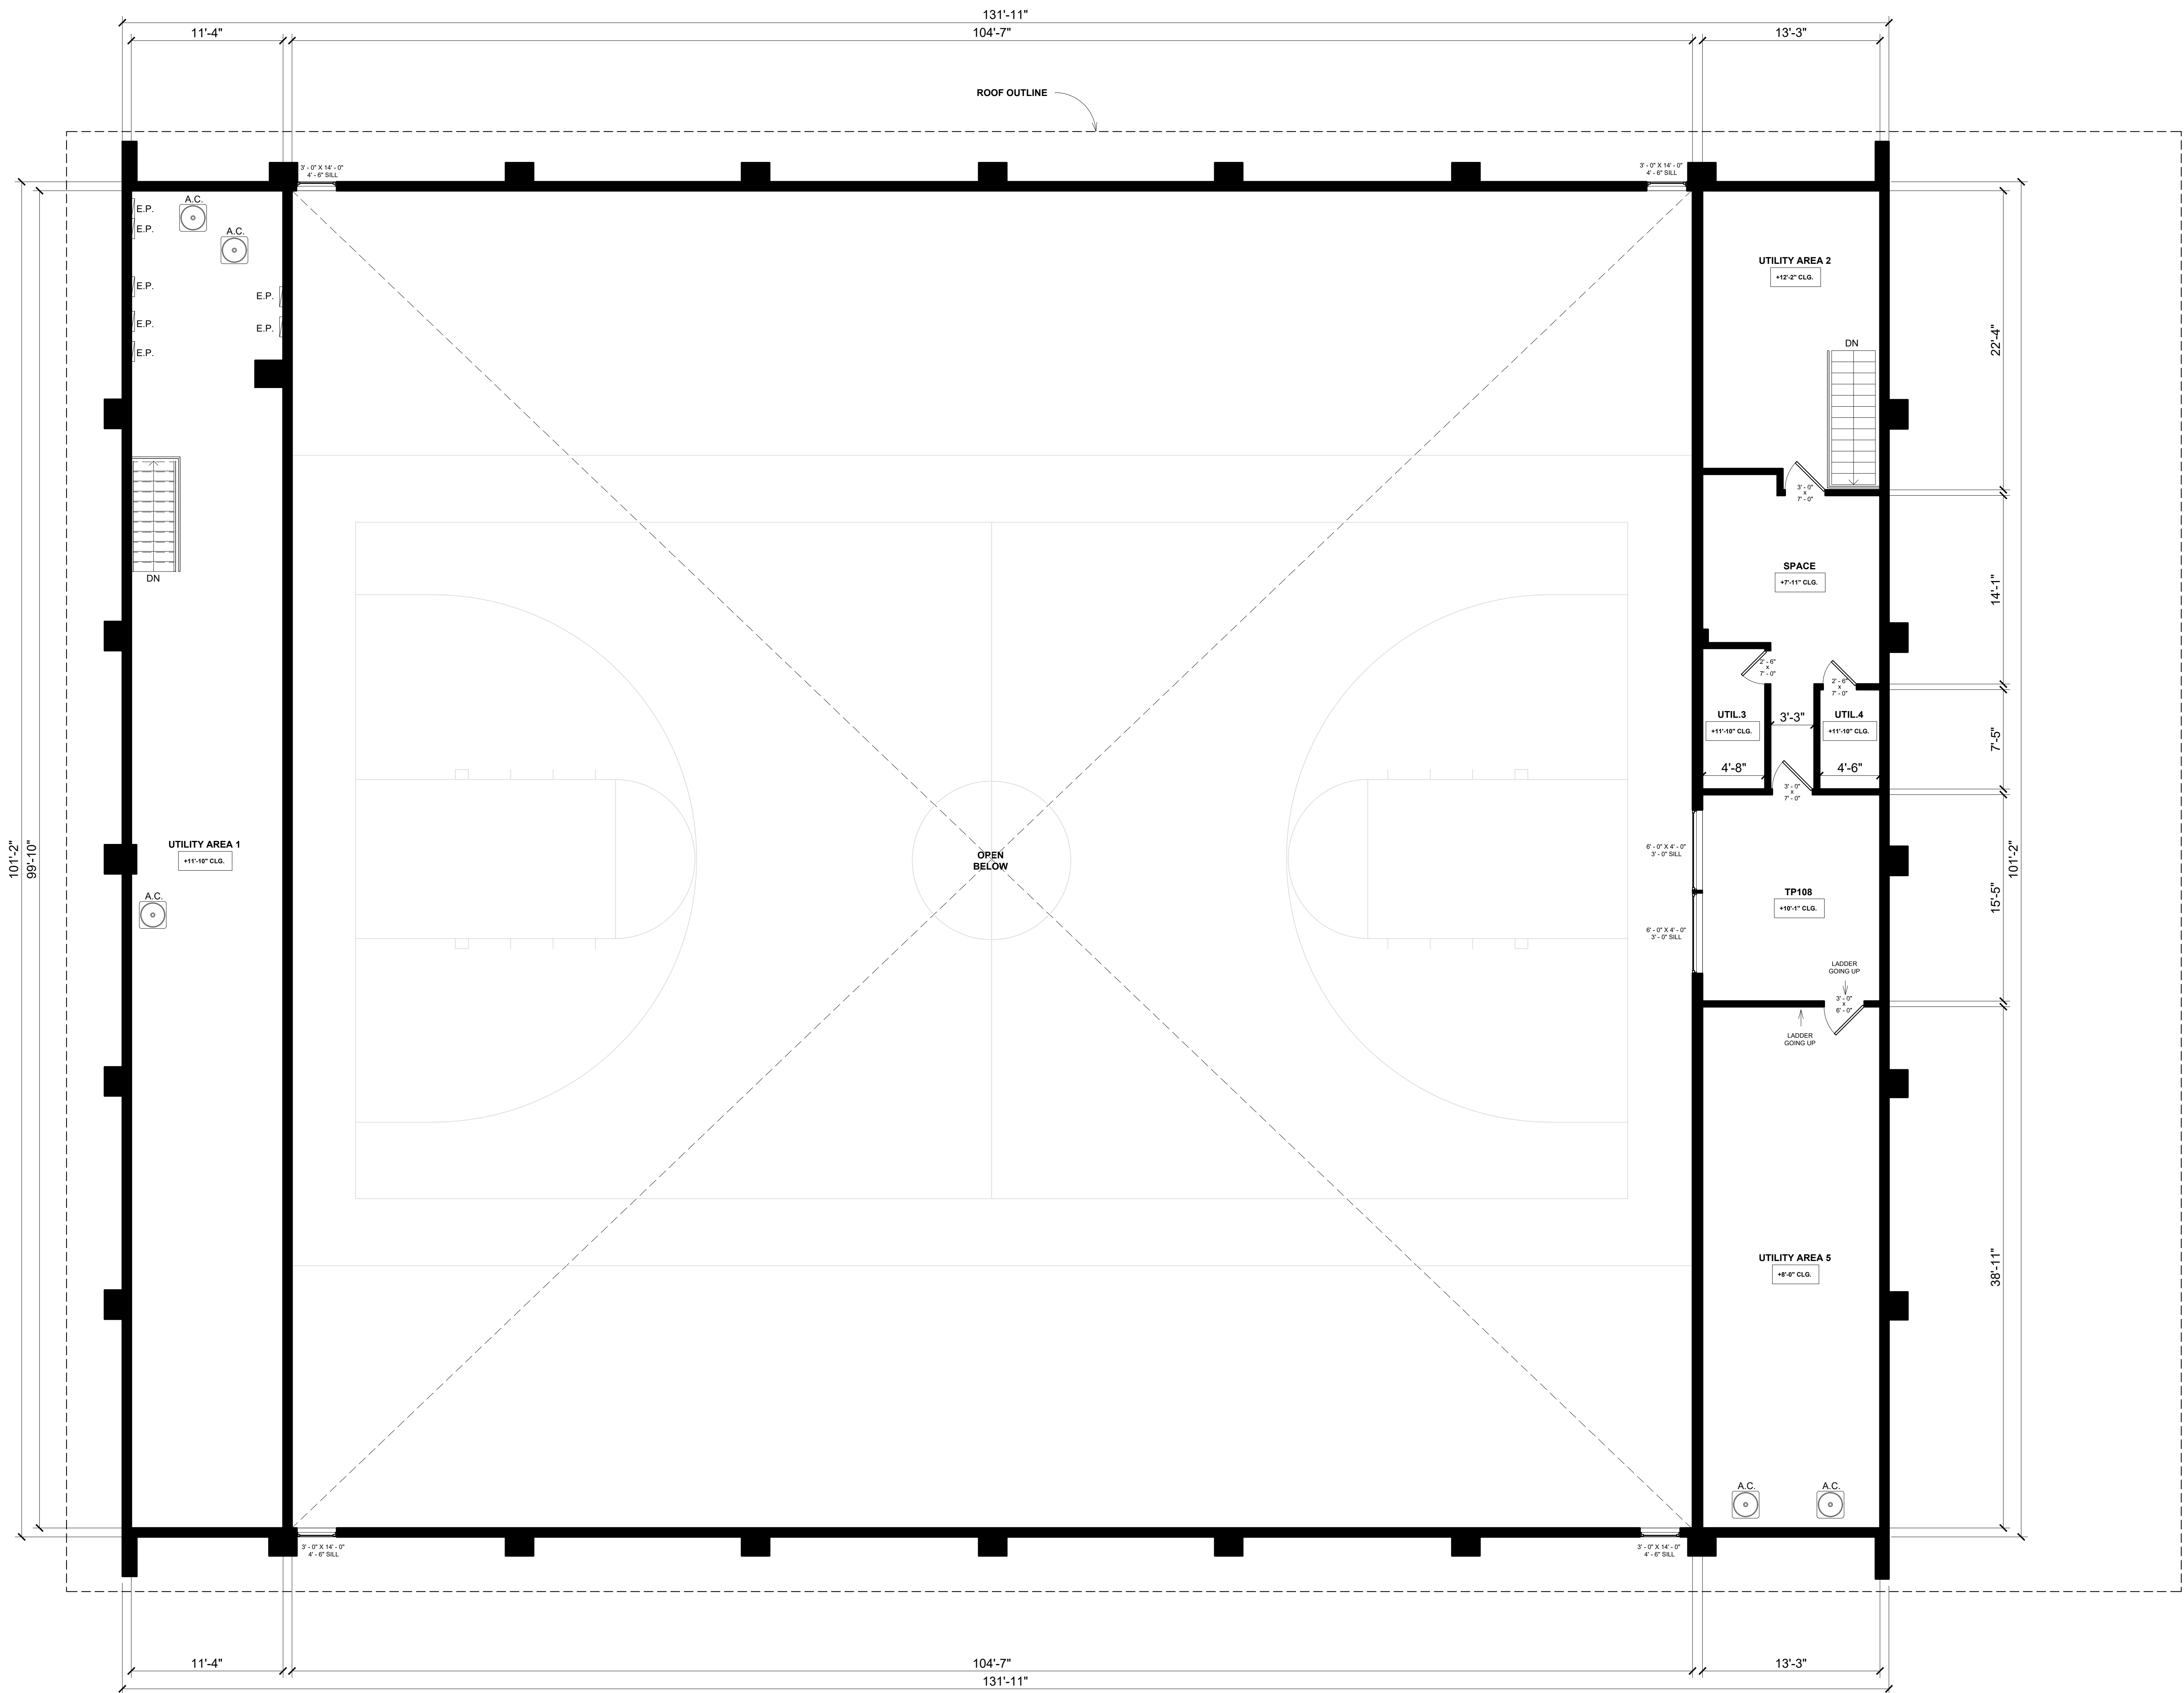

① TAPER ATHLETIC PAVILLION - EXISTING THIRD FLOOR PLAN
3/16" = 1'-0"

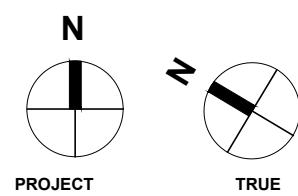

FLOOR PLAN LEGEND		HARVARD WESTLAKE SCHOOL ABLA AS BUILT LA 21255 BURBANK BLVD, STE 120 WOODLAND HILLS, CA 91367 WWW.ASBUILTLA.COM INFO@ASBUILTLA.COM (818)-208-3616	
	WINDOW WIDTH X HEIGHT - SILL HEIGHT		
C.W.	CASEWORK / CABINETRY / BUILT-INS		
C.T.	COUNTERTOP / ISLAND		
F.P.	FIREPLACE		
T.O.	TOP OF		
B.O.	BOTTOM OF		
+X" - X" CLG.	CEILING AT HIGHEST POINT	NOTES REGARDING AREA SIZING * AREA MEASUREMENTS ARE BASED ON TOTAL SQUARE FOOTAGE MEASURED FROM THE INTERIOR SIDE OF THE WALLS IN ADDITION TO THE EXTERIOR SIDE OF WALLS. ** AREA CALCULATIONS ARE COMPLIMENTARY AND WILL NOT NECESSARILY MATCH WHAT IS ON BUILDING OR REAL ESTATE RECORDS. *** IT'S THE RESPONSIBILITY OF THE PROJECT DESIGN PROFESSIONAL TO DETERMINE THE PROPER BREAKDOWN OF SPACES SIZES AS REQUIRED PER LOCAL REGULATIONS, BUILDING AND PLANNING CODES AND PROVIDE COMPLIANCE DOCUMENTATION AS REQUIRED. **** WE RECOMMEND TO ALL OUR CUSTOMERS TO GET A LAND SURVEY OF THEIR PROPERTY WHICH PROVIDES ANOTHER LEVEL OF ACCURACY, SIZING INFORMATION FOR THE PROPERTY, BOUNDARIES, AND AS IS OFTEN REQUIRED BY CITY BUILDING & PLANNING DEPARTMENTS FOR PLAN CHECK REVIEWS.	
+X" - X"	LEVEL CHANGE		
X"	STEP DIRECTION & HEIGHT		
		DRAWN BY:	E.P.
		CHECKED BY:	F.P.S.
		DATE:	11/01/2025
		PROJECT ID	3700
		SHEET SIZE	48" X 36"
		SCOPE OF WORK	
		As Built Set	
		AREA CALCULATIONS	
		TP101	189 SF
		TP102	552 SF
		TP103	130 SF
		TP104	151 SF
		TP105	130 SF
		TP106	164 SF
		TP107	355 SF
		TP108	207 SF
		TP109	372 SF
		TP110	1381 SF
		TP111	2894 SF
		TP112	1113 SF
		TP113	1102 SF
		TP114	10482 SF
		TP115	101 SF
		TP116	1415 SF
		TP117	307 SF
		PROJECT ADDRESS:	
		3700 Coldwater Canyon Ave. Los Angeles, CA 91604	
		SHEET TITLE:	
		Taper Pavillion Floor Plans	
		SCALE:	AS NOTED
		SHEET NUMBER:	AB-111