


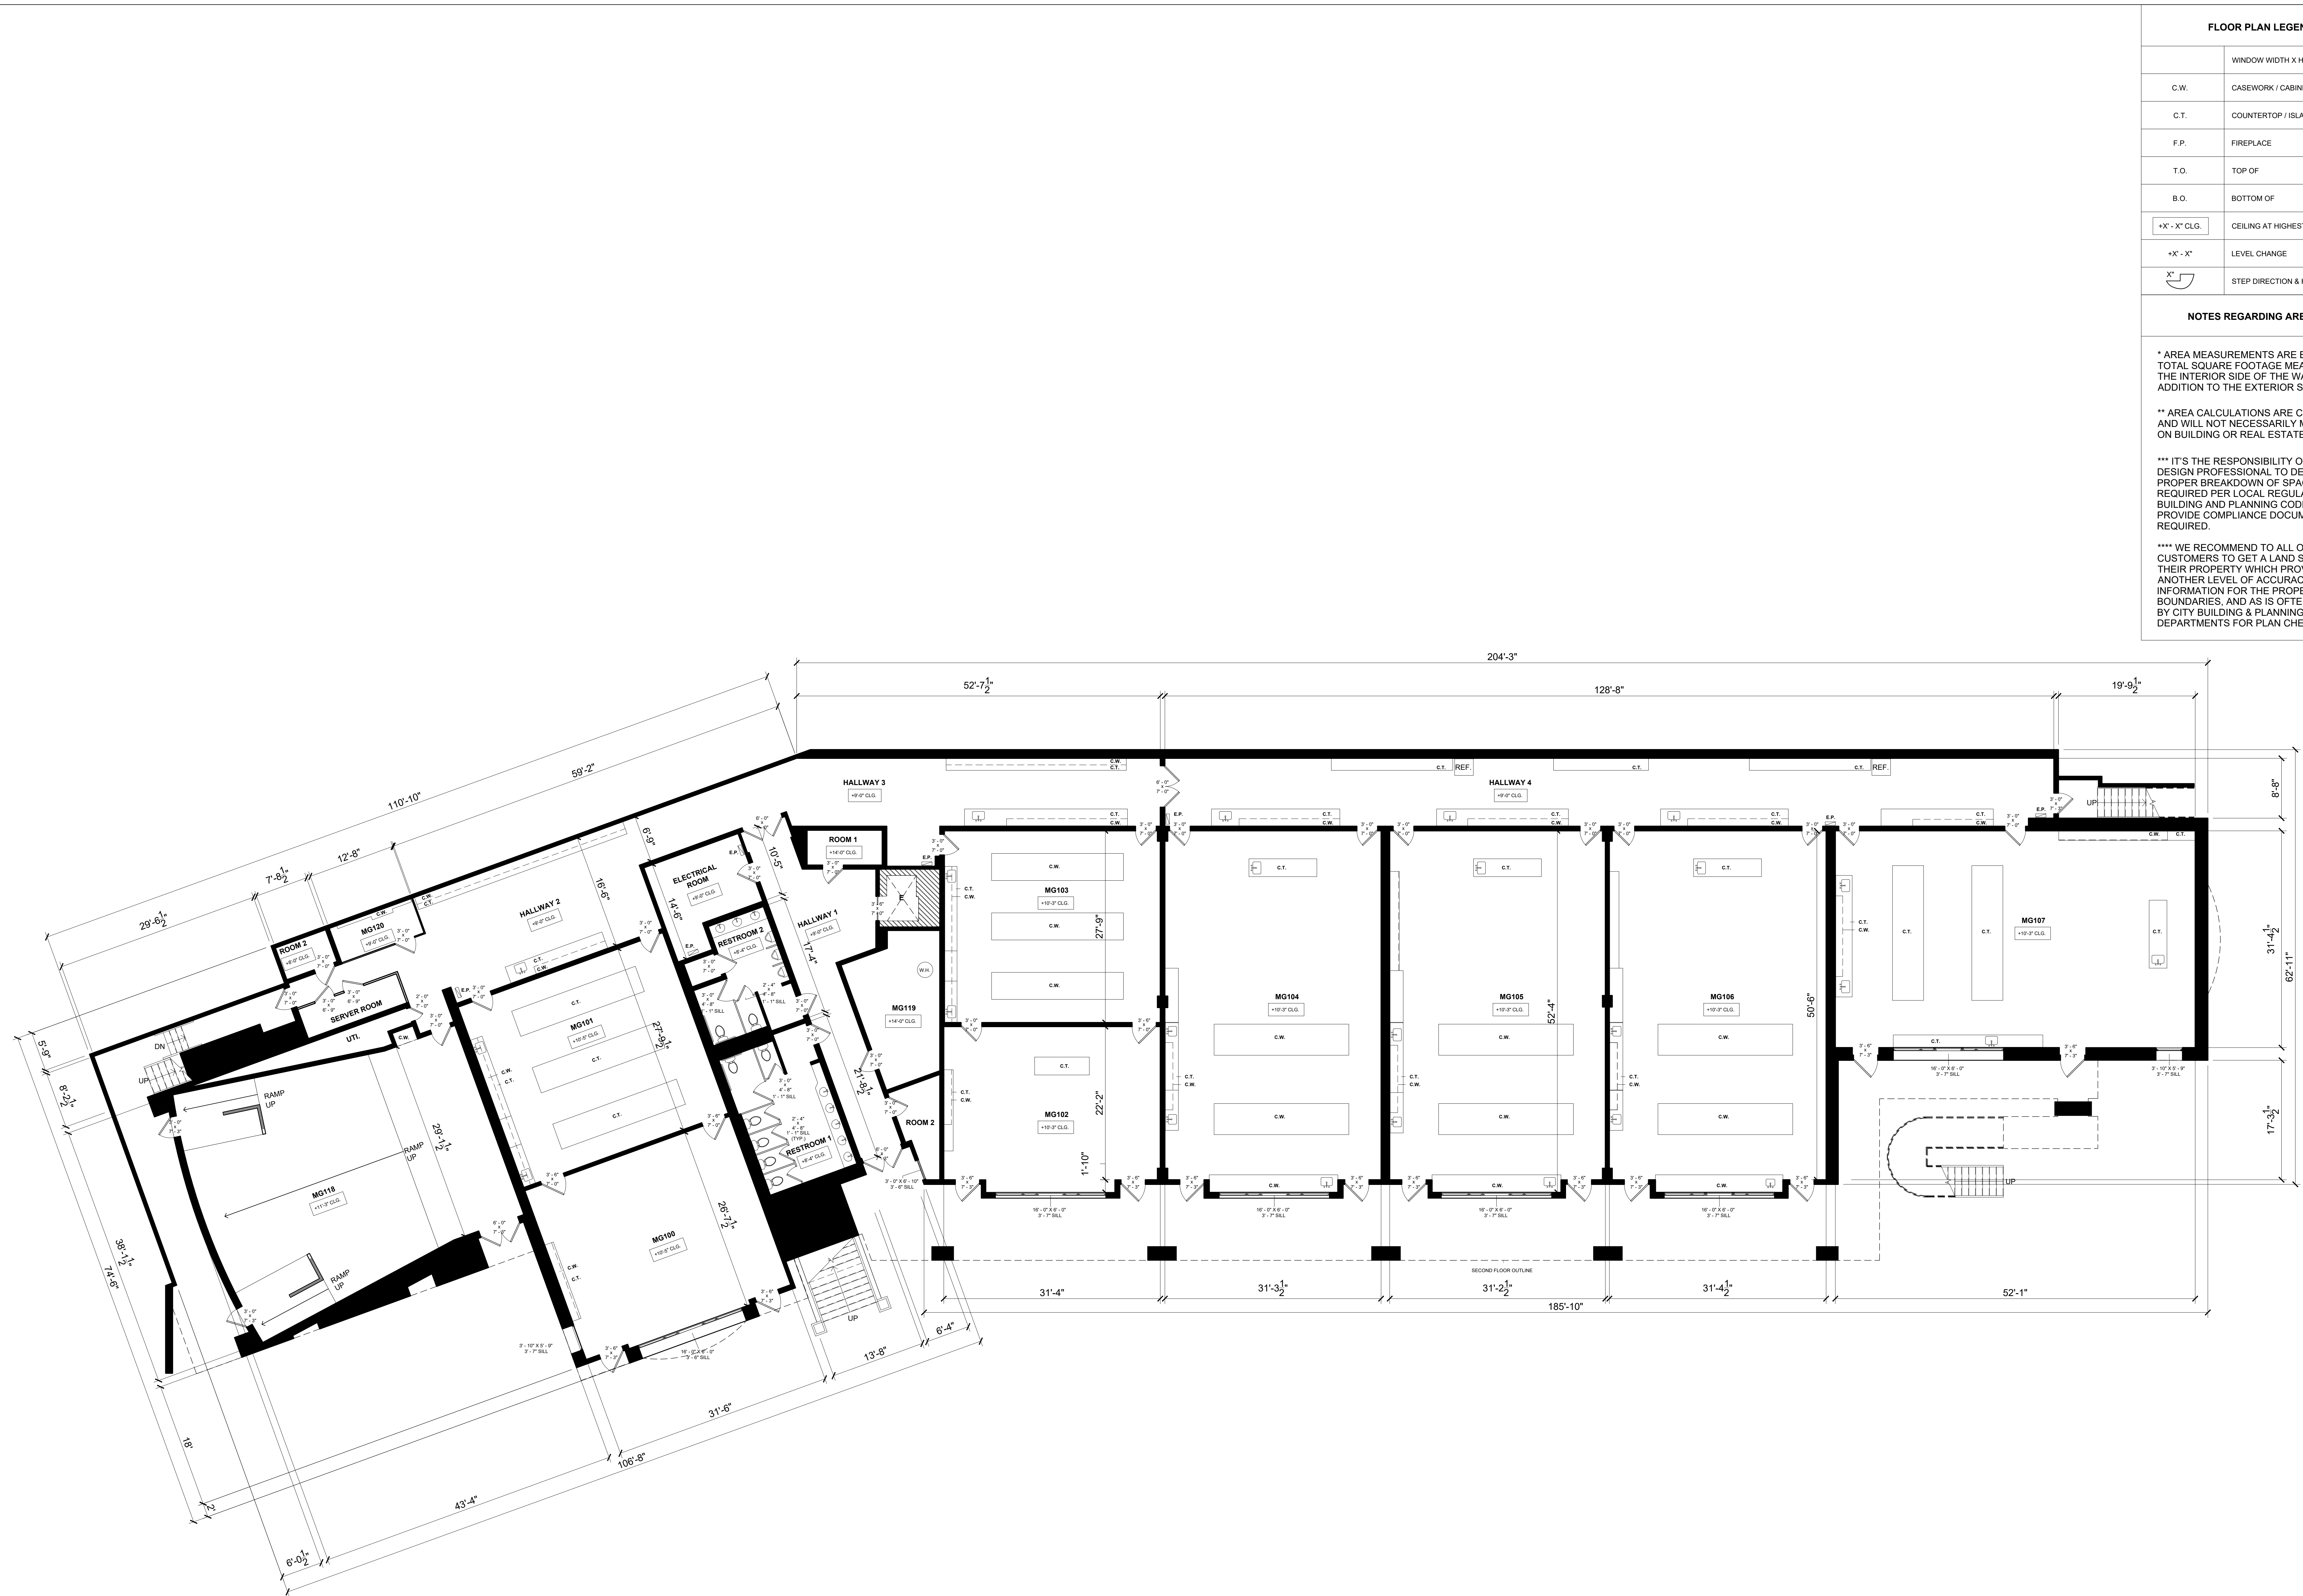

1 MUNGER SCIENCE CENTER + AHMANSON LECTURE HALL - EXISTING 1ST FLOOR
1/8" = 1'-0"

FLOOR PLAN LEGEND	
	WINDOW WIDTH X HEIGHT - SILL HEIGHT
C.W.	CASEWORK / CABINETRY / BUILT-INS
C.T.	COUNTERTOP / ISLAND
F.P.	FIREPLACE
T.O.	TOP OF
B.O.	BOTTOM OF
+X' - X" CLG.	CEILING AT HIGHEST POINT
+X' - X"	LEVEL CHANGE
X"	STEP DIRECTION & HEIGHT

NOTES REGARDING AREA SIZING

* AREA MEASUREMENTS ARE BASED ON TOTAL SQUARE FOOTAGE MEASURED FROM THE INTERIOR SIDE OF THE WALLS IN ADDITION TO THE EXTERIOR SIDE OF WALLS.

** AREA CALCULATIONS ARE COMPLIMENTARY AND WILL NOT NECESSARILY MATCH WHAT IS ON BUILDING OR REAL ESTATE RECORDS.

*** IT'S THE RESPONSIBILITY OF THE PROJECT DESIGN PROFESSIONAL TO DETERMINE THE PROPER BREAKDOWN OF SPACES SIZES AS REQUIRED PER LOCAL REGULATIONS, BUILDING AND PLANNING CODES AND PROVIDE COMPLIANCE DOCUMENTATION AS REQUIRED.

**** WE RECOMMEND TO ALL OUR CUSTOMERS TO GET A LAND SURVEY OF THEIR PROPERTY WHICH PROVIDES ANOTHER LEVEL OF ACCURACY, SIZING INFORMATION FOR THE PROPERTY, BOUNDARIES, AND AS IS OFTEN REQUIRED BY CITY BUILDING & PLANNING DEPARTMENTS FOR PLAN CHECK REVIEWS.

DRAWN BY:

CHECKED BY:

DATE:

PROJECT ID:

SHEET SIZE:

R.C.M.

F.P.S.

01/09/2026

4578

48" X 36"

SCOPE OF WORK

As Built Set

HARVARD

WESTLAKE

SCHOOL

A

B

L

A

AS BUILT LA
21255 BURBANK BLVD, STE 120
WOODLAND HILLS, CA 91367
WWW.ASBUILT.LA.COM
INFO@ASBUILT.LA.COM
(818)-208-3616

AREA CALCULATIONS	
Existing Residence - Interior - 1st Floor	16,310 SF
Existing Residence - Exterior - 1st Floor	17,250 SF
Existing Residence - Interior - 2nd Floor	13,800 SF
Existing Residence - Exterior - 2nd Floor	15,010 SF
MG100	830 SF
MG101	875 SF
MG102	728 SF
MG103	865 SF
MG104	1,612 SF
MG105	1,608 SF
MG106	1,616 SF
MG107	1,642 SF
MG108	1,571 SF
MG109	1,615 SF
MG110	725 SF
MG111	845 SF
MG112	725 SF
MG113	845 SF
MG114	725 SF
MG115	845 SF
MG116	845 SF
MG117	775 SF
MG118	1,407 SF
MG119	235 SF
MG120	67 SF
MG121	1,721 SF
Hallway 1	426 SF
Hallway 2 & 3	1,400 SF
Hallway 4	260 SF
Hallway 5	444 SF
Hallway 6	1,224 SF
-	
-	
-	
-	

PROJECT ADDRESS:

3700 Coldwater Canyon Ave.
Los Angeles, CA 91604

SHEET TITLE:


Munger Science Center
Floor Plans

SCALE:

AS NOTED

SHEET NUMBER:

AB-100

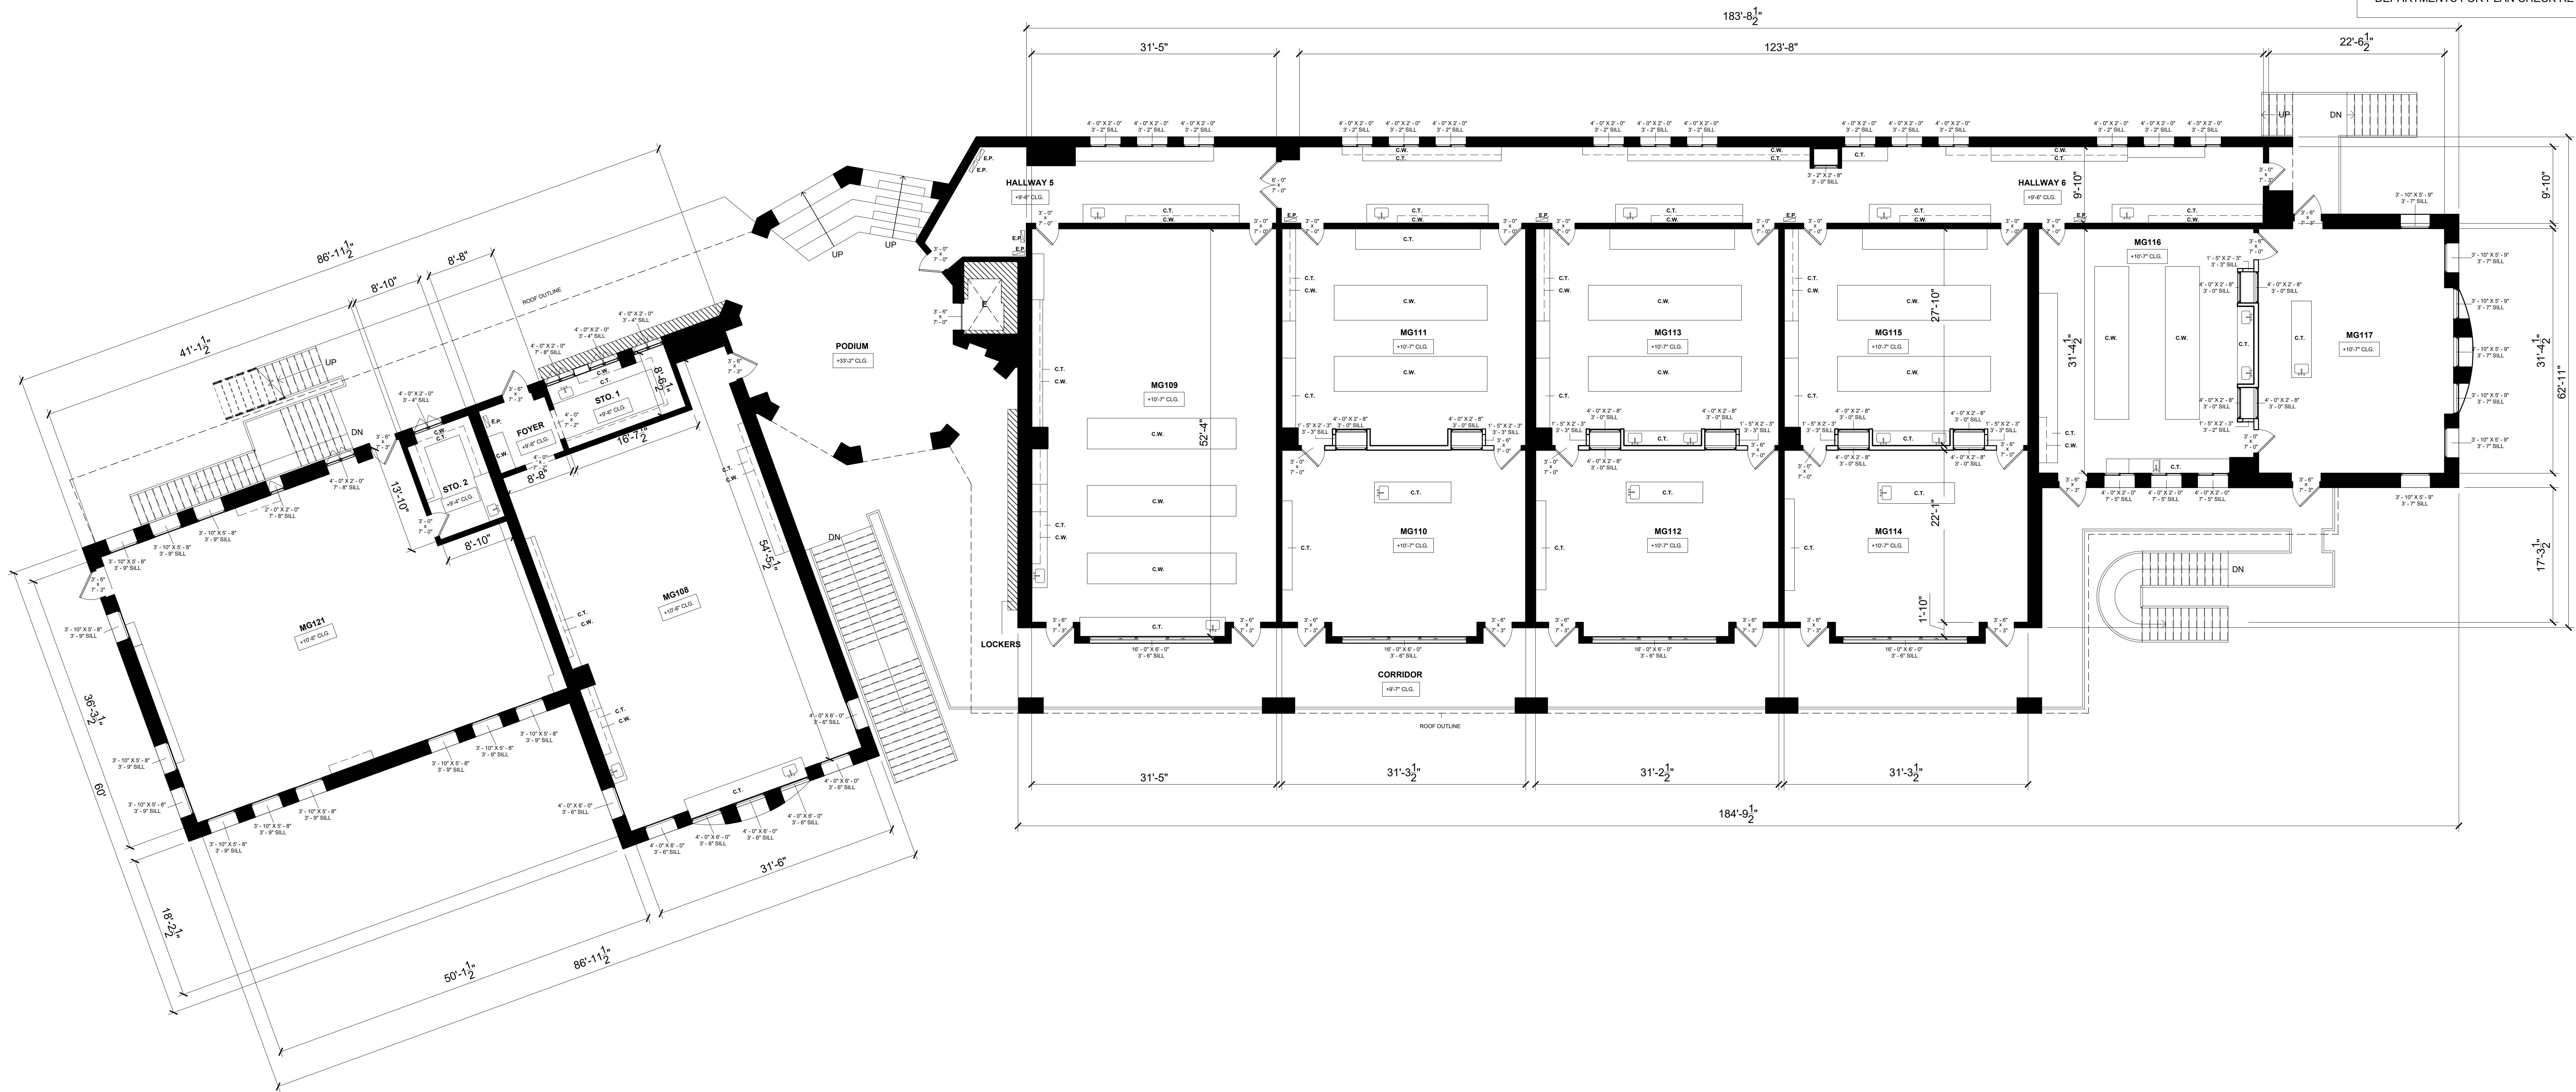

1 MUNGER SCIENCE CENTER + AHMANSON LECTURE HALL - EXISTING 2ND FLOOR
1/8" = 1'-0"

FLOOR PLAN LEGEND	
	WINDOW WIDTH X HEIGHT - SILL HEIGHT
C.W.	CASEWORK / CABINETRY / BUILT-INS
C.T.	COUNTERTOP / ISLAND
F.P.	FIREPLACE
T.O.	TOP OF
B.O.	BOTTOM OF
+X' - X' CLG.	CEILING AT HIGHEST POINT
+X' - X'	LEVEL CHANGE
	STEP DIRECTION & HEIGHT

NOTES REGARDING AREA SIZING	
* AREA MEASUREMENTS ARE BASED ON TOTAL SQUARE FOOTAGE MEASURED FROM THE INTERIOR SIDE OF THE WALLS IN ADDITION TO THE EXTERIOR SIDE OF WALLS.	
** AREA CALCULATIONS ARE COMPLIMENTARY AND WILL NOT NECESSARILY MATCH WHAT IS ON BUILDING OR REAL ESTATE RECORDS.	
*** IT'S THE RESPONSIBILITY OF THE PROJECT DESIGN PROFESSIONAL TO DETERMINE THE PROPER BREAKDOWN OF SPACES SIZES AS REQUIRED PER LOCAL REGULATIONS. BUILDING AND PLANNING CODES AND PROVIDE COMPLIANCE DOCUMENTATION AS REQUIRED.	
**** WE RECOMMEND TO ALL OUR CUSTOMERS TO GET A LAND SURVEY OF THEIR PROPERTY WHICH PROVIDES ANOTHER LEVEL OF ACCURACY. SIZING INFORMATION FOR THE PROPERTY. BOUNDARIES, AND AS IS OFTEN REQUIRED BY CITY BUILDING & PLANNING DEPARTMENTS FOR PLAN CHECK REVIEWS.	

HARVARD
WESTLAKE
SCHOOL

A
B
L
A

AS BUILT LA
21255 BURBANK BLVD, STE 120
WOODLAND HILLS, CA 91367
WWW.ASBUILT.LA.COM
INFO@ASBUILT.LA.COM
(818)-208-3616

DRAWN BY:	R.C.M.
CHECKED BY:	F.P.S.
DATE:	01/09/2026
PROJECT ID	4578
SHEET SIZE	48" X 36"

SCOPE OF WORK	
As Built Set	

AREA CALCULATIONS	
Existing Residence - Interior - 1st Floor	16,310 SF
Existing Residence - Exterior - 1st Floor	17,250 SF
Existing Residence - Interior - 2nd Floor	13,800 SF
Existing Residence - Exterior - 2nd Floor	15,010 SF
MG100	830 SF
MG101	875 SF
MG102	728 SF
MG103	865 SF
MG104	1,612 SF
MG105	1,608 SF
MG106	1,616 SF
MG107	1,642 SF
MG108	1,571 SF
MG109	1,615 SF
MG110	725 SF
MG111	845 SF
MG112	725 SF
MG113	845 SF
MG114	725 SF
MG115	845 SF
MG116	845 SF
MG117	775 SF
MG118	1,407 SF
MG119	235 SF
MG120	67 SF
MG121	1,721 SF
Hallway 1	426 SF
Hallway 2 & 3	1,400 SF
Hallway 4	260 SF
Hallway 5	444 SF
Hallway 6	1,224 SF
-	
-	
-	
-	


PROJECT ADDRESS:	
3700 Coldwater Canyon Ave. Los Angeles, CA 91604	
SHEET TITLE:	
Floor Plans	
SCALE:	AS NOTED
SHEET NUMBER:	AB-101

AS BUILT LA
21255 BURBANK BLVD, STE 120
WOODLAND HILLS, CA 91367
WWW.ASBUILT.LA.COM
INFO@ASBUILT.LA.COM
(818)-208-3616

REQUIRED PER LOCAL REGULATIONS,
BUILDING AND PLANNING CODES AND
PROVIDE COMPLIANCE DOCUMENTATION AS

*** IT'S THE RESPONSIBILITY OF THE PROJECT DESIGN PROFESSIONAL TO DETERMINE THE PROPER BREAKDOWN OF SPACES SIZES AS REQUIRED PER LOCAL REGULATIONS, BUILDING AND PLANNING CODES AND PROVIDE COMPLIANCE DOCUMENTATION AS REQUIRED.

DEPARTMENTS FOR FLAIN CHECK REVIEWS.	
--------------------------------------	--

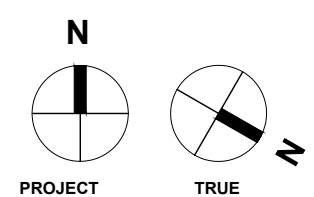

① CHALMERS
3/16" = 1'-0"

**HARVARD
WESTLAKE
SCHOOL**



AS BUILT LA
21255 BULFUNK BLVD, STE 120
WOODLAND HILLS, CA 91367
WWW.ASBUILT.LA.COM
INFO@ASBUILT.LA.COM
(818)-208-3616

SCOPE OF WORK	
As Built Set	

PROJECT ADDRESS:	
3700 Coldwater Canyon Ave. Los Angeles, CA 91604	
SHEET TITLE:	
Chalmers Building Floor Plans	
SCALE:	AS NOTED
SHEET NUMBER:	AB-103



**HARVARD
WESTLAKE
SCHOOL**




AS BUILT LA
21255 BULFUNK BLVD, STE 120
WOODLAND HILLS, CA 91367
WWW.ASBUILT.LA.COM
INFO@ASBUILT.LA.COM
(818)-208-3616

PROJECT ADDRESS:


3700 Coldwater Canyon Ave. Los Angeles, CA 91604

SCALE:	AS NOTED
SHEET NUMBER:	AB-104



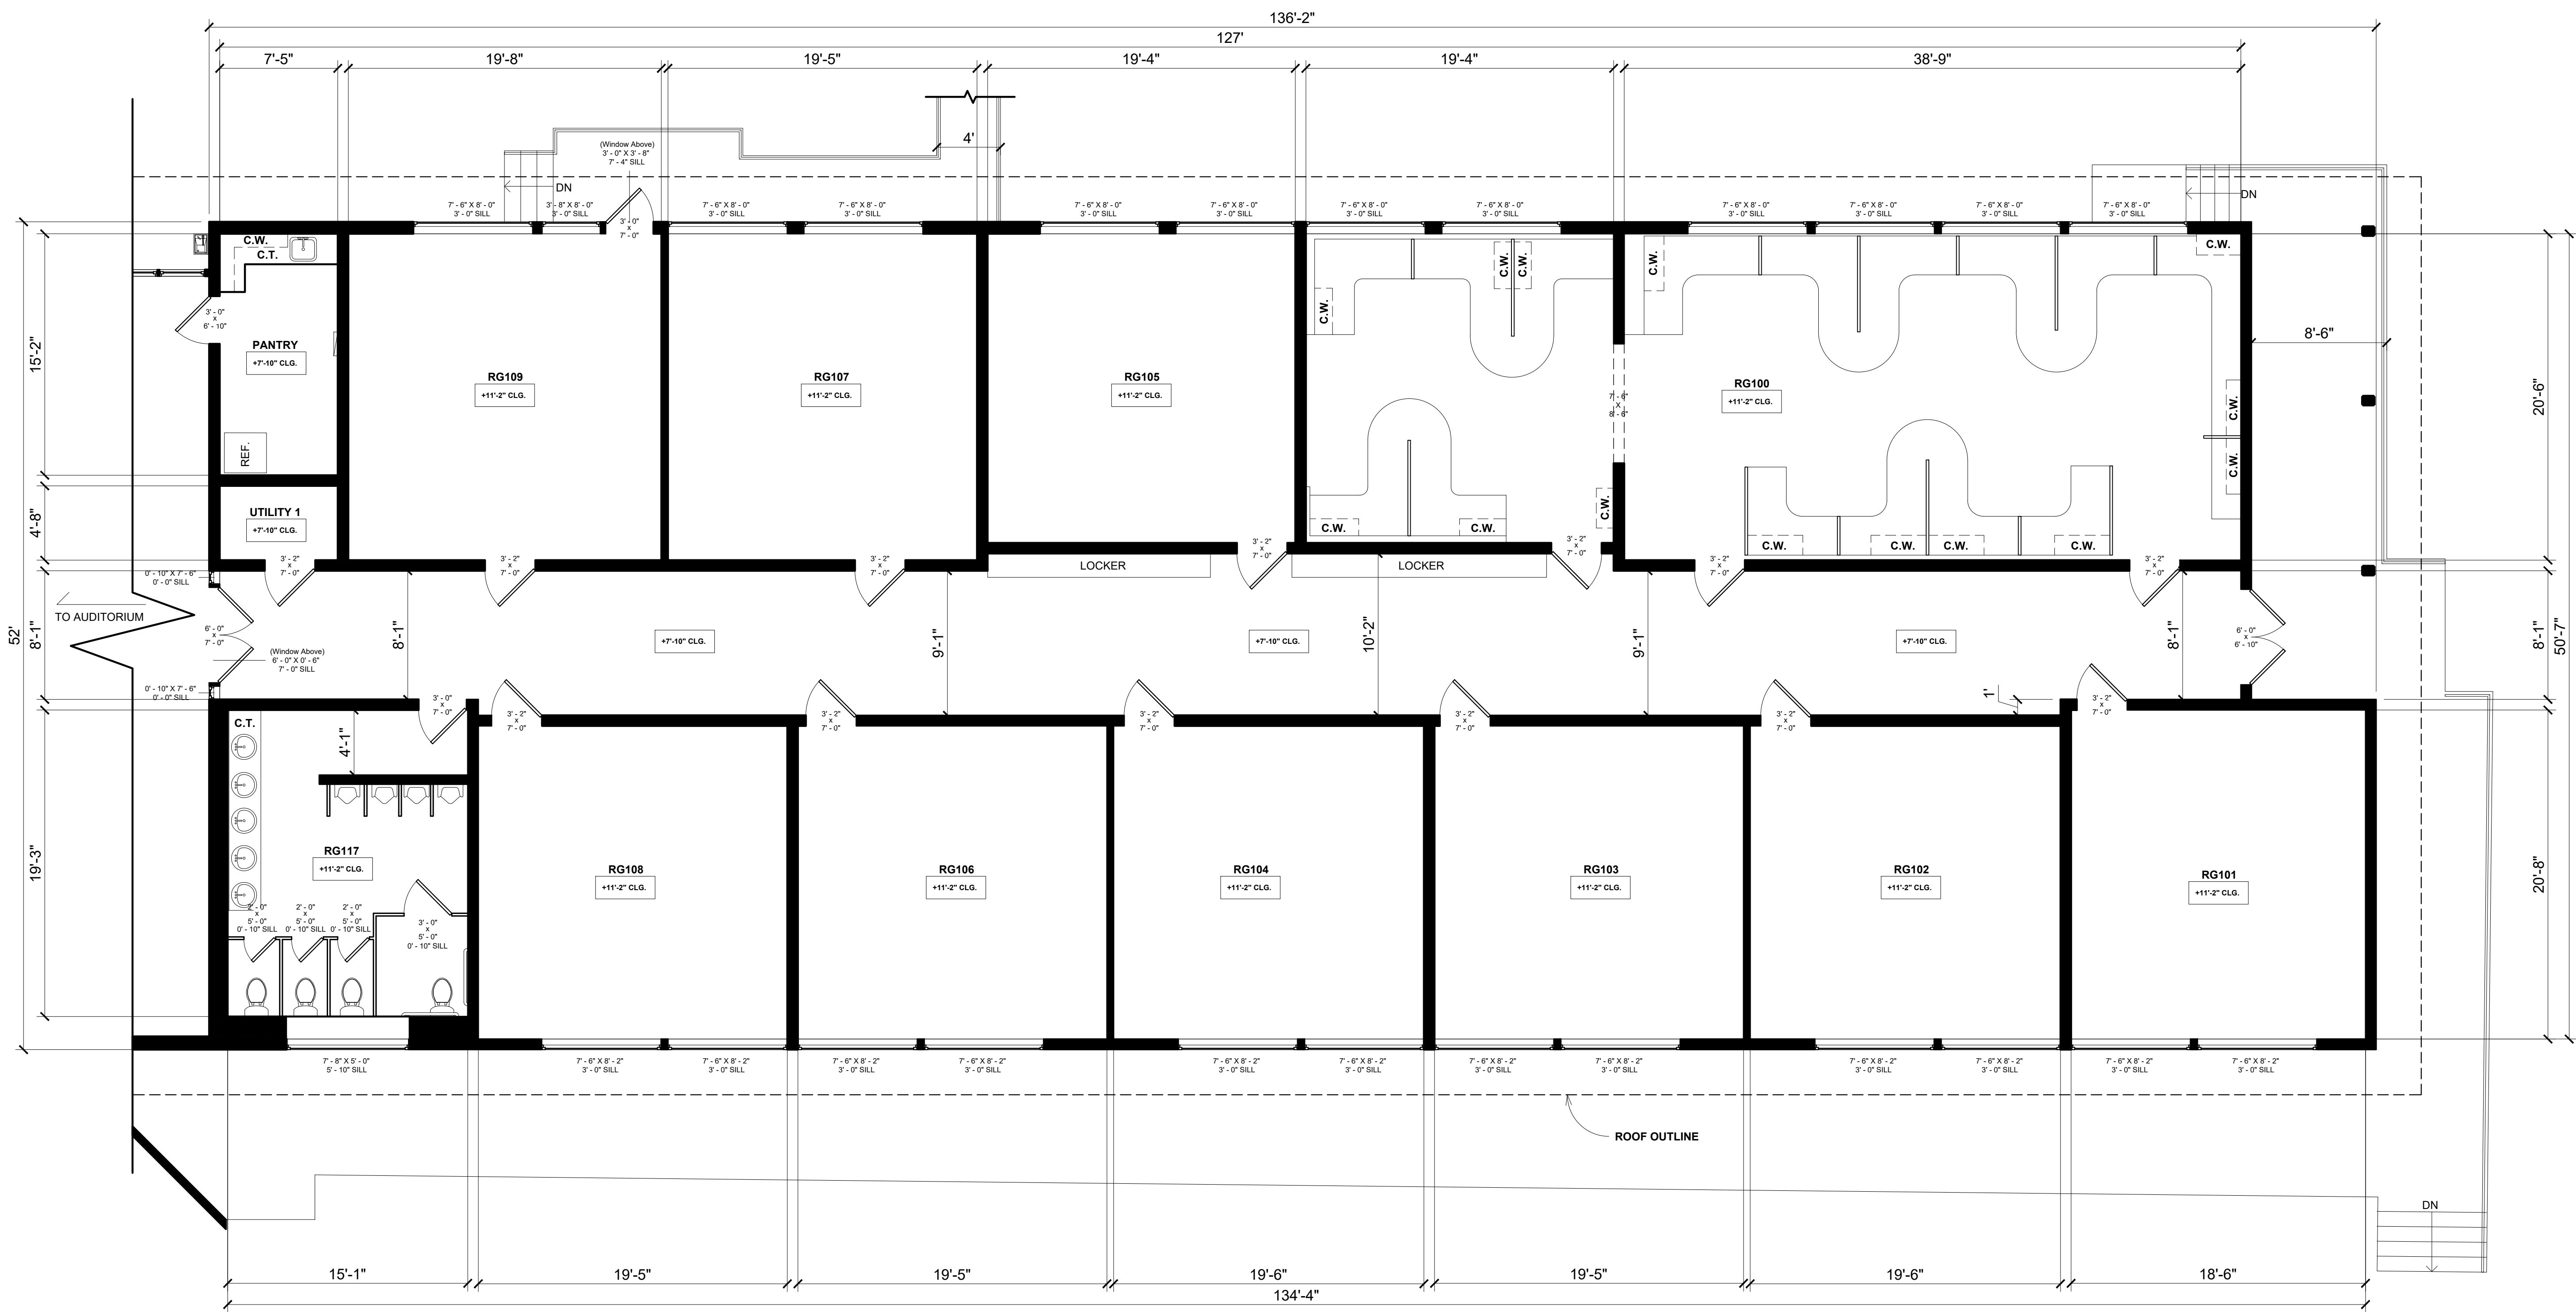

1 RUGBY BUILDING (CLASSROOMS) - EXISTING 1ST FLOOR PLAN
3/16" = 1'-0"

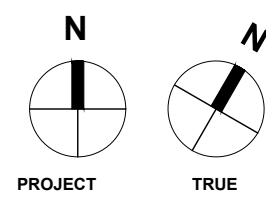

FLOOR PLAN LEGEND	
	WINDOW WIDTH X HEIGHT - SILL HEIGHT
C.W.	CASEWORK / CABINETRY / BUILT-INS
C.T.	COUNTERTOP / ISLAND
F.P.	FIREPLACE
T.O.	TOP OF
B.O.	BOTTOM OF
+X' - X' CLG.	CEILING AT HIGHEST POINT
+X' - X'	LEVEL CHANGE
X'	STEP DIRECTION & HEIGHT

HARVARD
WESTLAKE
SCHOOL

ABLA

AS BUILT LA
21255 BURBANK BLVD, STE 120
WOODLAND HILLS, CA 91367
WWW.ASBUILT.LA.COM
INFO@ASBUILT.LA.COM
(818)-208-3616

NOTES REGARDING AREA SIZING * AREA MEASUREMENTS ARE BASED ON TOTAL SQUARE FOOTAGE MEASURED FROM THE INTERIOR SIDE OF THE WALLS IN ADDITION TO THE EXTERIOR SIDE OF WALLS. ** AREA CALCULATIONS ARE COMPLIMENTARY AND WILL NOT NECESSARILY MATCH WHAT IS ON BUILDING OR REAL ESTATE RECORDS. *** IT'S THE RESPONSIBILITY OF THE PROJECT DESIGN PROFESSIONAL TO DETERMINE THE PROPER BREAKDOWN OF SPACES SIZES AS REQUIRED PER LOCAL REGULATIONS, BUILDING AND PLANNING CODES AND PROVIDE COMPLIANCE DOCUMENTATION AS REQUIRED. **** WE RECOMMEND TO ALL OUR CUSTOMERS TO GET A LAND SURVEY OF THEIR PROPERTY WHICH PROVIDES ANOTHER LEVEL OF ACCURACY, SIZING INFORMATION FOR THE PROPERTY, BOUNDARIES, AND AS IS OFTEN REQUIRED BY CITY BUILDING & PLANNING DEPARTMENTS FOR PLAN CHECK REVIEWS.	DRAWN BY:	E.P.
	CHECKED BY:	N.D.B.
	DATE:	01/09/2026
	PROJECT ID	4578
	SHEET SIZE	48" X 36"
SCOPE OF WORK As Built Set	DELIVERABLES	2D CAD & PDF

AREA CALCULATIONS

RG100	1183 SF
RG101	362 SF
RG102	383 SF
RG103	382 SF
RG104	383 SF
RG105	375 SF
RG106	362 SF
RG107	398 SF
RG108	382 SF
RG109	403 SF
RG110	895 SF
RG111	3129 SF
RG112	1408 SF
RG113	404 SF
RG114	488 SF
RG115	104 SF
RG116	104 SF
RG117	300 SF
RG118	236 SF
RG119	999 SF
Existing Auditorium Basement - Interior	2573 SF
Existing Classroom Bldg. - Exterior	6586 SF
Existing Auditorium 1ST FLR - Exterior	7311 SF
Existing Auditorium 2ND FLR - Exterior	7311 SF

PROJECT ADDRESS:



3700 Coldwater Canyon Ave. Los Angeles, CA 91604

SHEET TITLE:

Rugby Building Floor Plans

SCALE: AS NOTED

SHEET NUMBER: AB-105

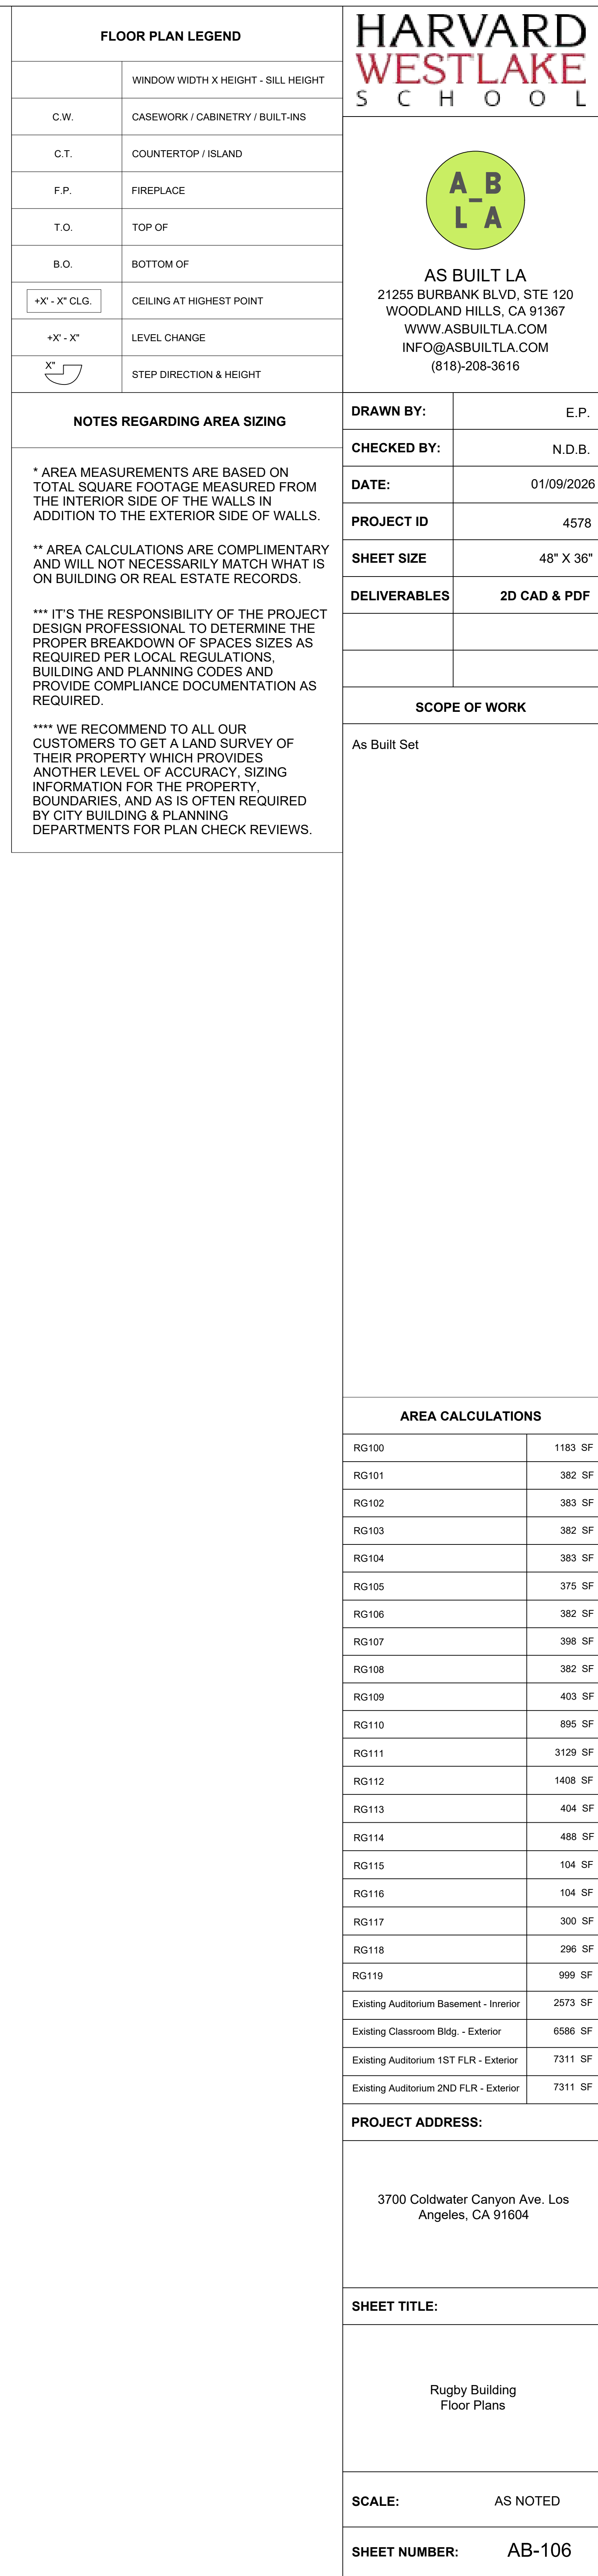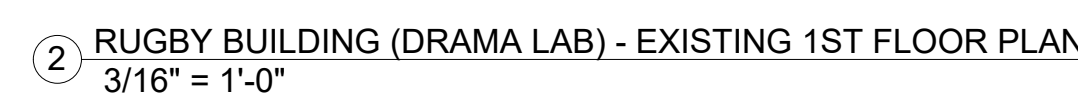

AS BUILT LA
21255 BURBANK BLVD, STE 120
WOODLAND HILLS, CA 91367
WWW.ASBUILT.LA.COM
INFO@ASBUILT.LA.COM
(818)-208-3616

DRAWN BY:	E.P
CHECKED BY:	N.D.B

DATE:	01/09/2022
PROJECT ID	4578

SHEET SIZE	48" X 36"

DELIVERABLES	2D CAD & PDF

SCORE OF WORK

SCOPE OF WORK

As Built Set

RG100	1183	8
RG101	382	8
RG102	383	8
RG103	382	8
RG104	383	8
RG105	375	8
RG106	382	8
RG107	398	8
RG108	382	8
RG109	403	8
RG110	895	8
RG111	3129	8
RG112	1408	8
RG113	404	8
RG114	488	8
RG115	104	8
RG116	104	8
RG117	300	8
RG118	296	8
RG119	999	8
Existing Auditorium Basement - Interior	2573	8
Existing Classroom Bldg. - Exterior	6586	8
Existing Auditorium 1ST FLR - Exterior	7311	8
Existing Auditorium 2ND FLR - Exterior	7311	8

PROJECT ADDRESS:


3700 Coldwater Canyon Ave. Los
Angeles, CA 91604

SHEET TITLE:


Rugby Building
Floor Plans

SCALE: AS NOTED


SHEET NUMBER: AB-107

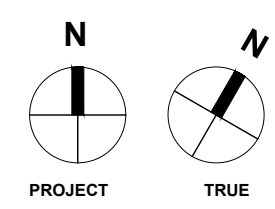


1 RUGBY BUILDING (AUDITORIUM) - EXISTING 1ST FLOOR PLAN
3/16" = 1'-0"

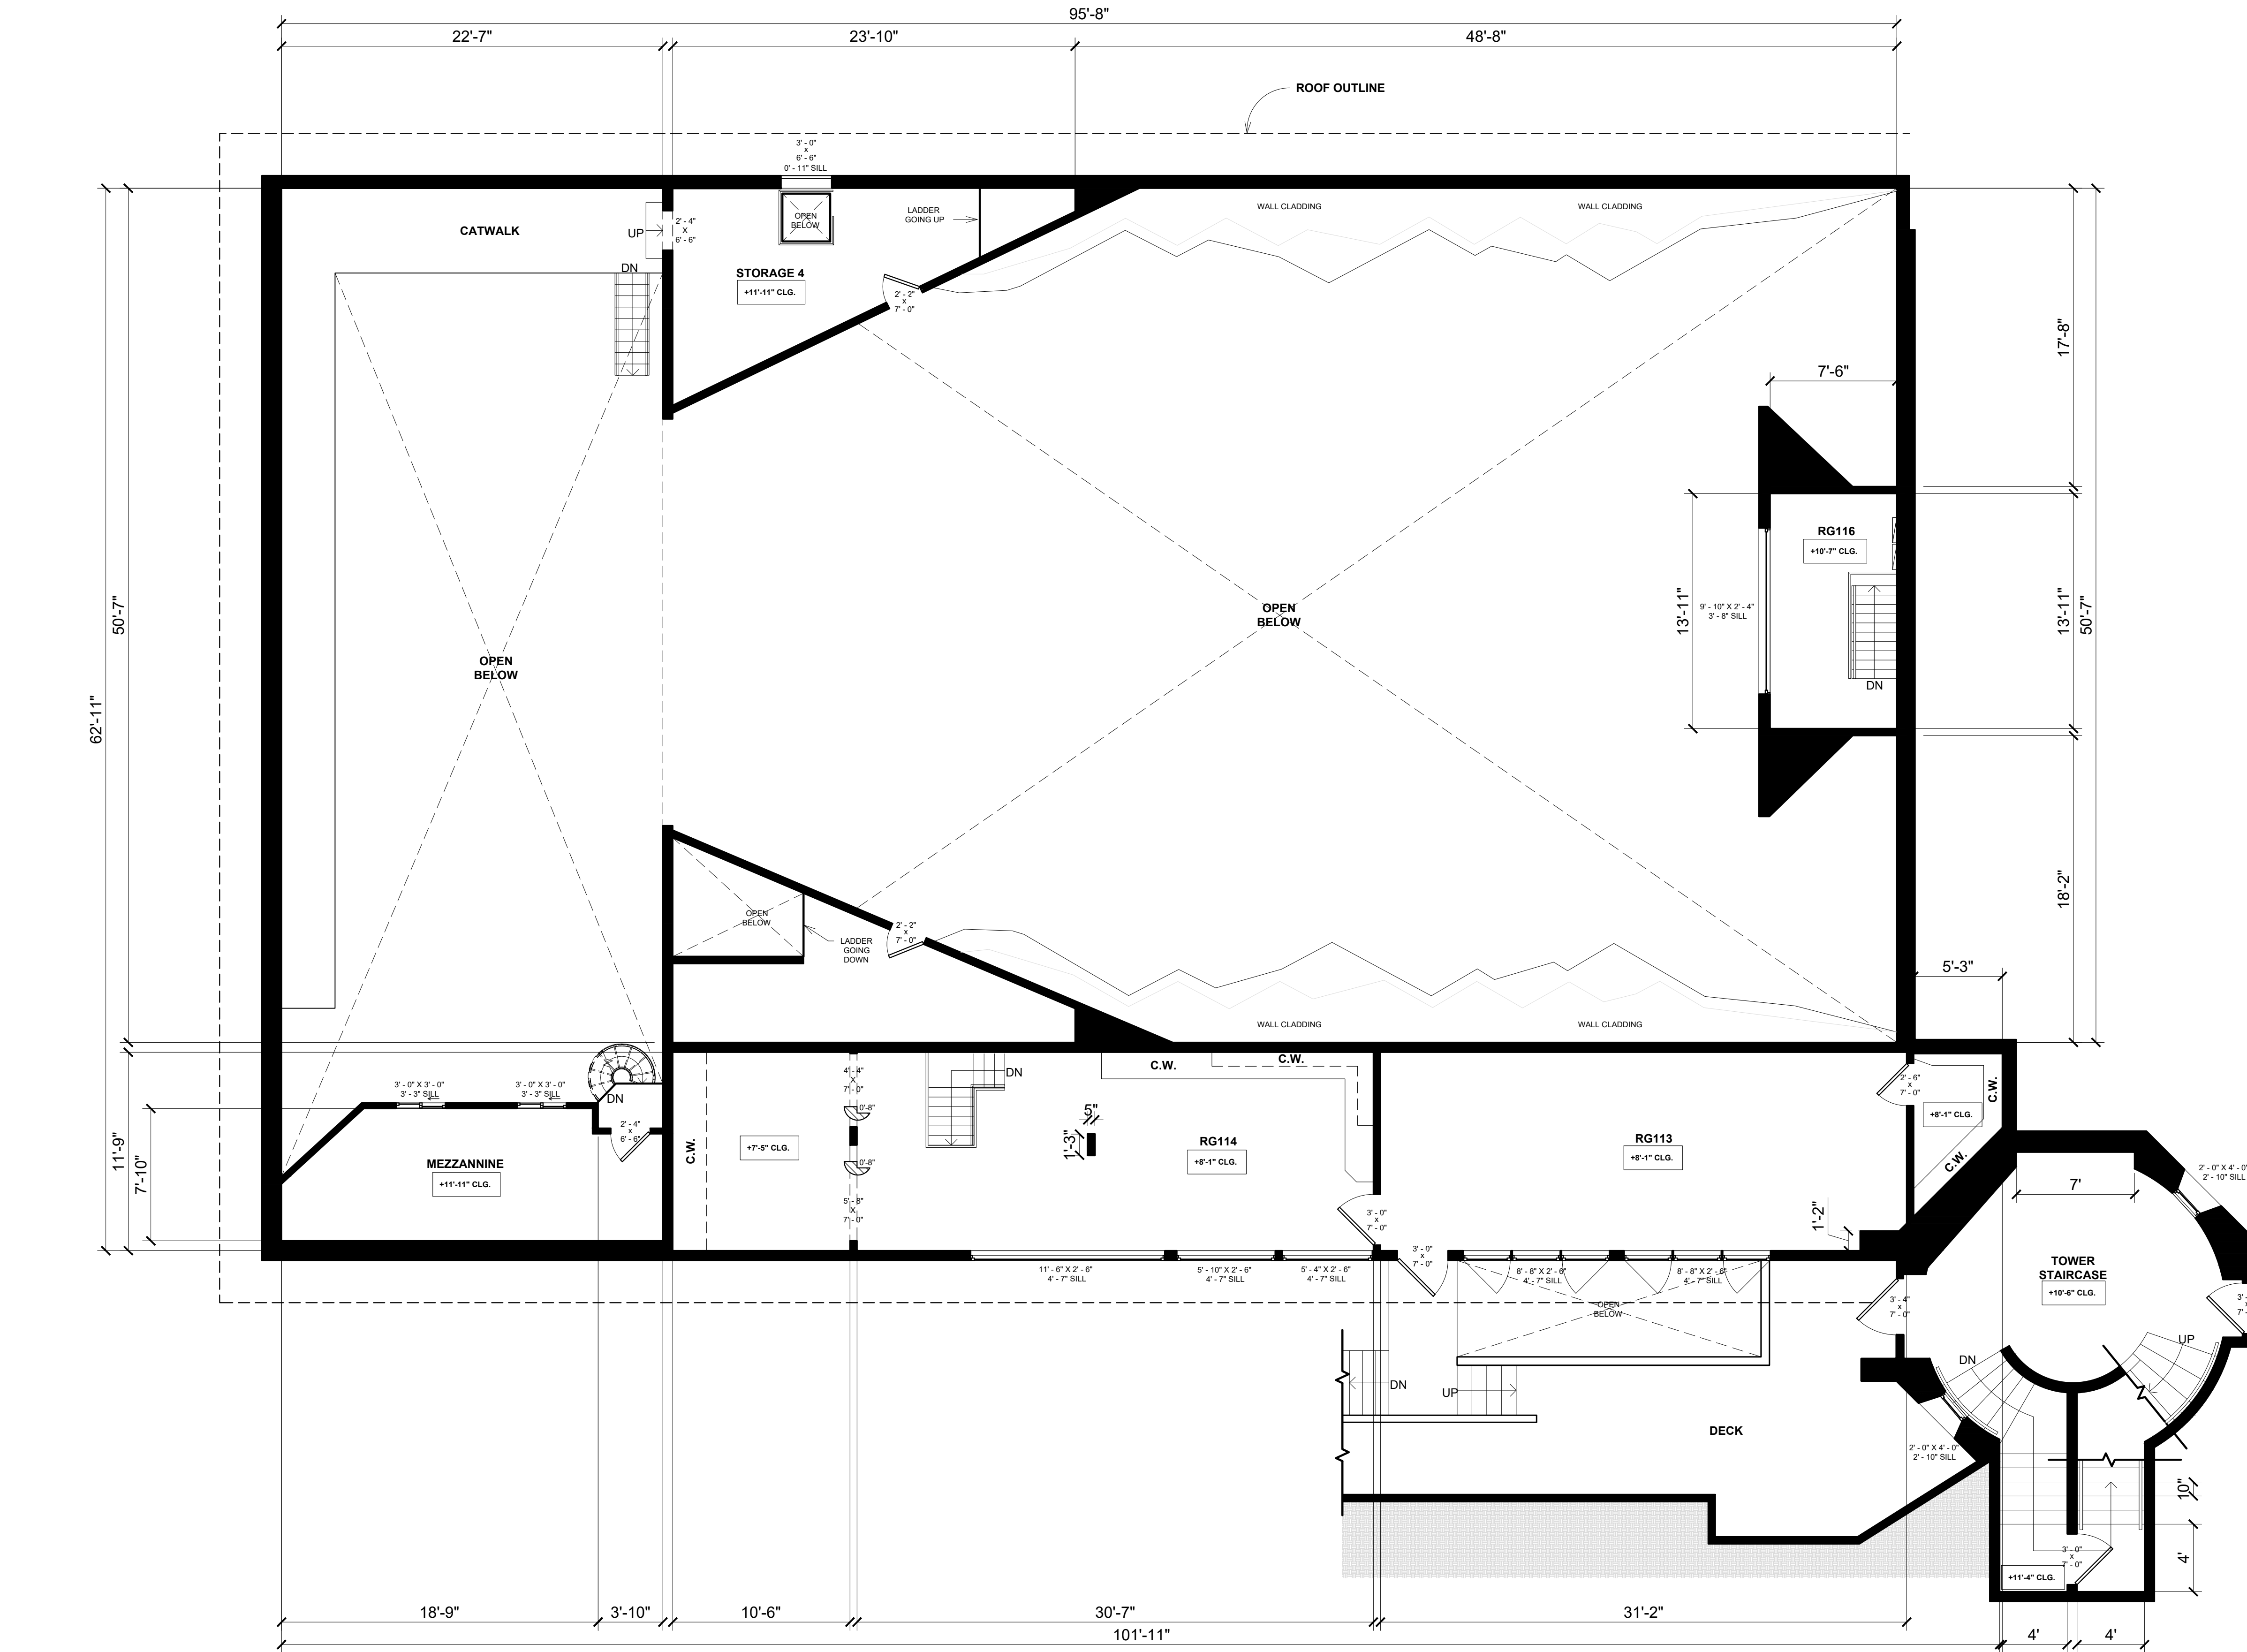

1 RUGBY BUILDING (AUDITORIUM) - EXISTING 2ND FLOOR PLAN
3/16" = 1'-0"

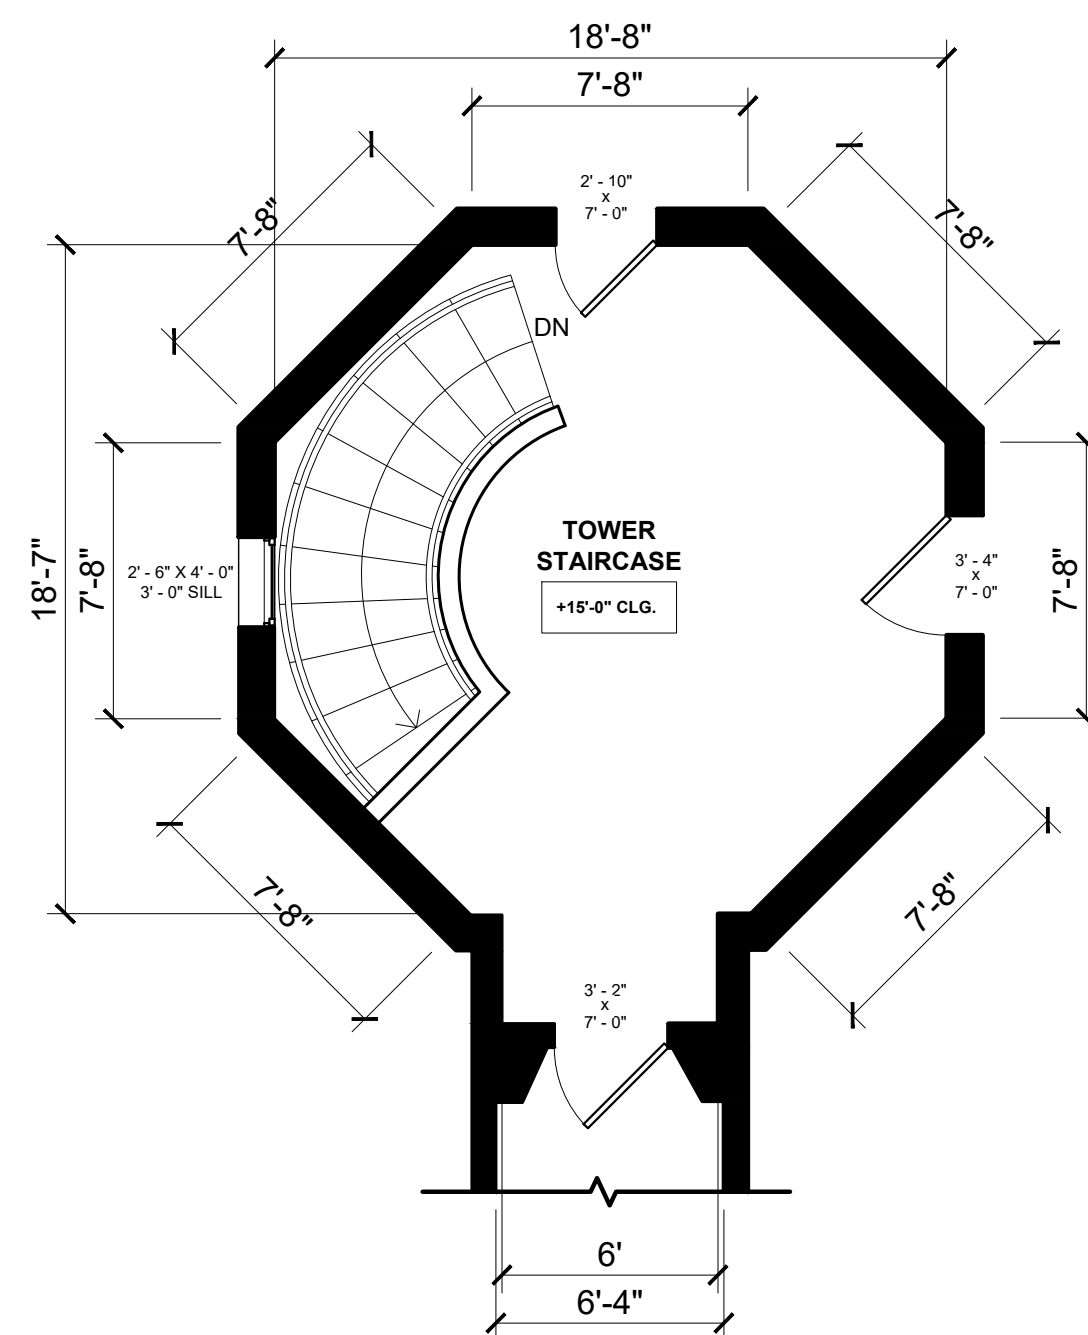

2 RUGBY BUILDING (TOWER STAIRCASE) - EXISTING 3RD FLOOR PLAN
3/16" = 1'-0"

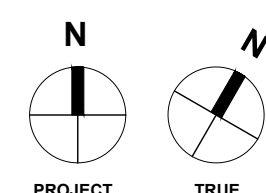

FLOOR PLAN LEGEND	
	WINDOW WIDTH X HEIGHT - SILL HEIGHT
C.W.	CASEWORK / CABINETRY / BUILT-INS
C.T.	COUNTERTOP / ISLAND
F.P.	FIREPLACE
T.O.	TOP OF
B.O.	BOTTOM OF
+X' - X' CLG.	CEILING AT HIGHEST POINT
+X' - X'	LEVEL CHANGE
X'	STEP DIRECTION & HEIGHT

HARVARD
WESTLAKE
SCHOOL

ABLA

AS BUILT LA
21255 BURBANK BLVD, STE 120
WOODLAND HILLS, CA 91367
WWW.ASBUILT.LA.COM
INFO@ASBUILT.LA.COM
(818)-208-3616

NOTES REGARDING AREA SIZING * AREA MEASUREMENTS ARE BASED ON TOTAL SQUARE FOOTAGE MEASURED FROM THE INTERIOR SIDE OF THE WALLS IN ADDITION TO THE EXTERIOR SIDE OF WALLS. ** AREA CALCULATIONS ARE COMPLEMENTARY AND WILL NOT NECESSARILY MATCH WHAT IS ON BUILDING OR REAL ESTATE RECORDS. *** IT'S THE RESPONSIBILITY OF THE PROJECT DESIGN PROFESSIONAL TO DETERMINE THE PROPER BREAKDOWN OF SPACES SIZES AS REQUIRED PER LOCAL REGULATIONS, BUILDING AND PLANNING CODES AND PROVIDE COMPLIANCE DOCUMENTATION AS REQUIRED. **** WE RECOMMEND TO ALL OUR CUSTOMERS TO GET A LAND SURVEY OF THEIR PROPERTY WHICH PROVIDES ANOTHER LEVEL OF ACCURACY, SIZING INFORMATION FOR THE PROPERTY, BOUNDARIES, AND AS IS OFTEN REQUIRED BY CITY BUILDING & PLANNING DEPARTMENTS FOR PLAN CHECK REVIEWS.	DRAWN BY:	E.P.
	CHECKED BY:	N.D.B.
	DATE:	01/09/2026
	PROJECT ID	4578
	SHEET SIZE	48" X 36"
SCOPE OF WORK As Built Set	DELIVERABLES	2D CAD & PDF

AREA CALCULATIONS

RG100	1183 SF
RG101	362 SF
RG102	383 SF
RG103	382 SF
RG104	383 SF
RG105	375 SF
RG106	362 SF
RG107	398 SF
RG108	382 SF
RG109	403 SF
RG110	895 SF
RG111	3129 SF
RG112	1408 SF
RG113	404 SF
RG114	488 SF
RG115	104 SF
RG116	104 SF
RG117	300 SF
RG118	296 SF
RG119	999 SF
Existing Auditorium Basement - Interior	2573 SF
Existing Classroom Bldg. - Exterior	6586 SF
Existing Auditorium 1ST FLR - Exterior	7311 SF
Existing Auditorium 2ND FLR - Exterior	7311 SF

PROJECT ADDRESS:


3700 Coldwater Canyon Ave. Los Angeles, CA 91604

SHEET TITLE:


Rugby Building Floor Plans

SCALE: AS NOTED

SHEET NUMBER: AB-108

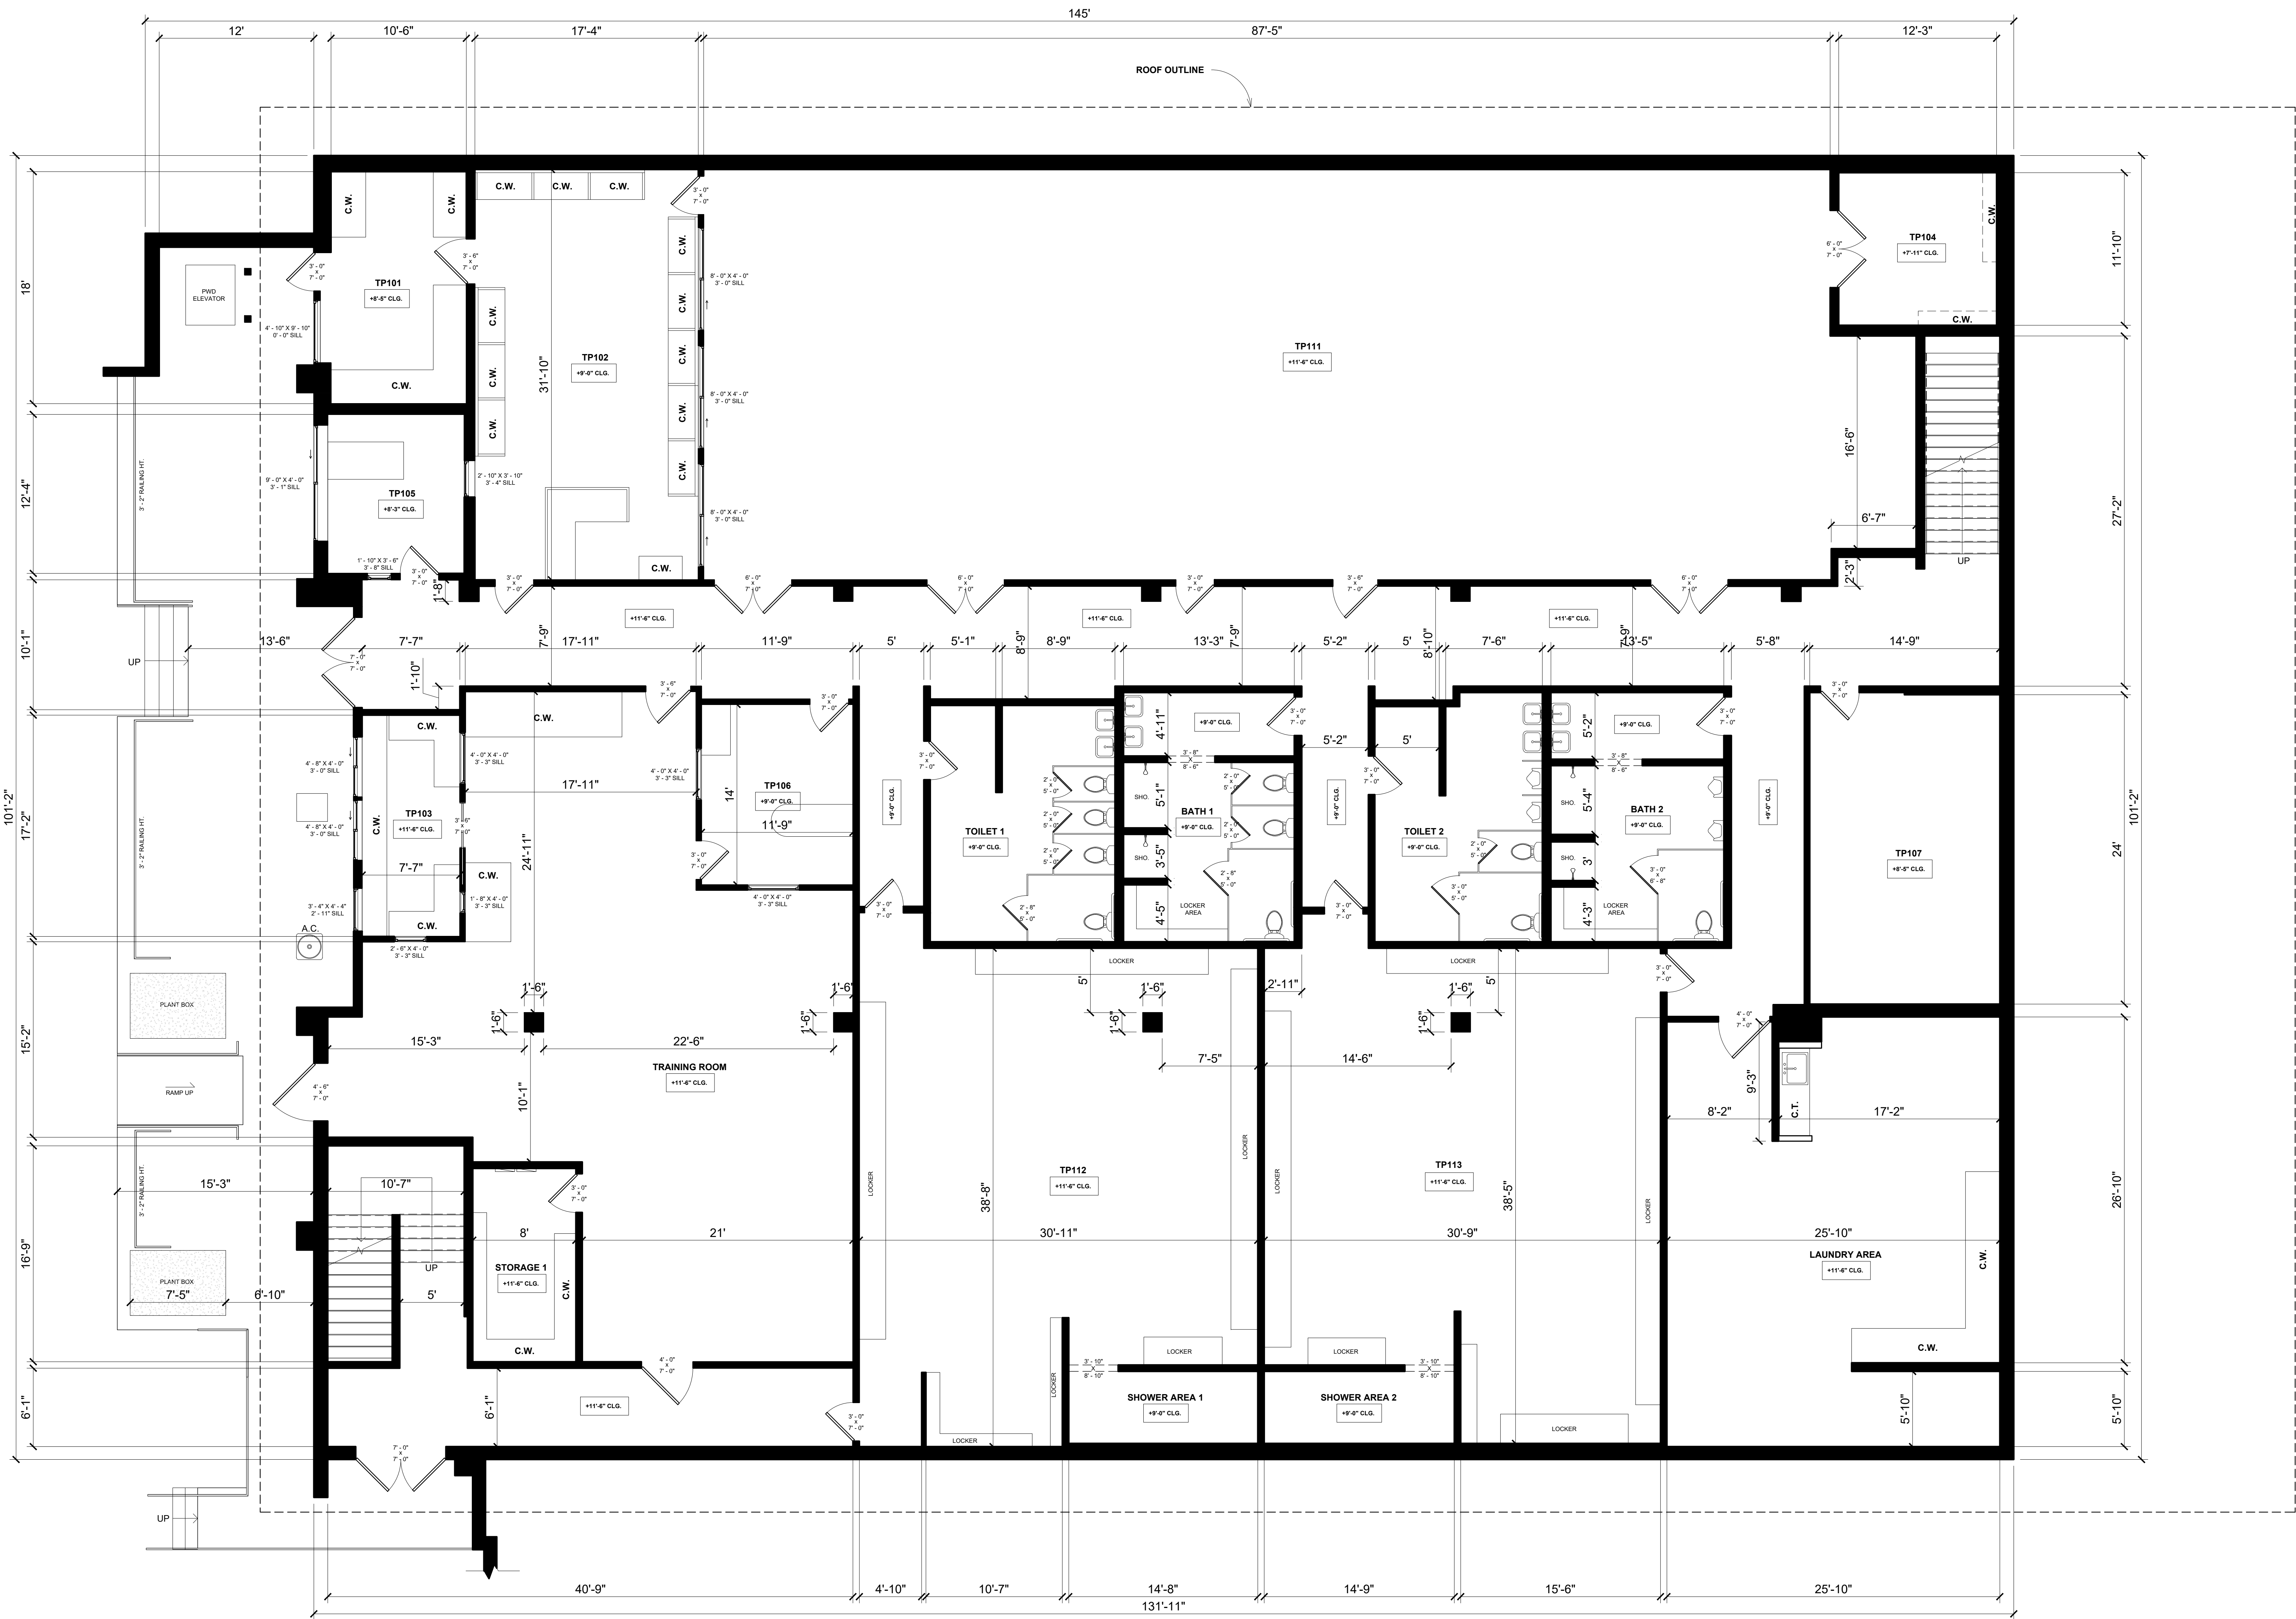


1 TAPER ATHLETIC PAVILLION - EXISTING GROUND FLOOR PLAN
3/16" = 1'-0"

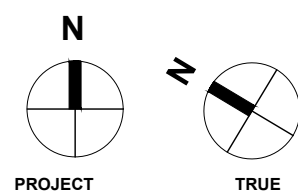

FLOOR PLAN LEGEND	
	WINDOW WIDTH X HEIGHT - SILL HEIGHT
C.W.	CASEWORK / CABINETRY / BUILT-INS
C.T.	COUNTERTOP / ISLAND
F.P.	FIREPLACE
T.O.	TOP OF
B.O.	BOTTOM OF
+X' - X' CLG.	CEILING AT HIGHEST POINT
+X' - X'	LEVEL CHANGE
X'	STEP DIRECTION & HEIGHT
NOTES REGARDING AREA SIZING	
* AREA MEASUREMENTS ARE BASED ON TOTAL SQUARE FOOTAGE MEASURED FROM THE INTERIOR SIDE OF THE WALLS IN ADDITION TO THE EXTERIOR SIDE OF WALLS.	
** AREA CALCULATIONS ARE COMPLIMENTARY AND WILL NOT NECESSARILY MATCH WHAT IS ON BUILDING OR REAL ESTATE RECORDS.	
*** IT'S THE RESPONSIBILITY OF THE PROJECT DESIGN PROFESSIONAL TO DETERMINE THE PROPER BREAKDOWN OF SPACES SIZES AS REQUIRED PER LOCAL REGULATIONS, BUILDING AND PLANNING CODES AND PROVIDE COMPLIANCE DOCUMENTATION AS REQUIRED.	
**** WE RECOMMEND TO ALL OUR CUSTOMERS TO GET A LAND SURVEY OF THEIR PROPERTY WHICH PROVIDES ANOTHER LEVEL OF ACCURACY, SIZING INFORMATION FOR THE PROPERTY, BOUNDARIES, AND AS IS OFTEN REQUIRED BY CITY BUILDING & PLANNING DEPARTMENTS FOR PLAN CHECK REVIEWS.	
DRAWN BY:	E.P.
CHECKED BY:	F.P.S.
DATE:	01/09/2026
PROJECT ID	4578
SHEET SIZE	48" X 36"
	2D CAD & PDF
SCOPE OF WORK	
As Built Set	

HARVARD
WESTLAKE
SCHOOL

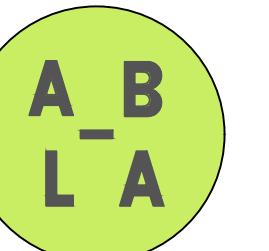

AS BUILT LA
21255 BURBANK BLVD, STE 120
WOODLAND HILLS, CA 91367
WWW.ASBUILTLA.COM
INFO@ASBUILTLA.COM
(818)-208-3616

AREA CALCULATIONS	
TP101	189 SF
TP102	552 SF
TP103	130 SF
TP104	151 SF
TP105	130 SF
TP106	164 SF
TP107	355 SF
TP108	207 SF
TP109	372 SF
TP110	1381 SF
TP111	2894 SF
TP112	1113 SF
TP113	1102 SF
TP114	10482 SF
TP115	101 SF
TP116	1415 SF
TP117	307 SF

PROJECT ADDRESS:


3700 Coldwater Canyon Ave. Los Angeles, CA 91604

SHEET TITLE:

Taper Pavillion
Floor Plans

SCALE: AS NOTED

SHEET NUMBER: AB-109

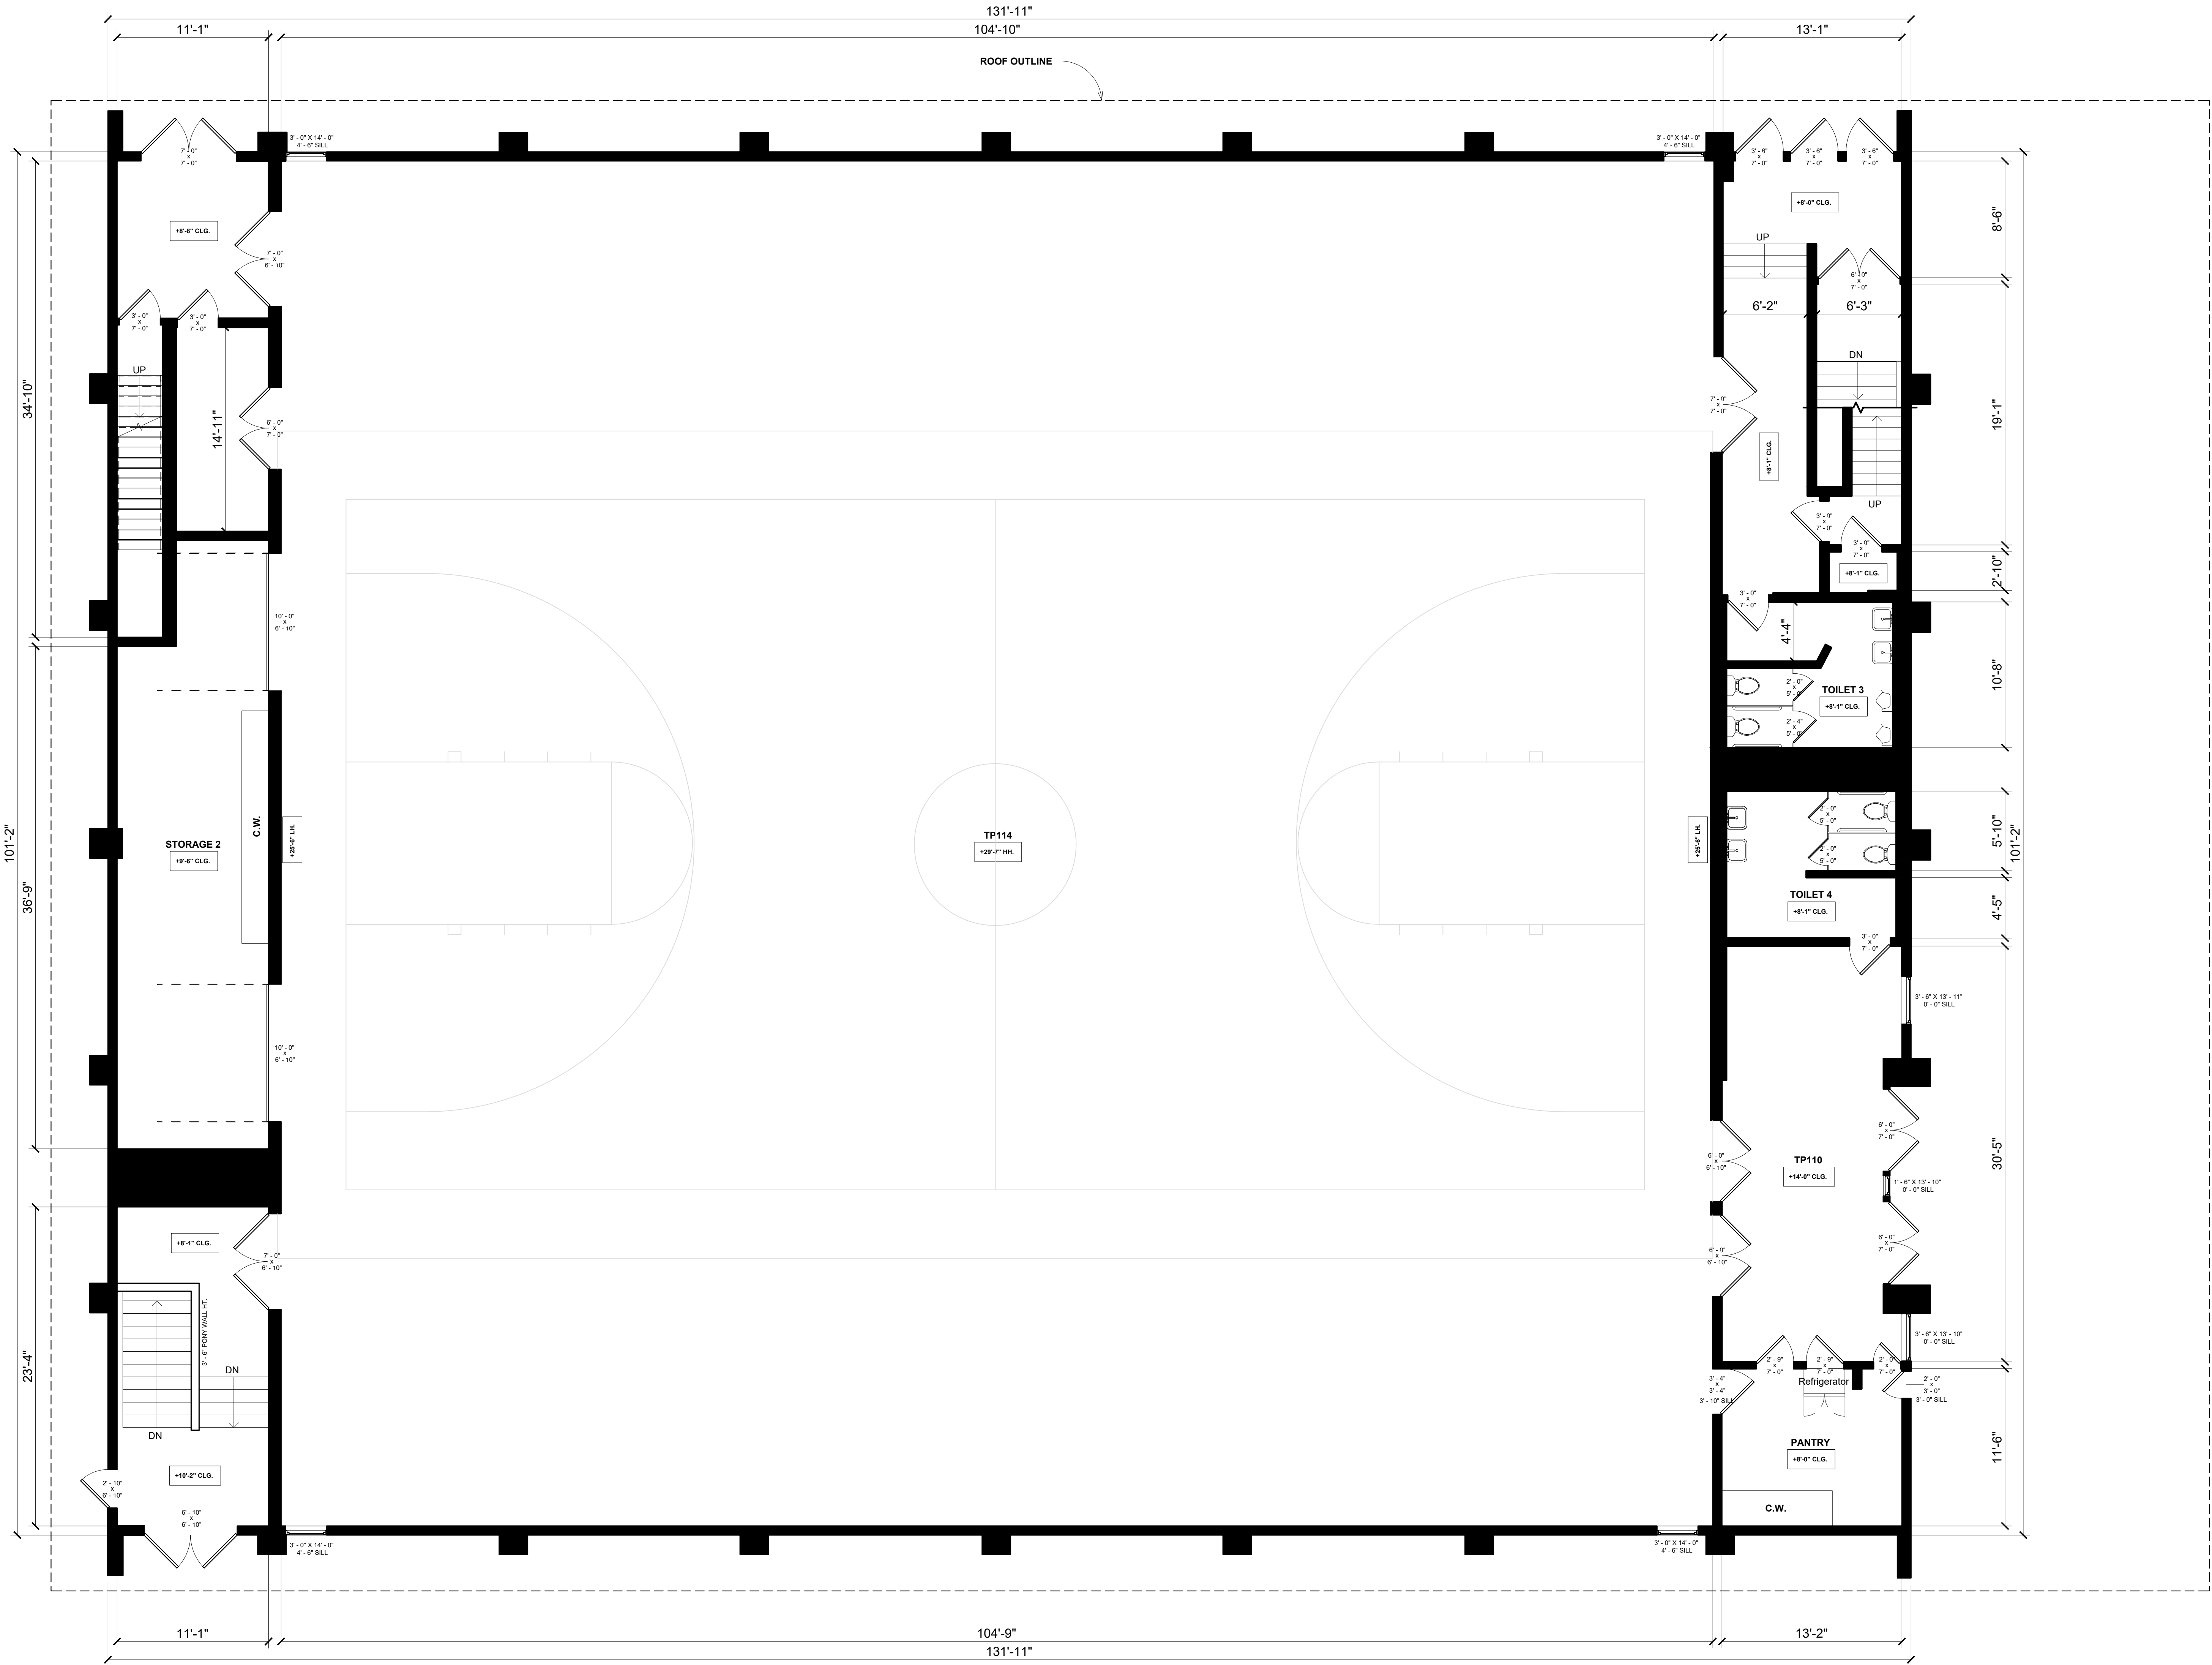

FLOOR PLAN LEGEND	
	WINDOW WIDTH X HEIGHT - SILL HEIGHT
C.W.	CASEWORK / CABINETRY / BUILT-INS
C.T.	COUNTERTOP / ISLAND
F.P.	FIREPLACE
T.O.	TOP OF
B.O.	BOTTOM OF
+X' - X' CLG.	CEILING AT HIGHEST POINT
+X' - X'	LEVEL CHANGE
X'	STEP DIRECTION & HEIGHT

HARVARD
WESTLAKE
SCHOOL

A
B
L
A


AS BUILT LA
21255 BURBANK BLVD, STE 120
WOODLAND HILLS, CA 91367
WWW.ASBUILTLA.COM
INFO@ASBUILTLA.COM
(818)-208-3616


NOTES REGARDING AREA SIZING * AREA MEASUREMENTS ARE BASED ON TOTAL SQUARE FOOTAGE MEASURED FROM THE INTERIOR SIDE OF THE WALLS IN ADDITION TO THE EXTERIOR SIDE OF WALLS. ** AREA CALCULATIONS ARE COMPLIMENTARY AND WILL NOT NECESSARILY MATCH WHAT IS ON BUILDING OR REAL ESTATE RECORDS. *** IT'S THE RESPONSIBILITY OF THE PROJECT DESIGN PROFESSIONAL TO DETERMINE THE PROPER BREAKDOWN OF SPACES SIZES AS REQUIRED PER LOCAL REGULATIONS, BUILDING AND PLANNING CODES AND PROVIDE COMPLIANCE DOCUMENTATION AS REQUIRED. **** WE RECOMMEND TO ALL OUR CUSTOMERS TO GET A LAND SURVEY OF THEIR PROPERTY WHICH PROVIDES ANOTHER LEVEL OF ACCURACY, SIZING INFORMATION FOR THE PROPERTY, BOUNDARIES, AND AS IS OFTEN REQUIRED BY CITY BUILDING & PLANNING DEPARTMENTS FOR PLAN CHECK REVIEWS.	DRAWN BY:	E.P.
	CHECKED BY:	F.P.S.
	DATE:	01/09/2026
	PROJECT ID	4578
	SHEET SIZE	48" X 36"
SCOPE OF WORK As Built Set	DELIVERABLES	2D CAD & PDF

AREA CALCULATIONS	
TP101	189 SF
TP102	552 SF
TP103	130 SF
TP104	151 SF
TP105	130 SF
TP106	164 SF
TP107	355 SF
TP108	207 SF
TP109	372 SF
TP110	1381 SF
TP111	2894 SF
TP112	1113 SF
TP113	1102 SF
TP114	10482 SF
TP115	101 SF
TP116	1415 SF
TP117	307 SF


PROJECT ADDRESS:	
3700 Coldwater Canyon Ave. Los Angeles, CA 91604	
SHEET TITLE:	
Taper Pavillion Floor Plans	
SCALE:	AS NOTED
SHEET NUMBER:	AB-110

1 TAPER ATHLETIC PAVILLION - EXISTING SECOND FLOOR PLAN
3/16" = 1'-0"

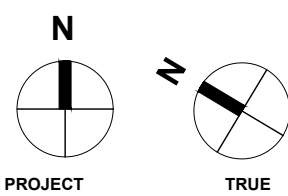


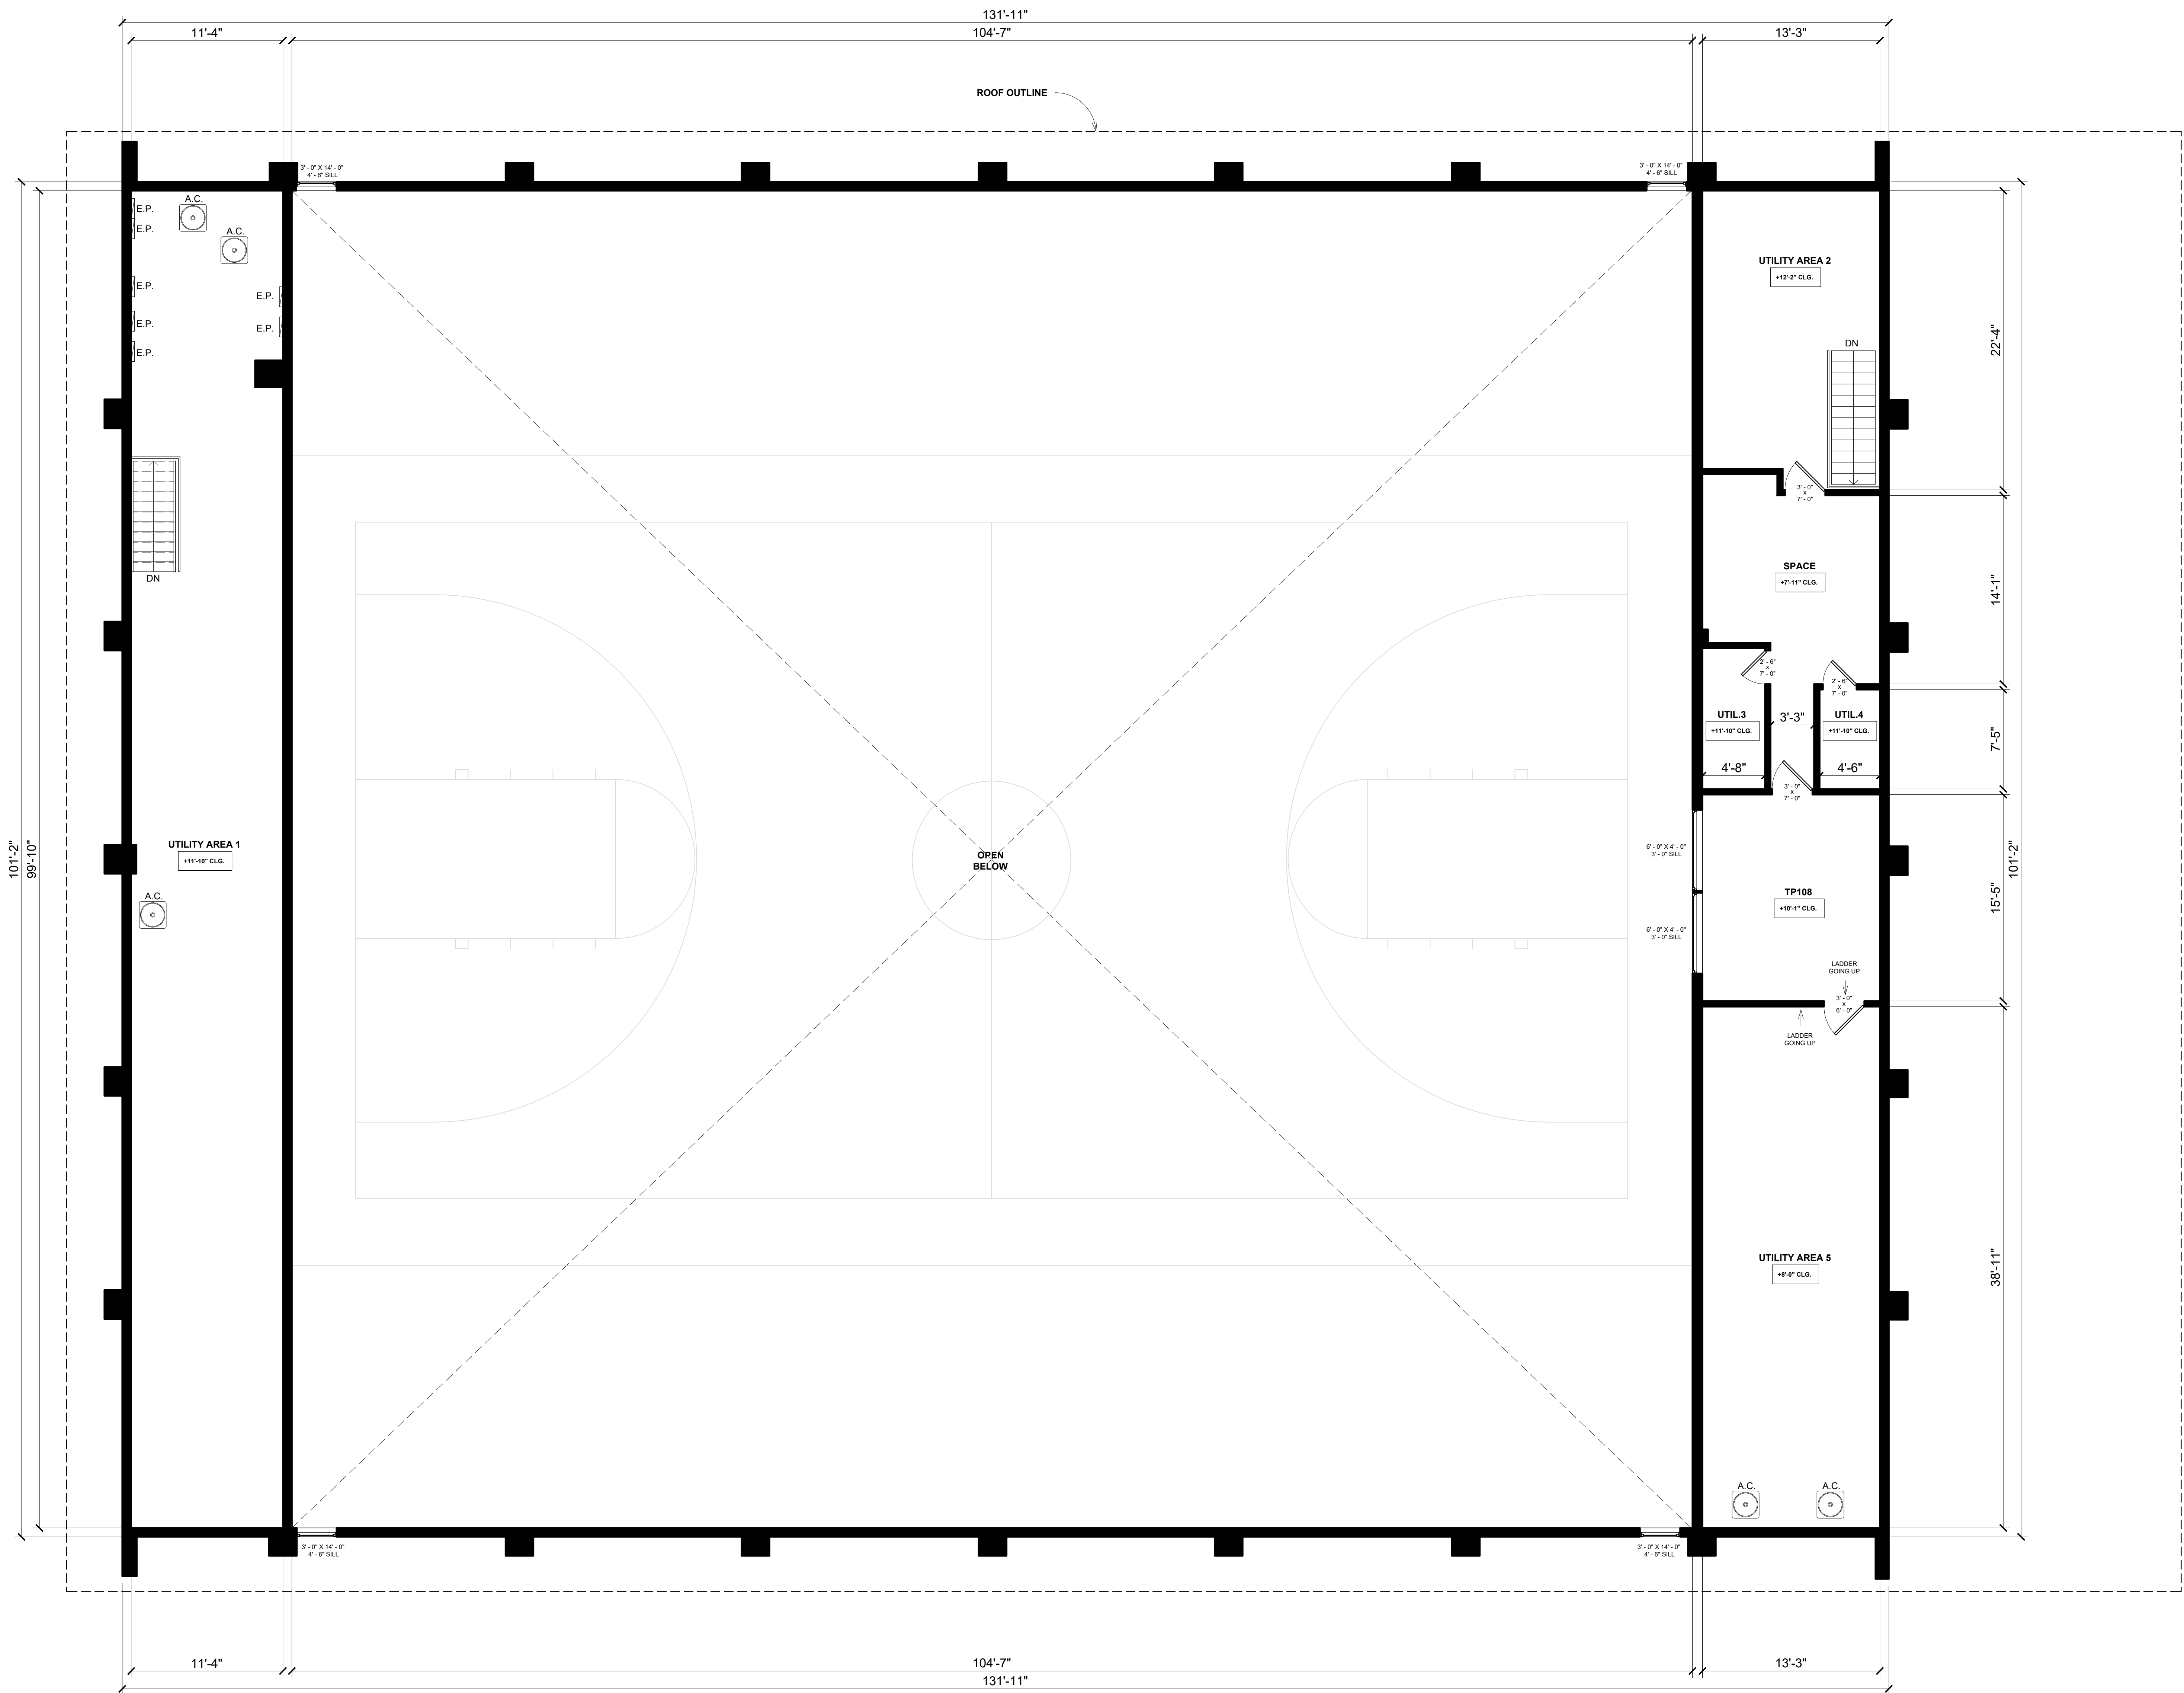


① TAPER ATHLETIC PAVILLION - EXISTING THIRD FLOOR PLAN
3/16" = 1'-0"

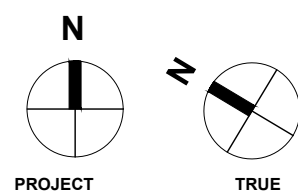

FLOOR PLAN LEGEND		HARVARD WESTLAKE SCHOOL ABLA AS BUILT LA 21255 BURBANK BLVD, STE 120 WOODLAND HILLS, CA 91367 WWW.ASBUILT.LA.COM INFO@ASBUILT.LA.COM (818)-208-3616	
	WINDOW WIDTH X HEIGHT - SILL HEIGHT		
C.W.	CASEWORK / CABINETRY / BUILT-INS		
C.T.	COUNTERTOP / ISLAND		
F.P.	FIREPLACE		
T.O.	TOP OF		
B.O.	BOTTOM OF		
+X" - X" CLG.	CEILING AT HIGHEST POINT		
+X" - X"	LEVEL CHANGE		
X"	STEP DIRECTION & HEIGHT		
NOTES REGARDING AREA SIZING		DRAWN BY:	E.P.
* AREA MEASUREMENTS ARE BASED ON TOTAL SQUARE FOOTAGE MEASURED FROM THE INTERIOR SIDE OF THE WALLS IN ADDITION TO THE EXTERIOR SIDE OF WALLS. ** AREA CALCULATIONS ARE COMPLIMENTARY AND WILL NOT NECESSARILY MATCH WHAT IS ON BUILDING OR REAL ESTATE RECORDS. *** IT'S THE RESPONSIBILITY OF THE PROJECT DESIGN PROFESSIONAL TO DETERMINE THE PROPER BREAKDOWN OF SPACES SIZES AS REQUIRED PER LOCAL REGULATIONS, BUILDING AND PLANNING CODES AND PROVIDE COMPLIANCE DOCUMENTATION AS REQUIRED. **** WE RECOMMEND TO ALL OUR CUSTOMERS TO GET A LAND SURVEY OF THEIR PROPERTY WHICH PROVIDES ANOTHER LEVEL OF ACCURACY, SIZING INFORMATION FOR THE PROPERTY, BOUNDARIES, AND AS IS OFTEN REQUIRED BY CITY BUILDING & PLANNING DEPARTMENTS FOR PLAN CHECK REVIEWS.		CHECKED BY:	F.P.S.
		DATE:	01/09/2026
		PROJECT ID	4578
		SHEET SIZE	48" X 36"
		DELIVERABLES	2D CAD & PDF
		SCOPE OF WORK	
		As Built Set	

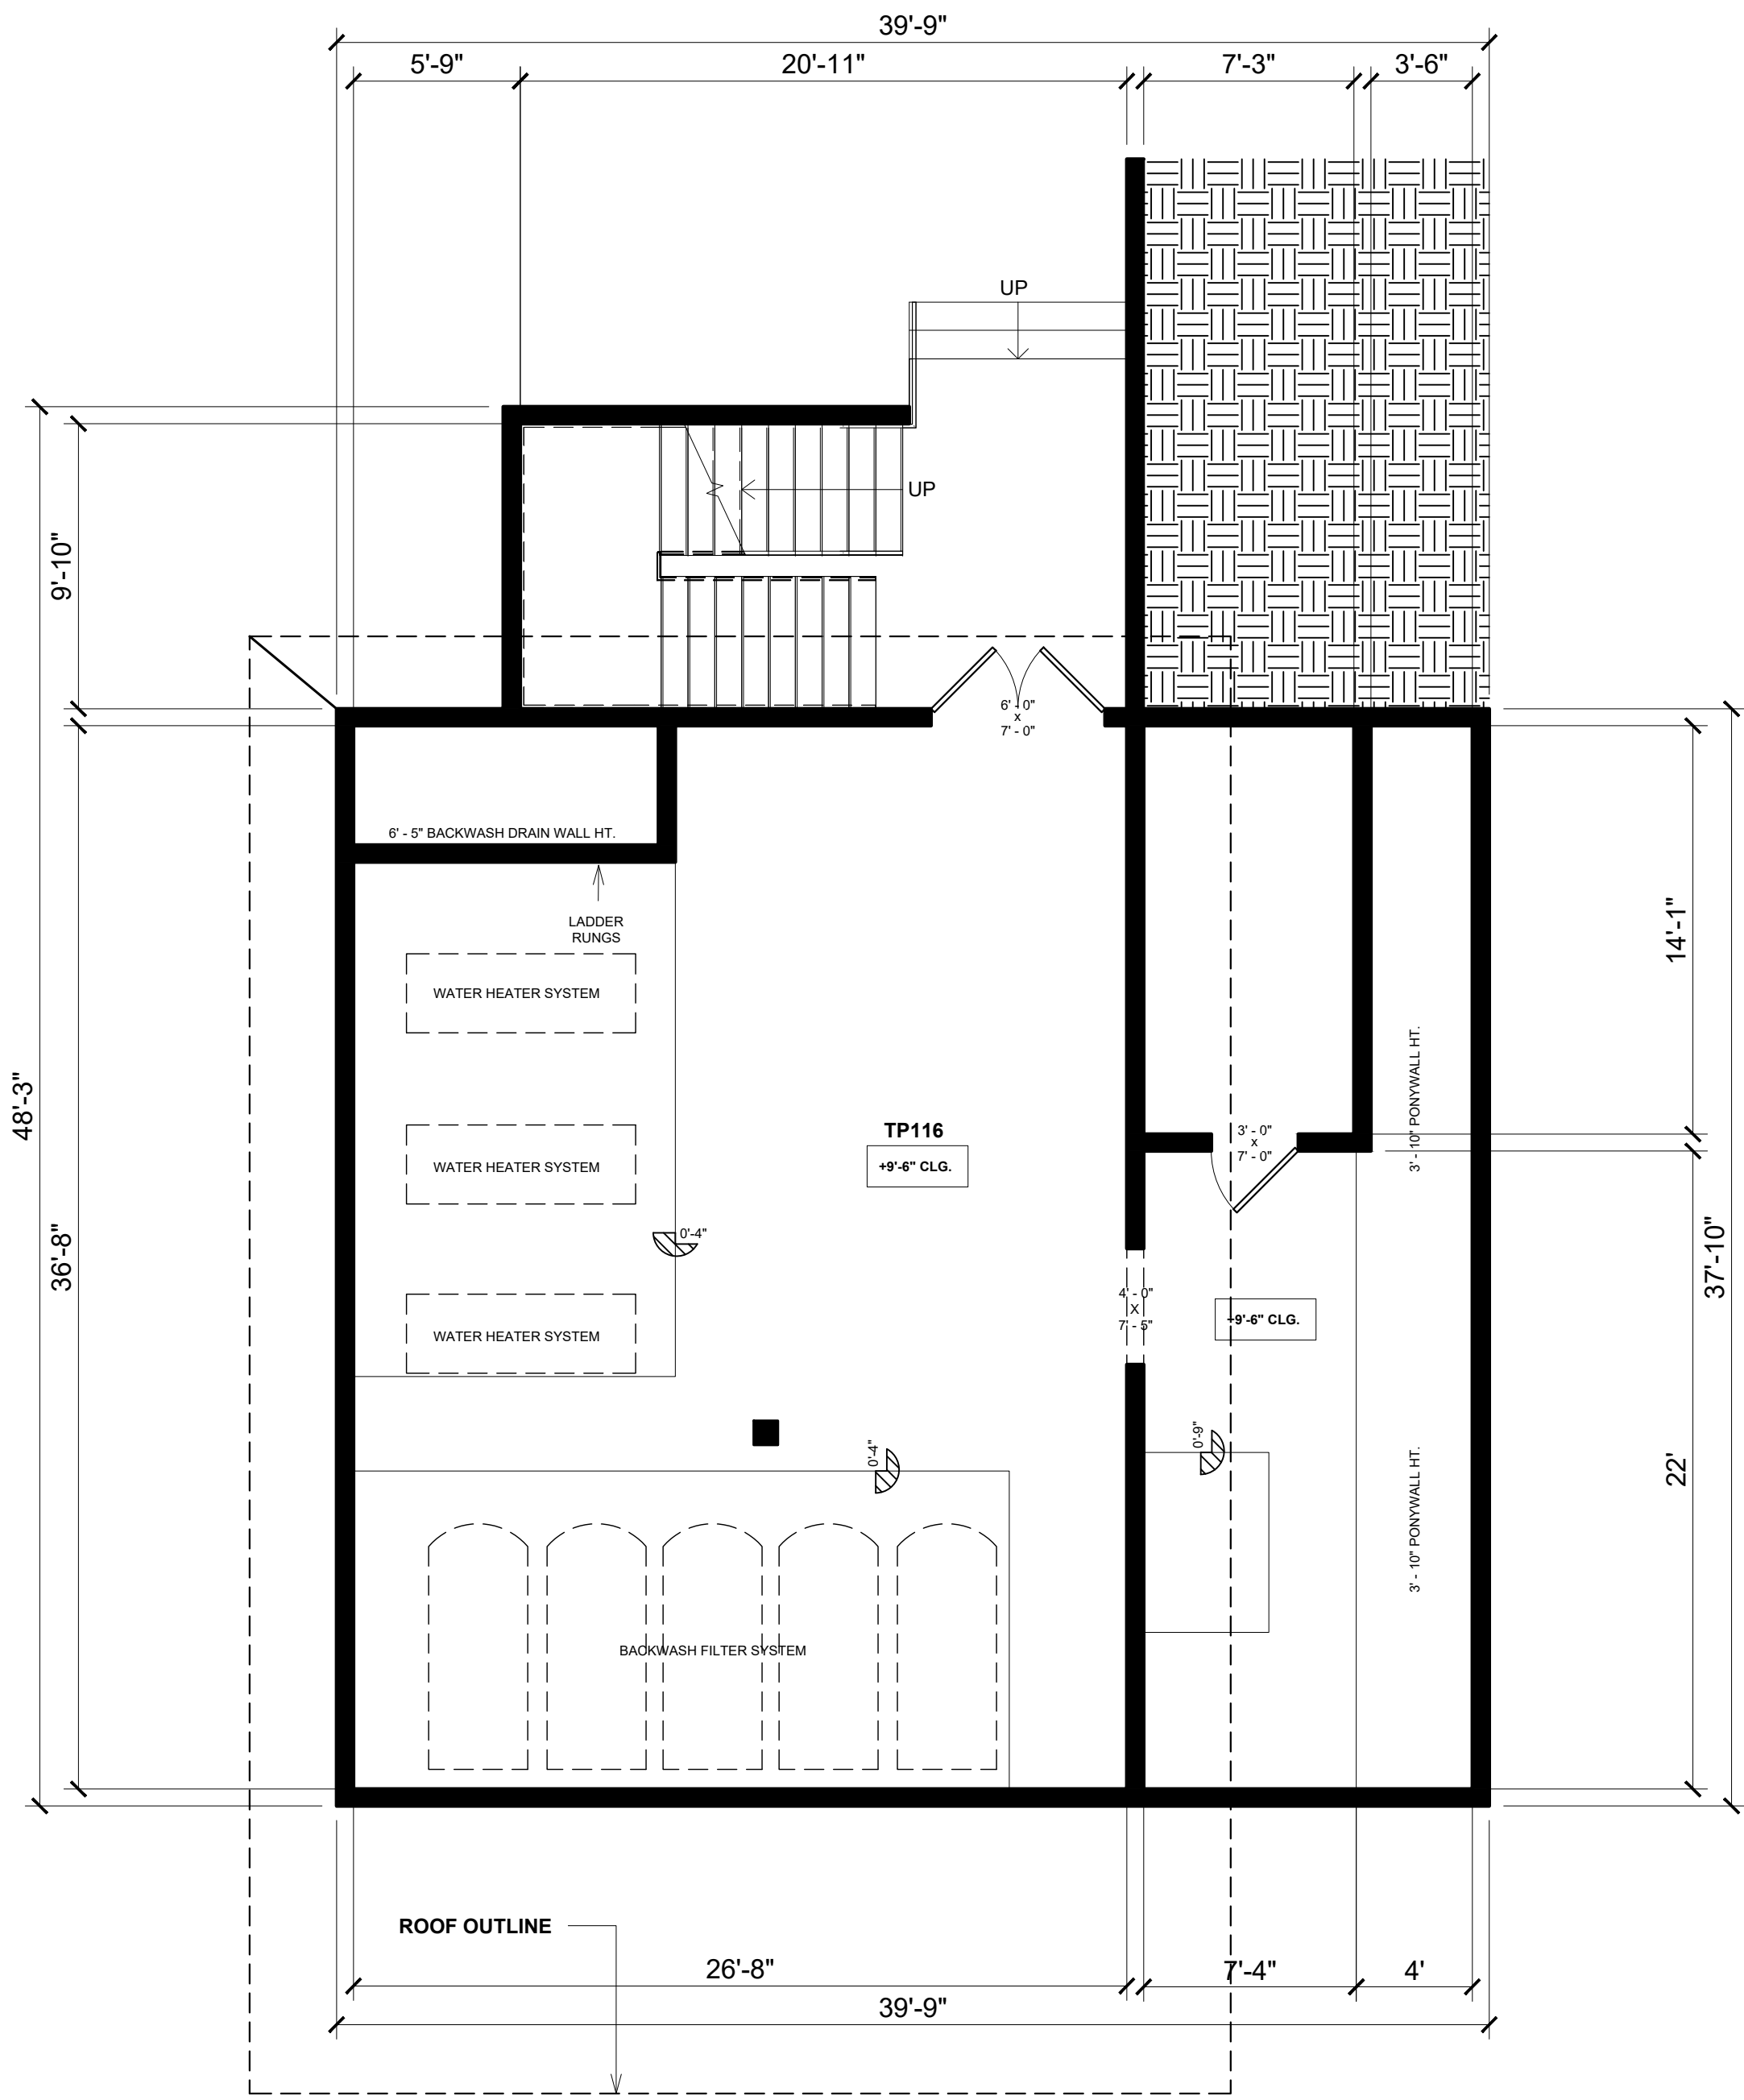


1 TAPER ATHLETIC PAVILLION (POOL HOUSE) - EXISTING GROUND FLOOR PLAN
3/16" = 1'-0"

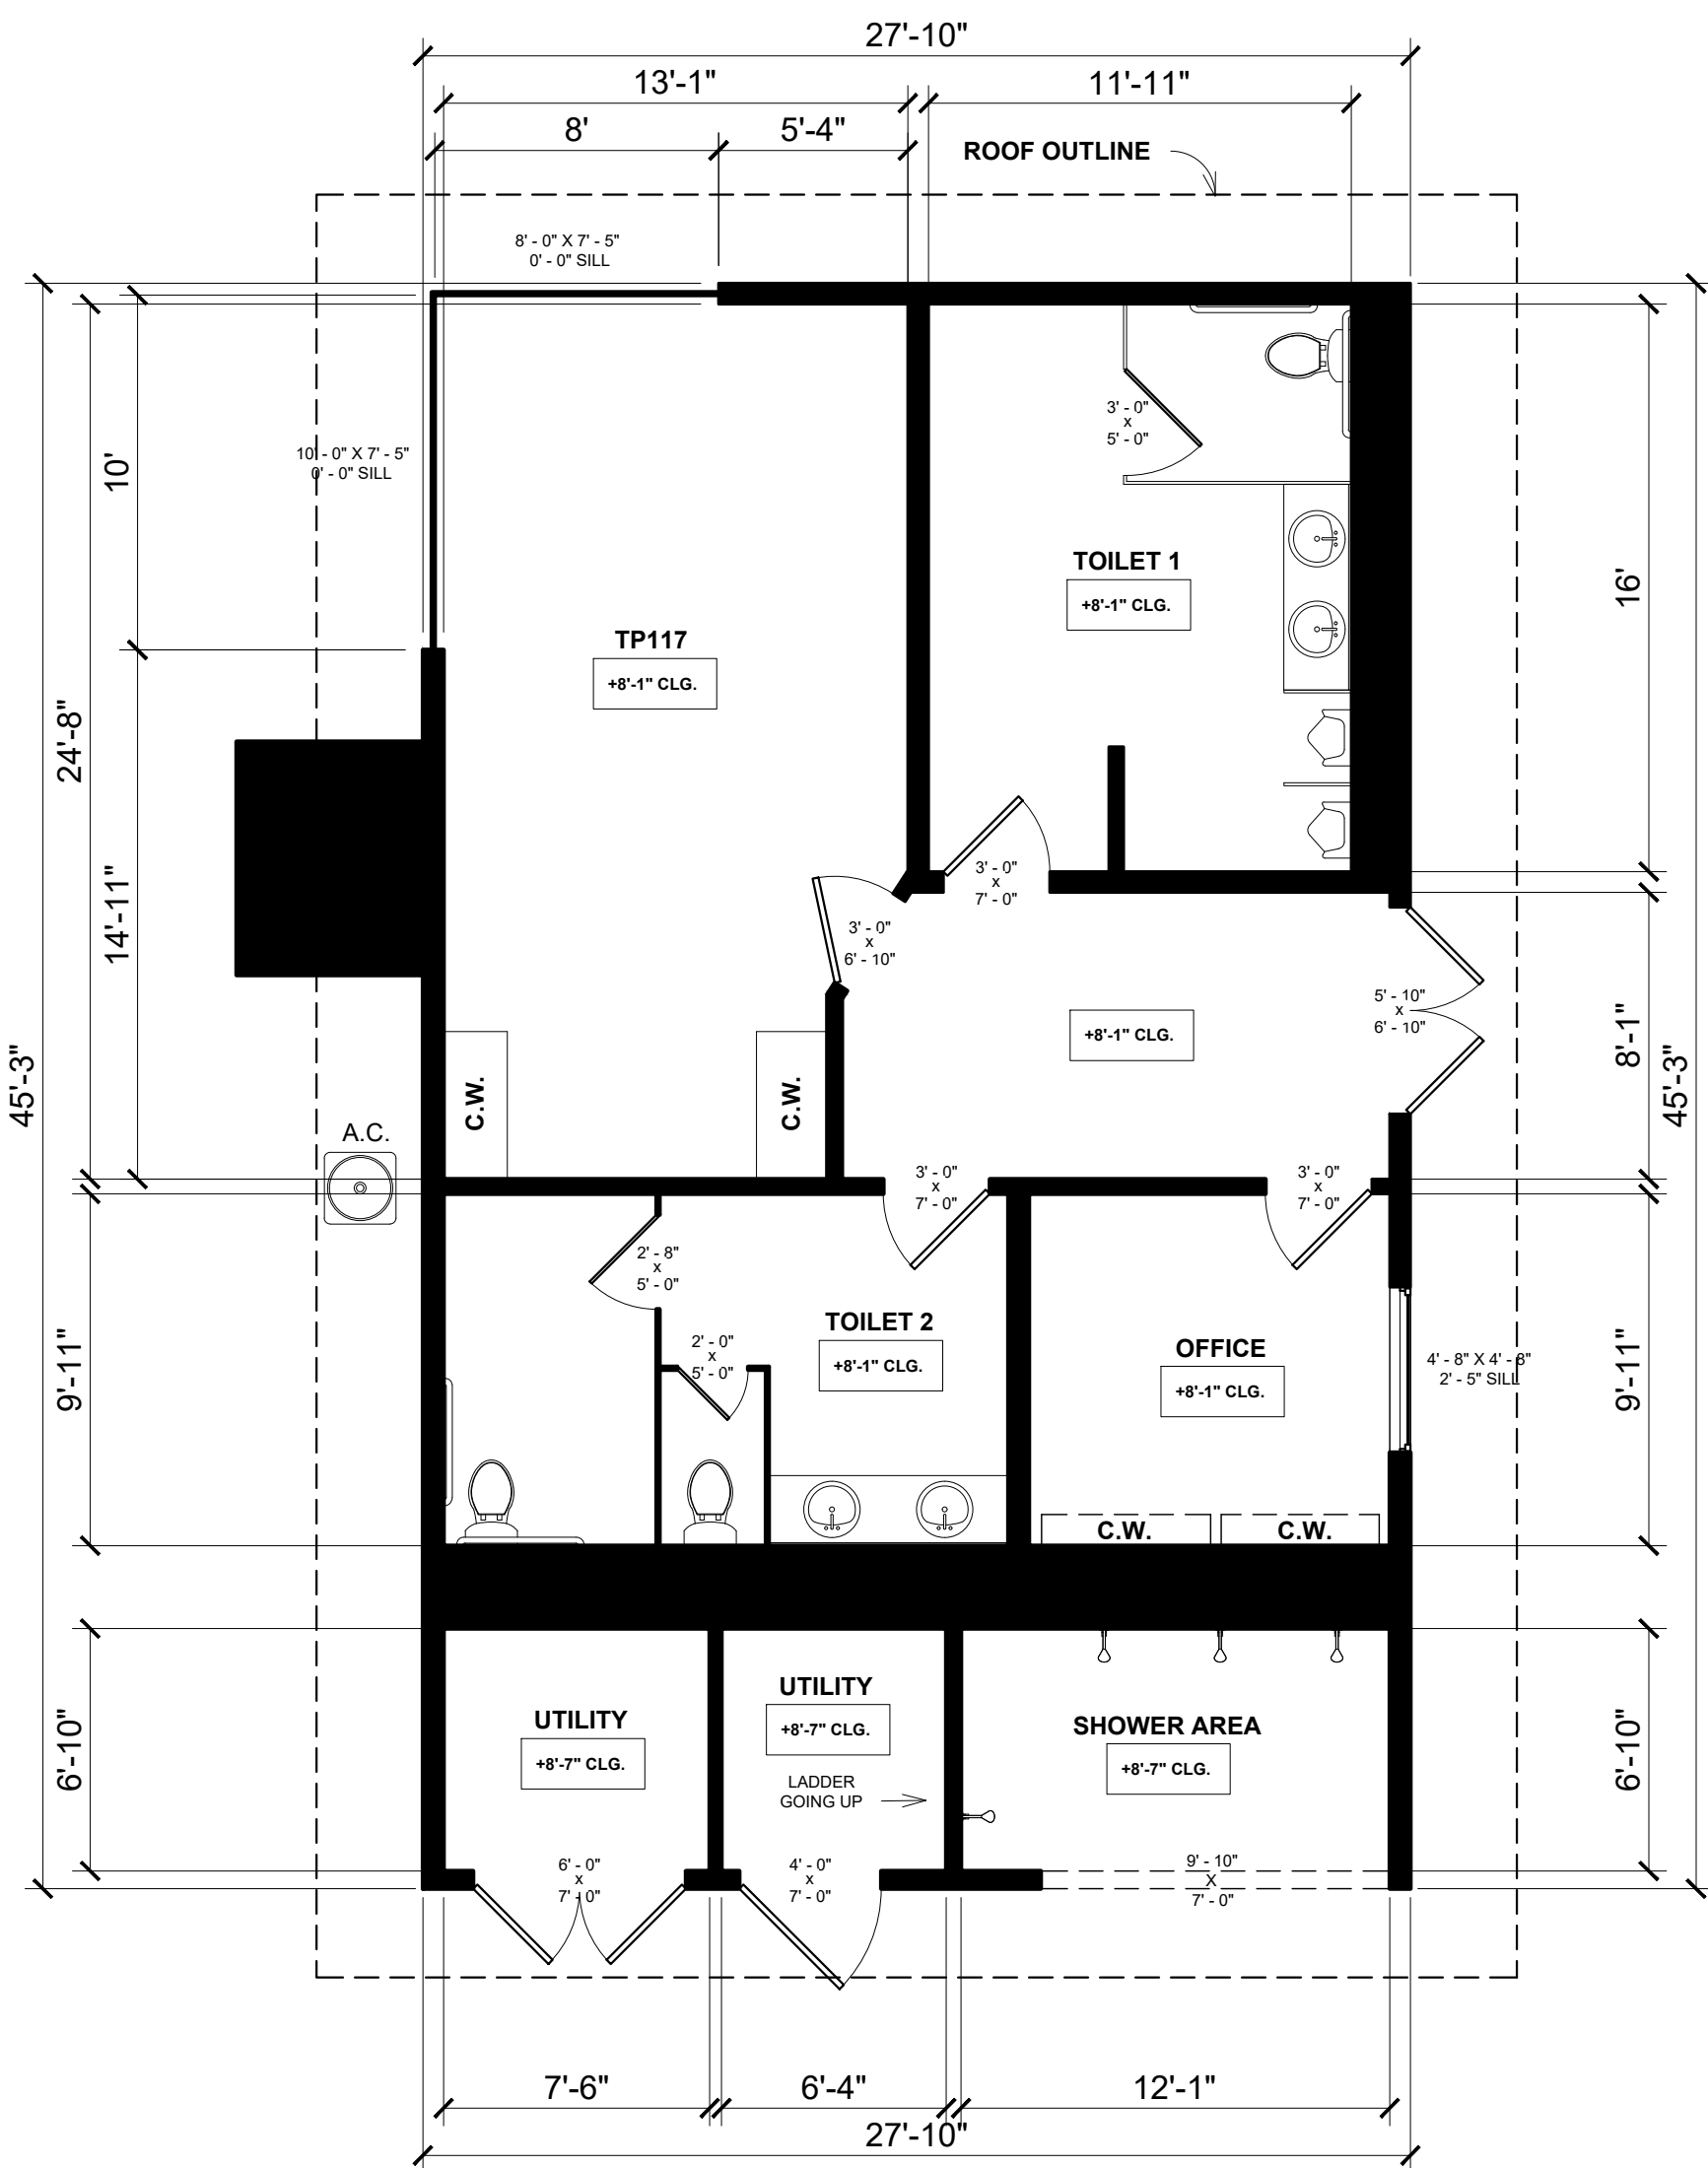

2 TAPER ATHLETIC PAVILLION (POOL HOUSE) - EXISTING SECOND FLOOR PLAN
3/16" = 1'-0"

FLOOR PLAN LEGEND	
	WINDOW WIDTH X HEIGHT - SILL HEIGHT
C.W.	CASEWORK / CABINETRY / BUILT-INS
C.T.	COUNTERTOP / ISLAND
F.P.	FIREPLACE
T.O.	TOP OF
B.O.	BOTTOM OF
+X' - X' CLG.	CEILING AT HIGHEST POINT
+X' - X'	LEVEL CHANGE
X'	STEP DIRECTION & HEIGHT
NOTES REGARDING AREA SIZING	
* AREA MEASUREMENTS ARE BASED ON TOTAL SQUARE FOOTAGE MEASURED FROM THE INTERIOR SIDE OF THE WALLS IN ADDITION TO THE EXTERIOR SIDE OF WALLS.	
** AREA CALCULATIONS ARE COMPLIMENTARY AND WILL NOT NECESSARILY MATCH WHAT IS ON BUILDING OR REAL ESTATE RECORDS.	
*** IT'S THE RESPONSIBILITY OF THE PROJECT DESIGN PROFESSIONAL TO DETERMINE THE PROPER BREAKDOWN OF SPACES SIZES AS REQUIRED PER LOCAL REGULATIONS, BUILDING AND PLANNING CODES AND PROVIDE COMPLIANCE DOCUMENTATION AS REQUIRED.	
**** WE RECOMMEND TO ALL OUR CUSTOMERS TO GET A LAND SURVEY OF THEIR PROPERTY WHICH PROVIDES ANOTHER LEVEL OF ACCURACY, SIZING INFORMATION FOR THE PROPERTY, BOUNDARIES, AND AS IS OFTEN REQUIRED BY CITY BUILDING & PLANNING DEPARTMENTS FOR PLAN CHECK REVIEWS.	
DRAWN BY:	E.P.
CHECKED BY:	F.P.S.
DATE:	01/09/2026
PROJECT ID	4578
SHEET SIZE	48" X 36"
DELIVERABLES	2D CAD & PDF
SCOPE OF WORK	
As Built Set	

HARVARD
WESTLAKE
SCHOOL

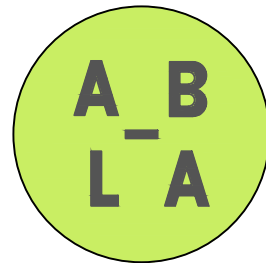

AS BUILT LA
21255 BURBANK BLVD, STE 120
WOODLAND HILLS, CA 91367
WWW.ASBUILT.LA.COM
INFO@ASBUILT.LA.COM
(818)-208-3616

AREA CALCULATIONS

TP101	189 SF
TP102	552 SF
TP103	130 SF
TP104	151 SF
TP105	130 SF
TP106	164 SF
TP107	355 SF
TP108	207 SF
TP109	372 SF
TP110	1381 SF
TP111	2894 SF
TP112	1113 SF
TP113	1102 SF
TP114	10482 SF
TP115	101 SF
TP116	1415 SF
TP117	307 SF

PROJECT ADDRESS:


3700 Coldwater Canyon Ave. Los Angeles, CA 91604


SHEET TITLE:

Taper Pavillion
Floor Plans

SCALE: AS NOTED

SHEET NUMBER: AB-112

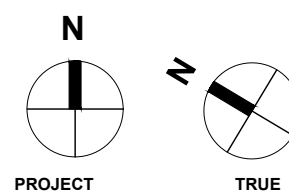

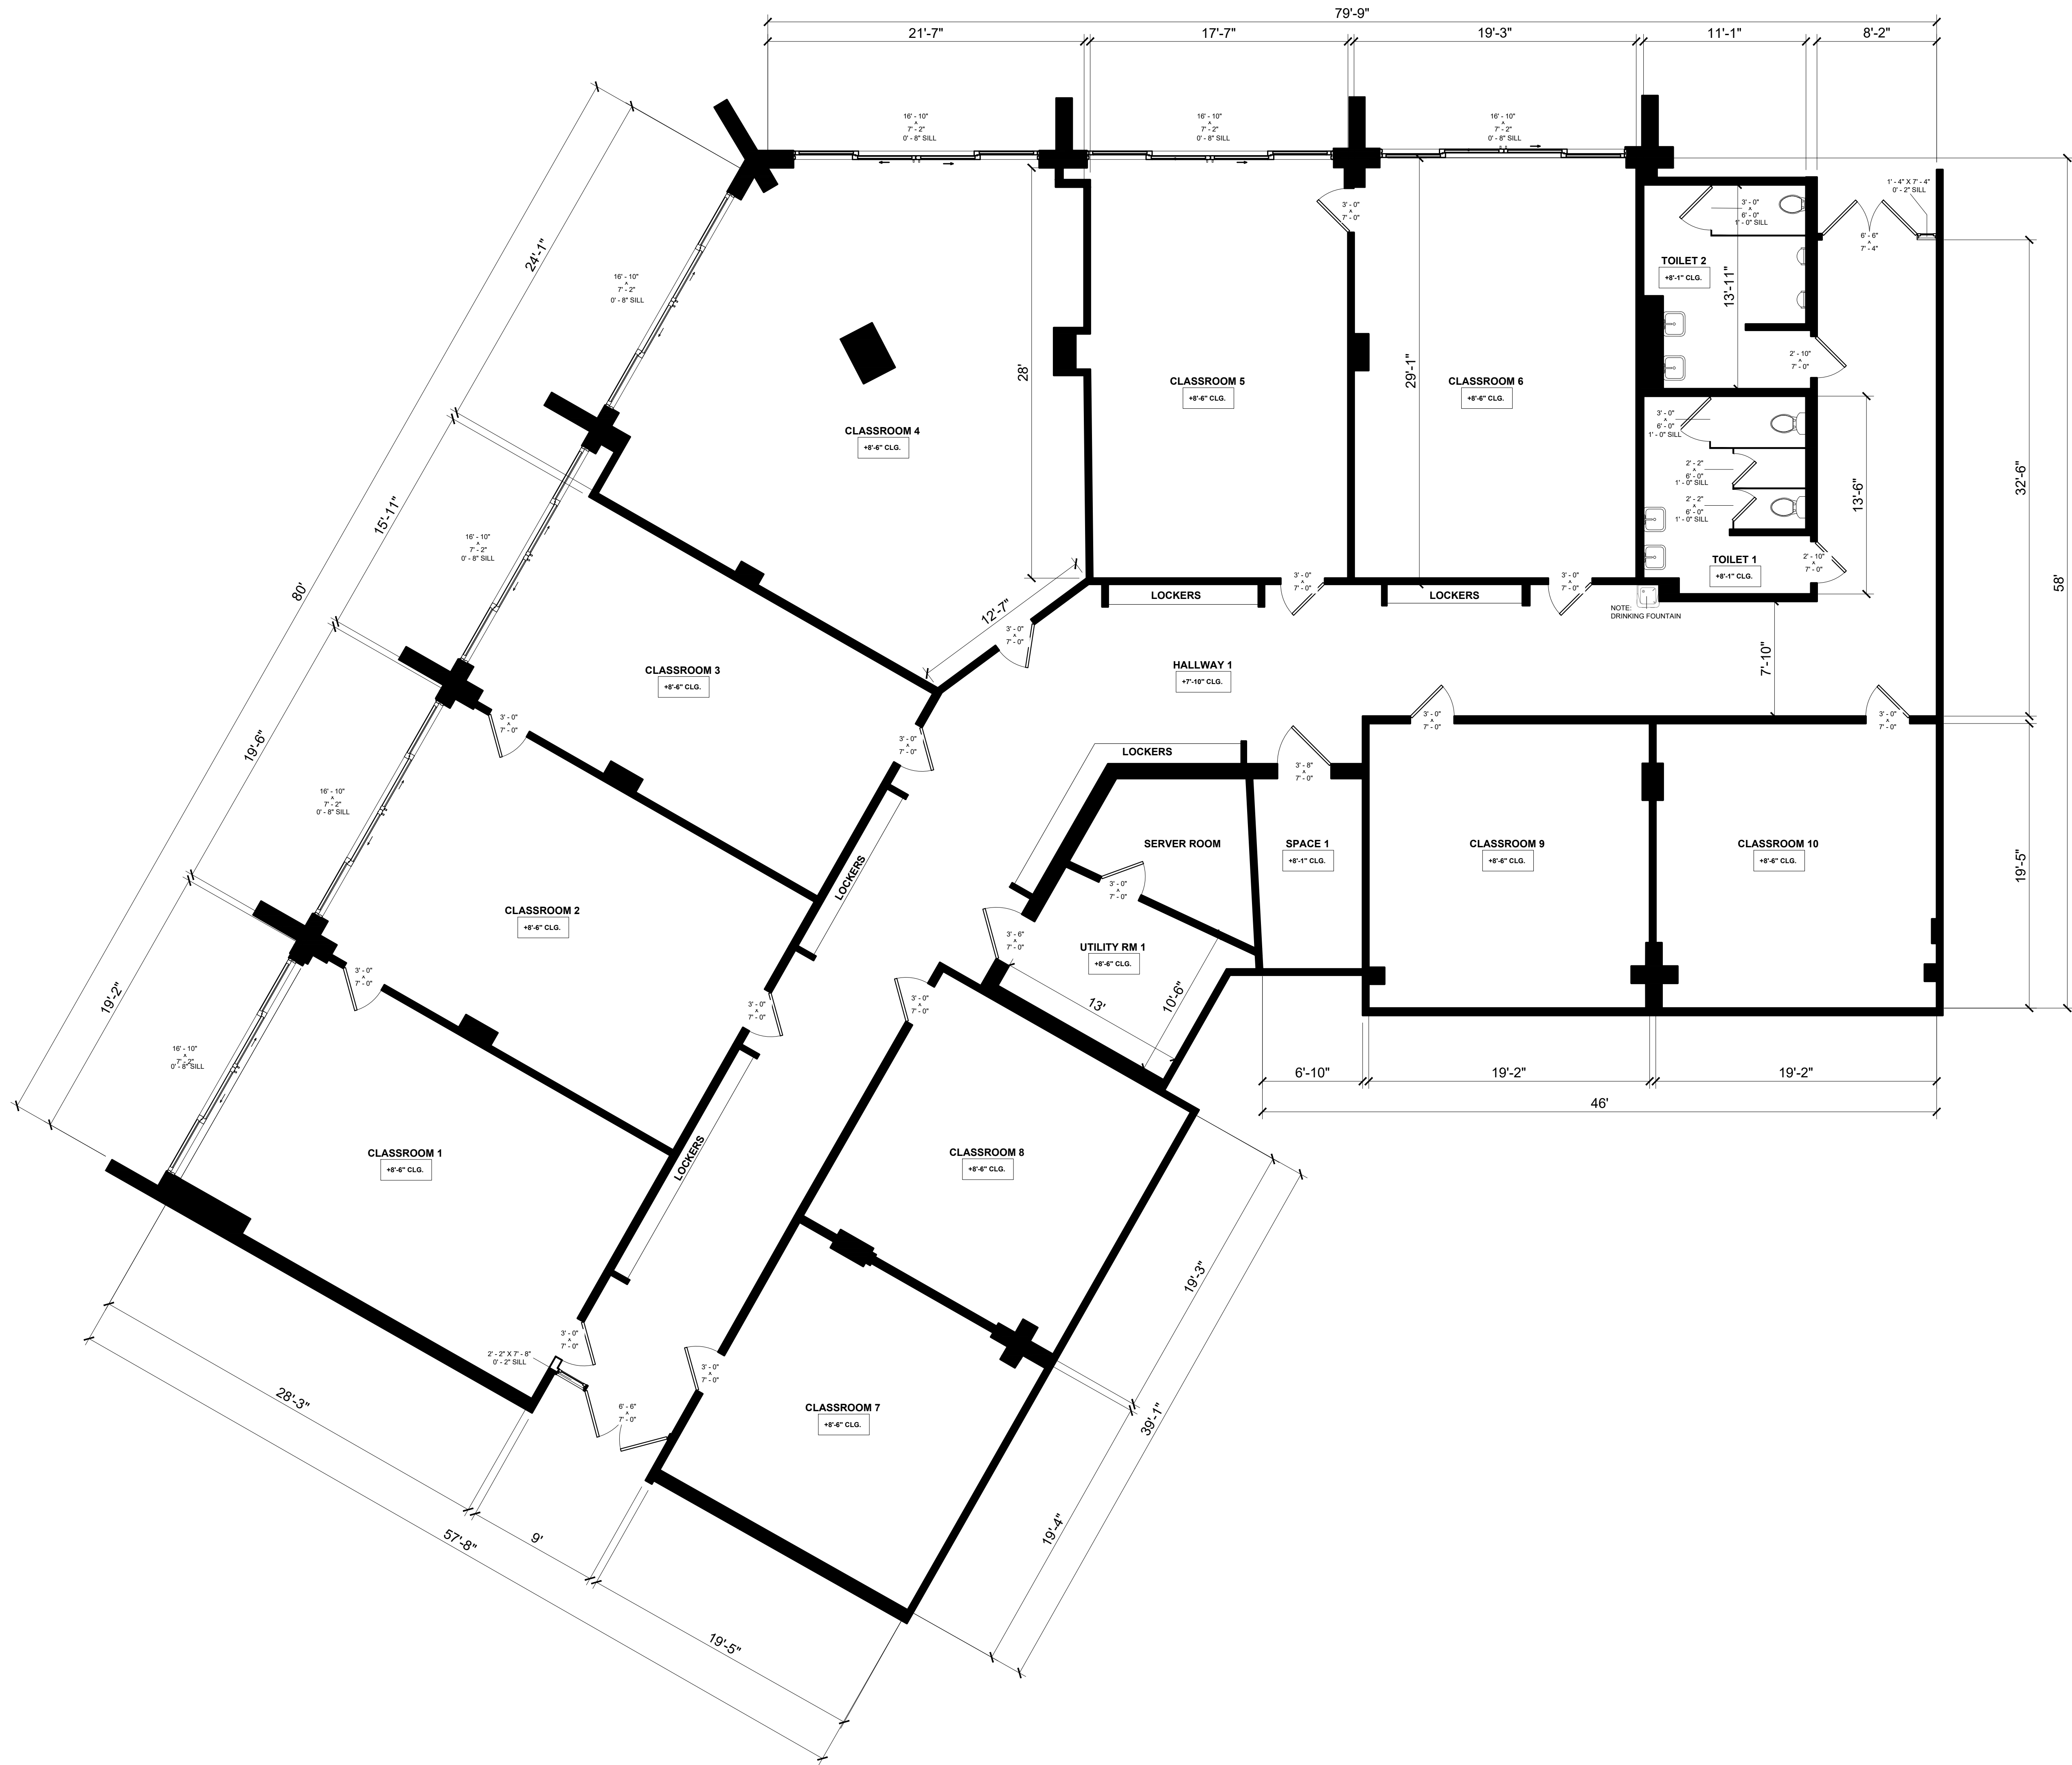

1 WORLD LANGUAGE CENTER - EXISTING FLOOR PLAN
3/16" = 1'-0"

FLOOR PLAN LEGEND	
	WINDOW WIDTH X HEIGHT - SILL HEIGHT
C.W.	CASEWORK / CABINETRY / BUILT-INS
C.T.	COUNTERTOP / ISLAND
F.P.	FIREPLACE
T.O.	TOP OF
B.O.	BOTTOM OF
+X' - X' CLG.	CEILING AT HIGHEST POINT
+X' - X'	LEVEL CHANGE
X'	STEP DIRECTION & HEIGHT

HARVARD
WESTLAKE
SCHOOL

A
B
L
A

AS BUILT LA
21255 BURBANK BLVD, STE 120
WOODLAND HILLS, CA 91367
WWW.ASBUILT.LA.COM
INFO@ASBUILT.LA.COM
(818)-208-3616

NOTES REGARDING AREA SIZING	
* AREA MEASUREMENTS ARE BASED ON TOTAL SQUARE FOOTAGE MEASURED FROM THE INTERIOR SIDE OF THE WALLS IN ADDITION TO THE EXTERIOR SIDE OF WALLS.	
** AREA CALCULATIONS ARE COMPLIMENTARY AND WILL NOT NECESSARILY MATCH WHAT IS ON BUILDING OR REAL ESTATE RECORDS.	
*** IT'S THE RESPONSIBILITY OF THE PROJECT DESIGN PROFESSIONAL TO DETERMINE THE PROPER BREAKDOWN OF SPACES SIZES AS REQUIRED PER LOCAL REGULATIONS, BUILDING AND PLANNING CODES AND PROVIDE COMPLIANCE DOCUMENTATION AS REQUIRED.	
**** WE RECOMMEND TO ALL OUR CUSTOMERS TO GET A LAND SURVEY OF THEIR PROPERTY WHICH PROVIDES ANOTHER LEVEL OF ACCURACY, SIZING INFORMATION FOR THE PROPERTY, BOUNDARIES, AND AS IS OFTEN REQUIRED BY CITY BUILDING & PLANNING DEPARTMENTS FOR PLAN CHECK REVIEWS.	

DRAWN BY:	M.M.M
CHECKED BY:	F.P.S
DATE:	01/09/2026
PROJECT ID:	4578
SHEET SIZE:	48" X 36"
DELIVERABLES:	2D CAD & PDF

SCOPE OF WORK

As Built Set

AREA CALCULATIONS

Existing Classroom 1 - Interior 1ST FL	550 SF
Existing Classroom 2 - Interior 1ST FL	561 SF
Existing Classroom 3 - Interior 1ST FL	461 SF
Existing Classroom 4 - Interior 1ST FL	889 SF
Existing Classroom 5 - Interior 1ST FL	505 SF
Existing Classroom 6 - Interior 1ST FL	552 SF
Existing Classroom 7 - Interior 1ST FL	377 SF
Existing Classroom 8 - Interior 1ST FL	374 SF
Existing Classroom 9 - Interior 1ST FL	372 SF
Existing Classroom 10 - Interior 1ST FL	372 SF
Existing Toilet RM 1 - Interior 1ST FL	152 SF
Existing Toilet RM 2 - Interior 1ST FL	147 SF
Existing Hallway 1 - Interior 1ST FL	1355 SF
Existing Building - Interior - World Language Center	7280 SF
Existing Building - Interior - Music Library 1ST FL	8157 SF
Existing Building - Interior - Music Library 2ND FL	6982 SF
Existing Building - Interior - Seaver	8250 SF

PROJECT ADDRESS:


3700 Coldwater Canyon
Ave. Los Angeles, CA 91604

SHEET TITLE:

World Language Center
Floor Plans

SCALE: AS NOTED

SHEET NUMBER: AB-113

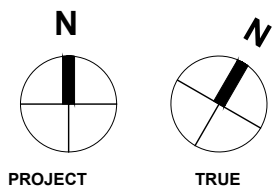

AS BUILT LA
21255 BURBANK BLVD, STE 120
WOODLAND HILLS, CA 91367
WWW.ASBUILT.LA.COM
INFO@ASBUILT.LA.COM
(818)-208-3616

NOTES REGARDING AREA SIZING * AREA MEASUREMENTS ARE BASED ON TOTAL SQUARE FOOTAGE MEASURED FROM THE INTERIOR SIDE OF THE WALLS IN ADDITION TO THE EXTERIOR SIDE OF WALLS. ** AREA CALCULATIONS ARE COMPLEMENTARY AND WILL NOT NECESSARILY MATCH WHAT IS ON BUILDING OR REAL ESTATE RECORDS. *** IT'S THE RESPONSIBILITY OF THE PROJECT DESIGN PROFESSIONAL TO DETERMINE THE PROPER BREAKDOWN OF SPACES SIZES AS REQUIRED PER LOCAL REGULATIONS. BUILDING AND PLANNING CODES AND COMMUNITY COMPLEMENTARY CODES SHALL APPLY.	DRAWN BY:	M.M.M
	CHECKED BY:	F.P.S.
	DATE:	01/09/2026
	PROJECT ID	4578
	SHEET SIZE	48" X 36"
DELIVERABLES	2D CAD & PDF	

**** WE RECOMMEND TO ALL OUR CUSTOMERS TO GET A LAND SURVEY OF THEIR PROPERTY WHICH PROVIDES ANOTHER LEVEL OF ACCURACY, SIZING INFORMATION FOR THE PROPERTY, BOUNDARIES, AND AS IS OFTEN REQUIRED BY CITY BUILDING & PLANNING DEPARTMENTS FOR PLAN CHECK REVIEWS.	As Built Set
---	--------------

AREA CALCULATIONS	
MD101	714 SF
MD102	91 SF
MD103	96 SF
MD104	150 SF
MD105	272 SF
MD106	98 SF
MD107	130 SF
MD108	141 SF
MD109	270 SF
MD110	79 SF
MD111	199 SF
MD112	1583 SF
MD113	377 SF
MD114	1812 SF
MD115	712 SF
MD116	735 SF

Existing Building - Interior - World Language Center	7280 SF
Existing Building - Interior - Mudd Library 1ST FL	8157 SF
Existing Building - Interior - Mudd Library 2ND FL	6982 SF
Existing Building - Interior - Seaver	8250 SF

PROJECT ADDRESS:


3700 Coldwater Canyon
Ave. Los Angeles, CA 91604

SHEET TITLE:


Mudd Library
Floor Plans


SCALE: AS NOTED

SHEET NUMBER: AB-114

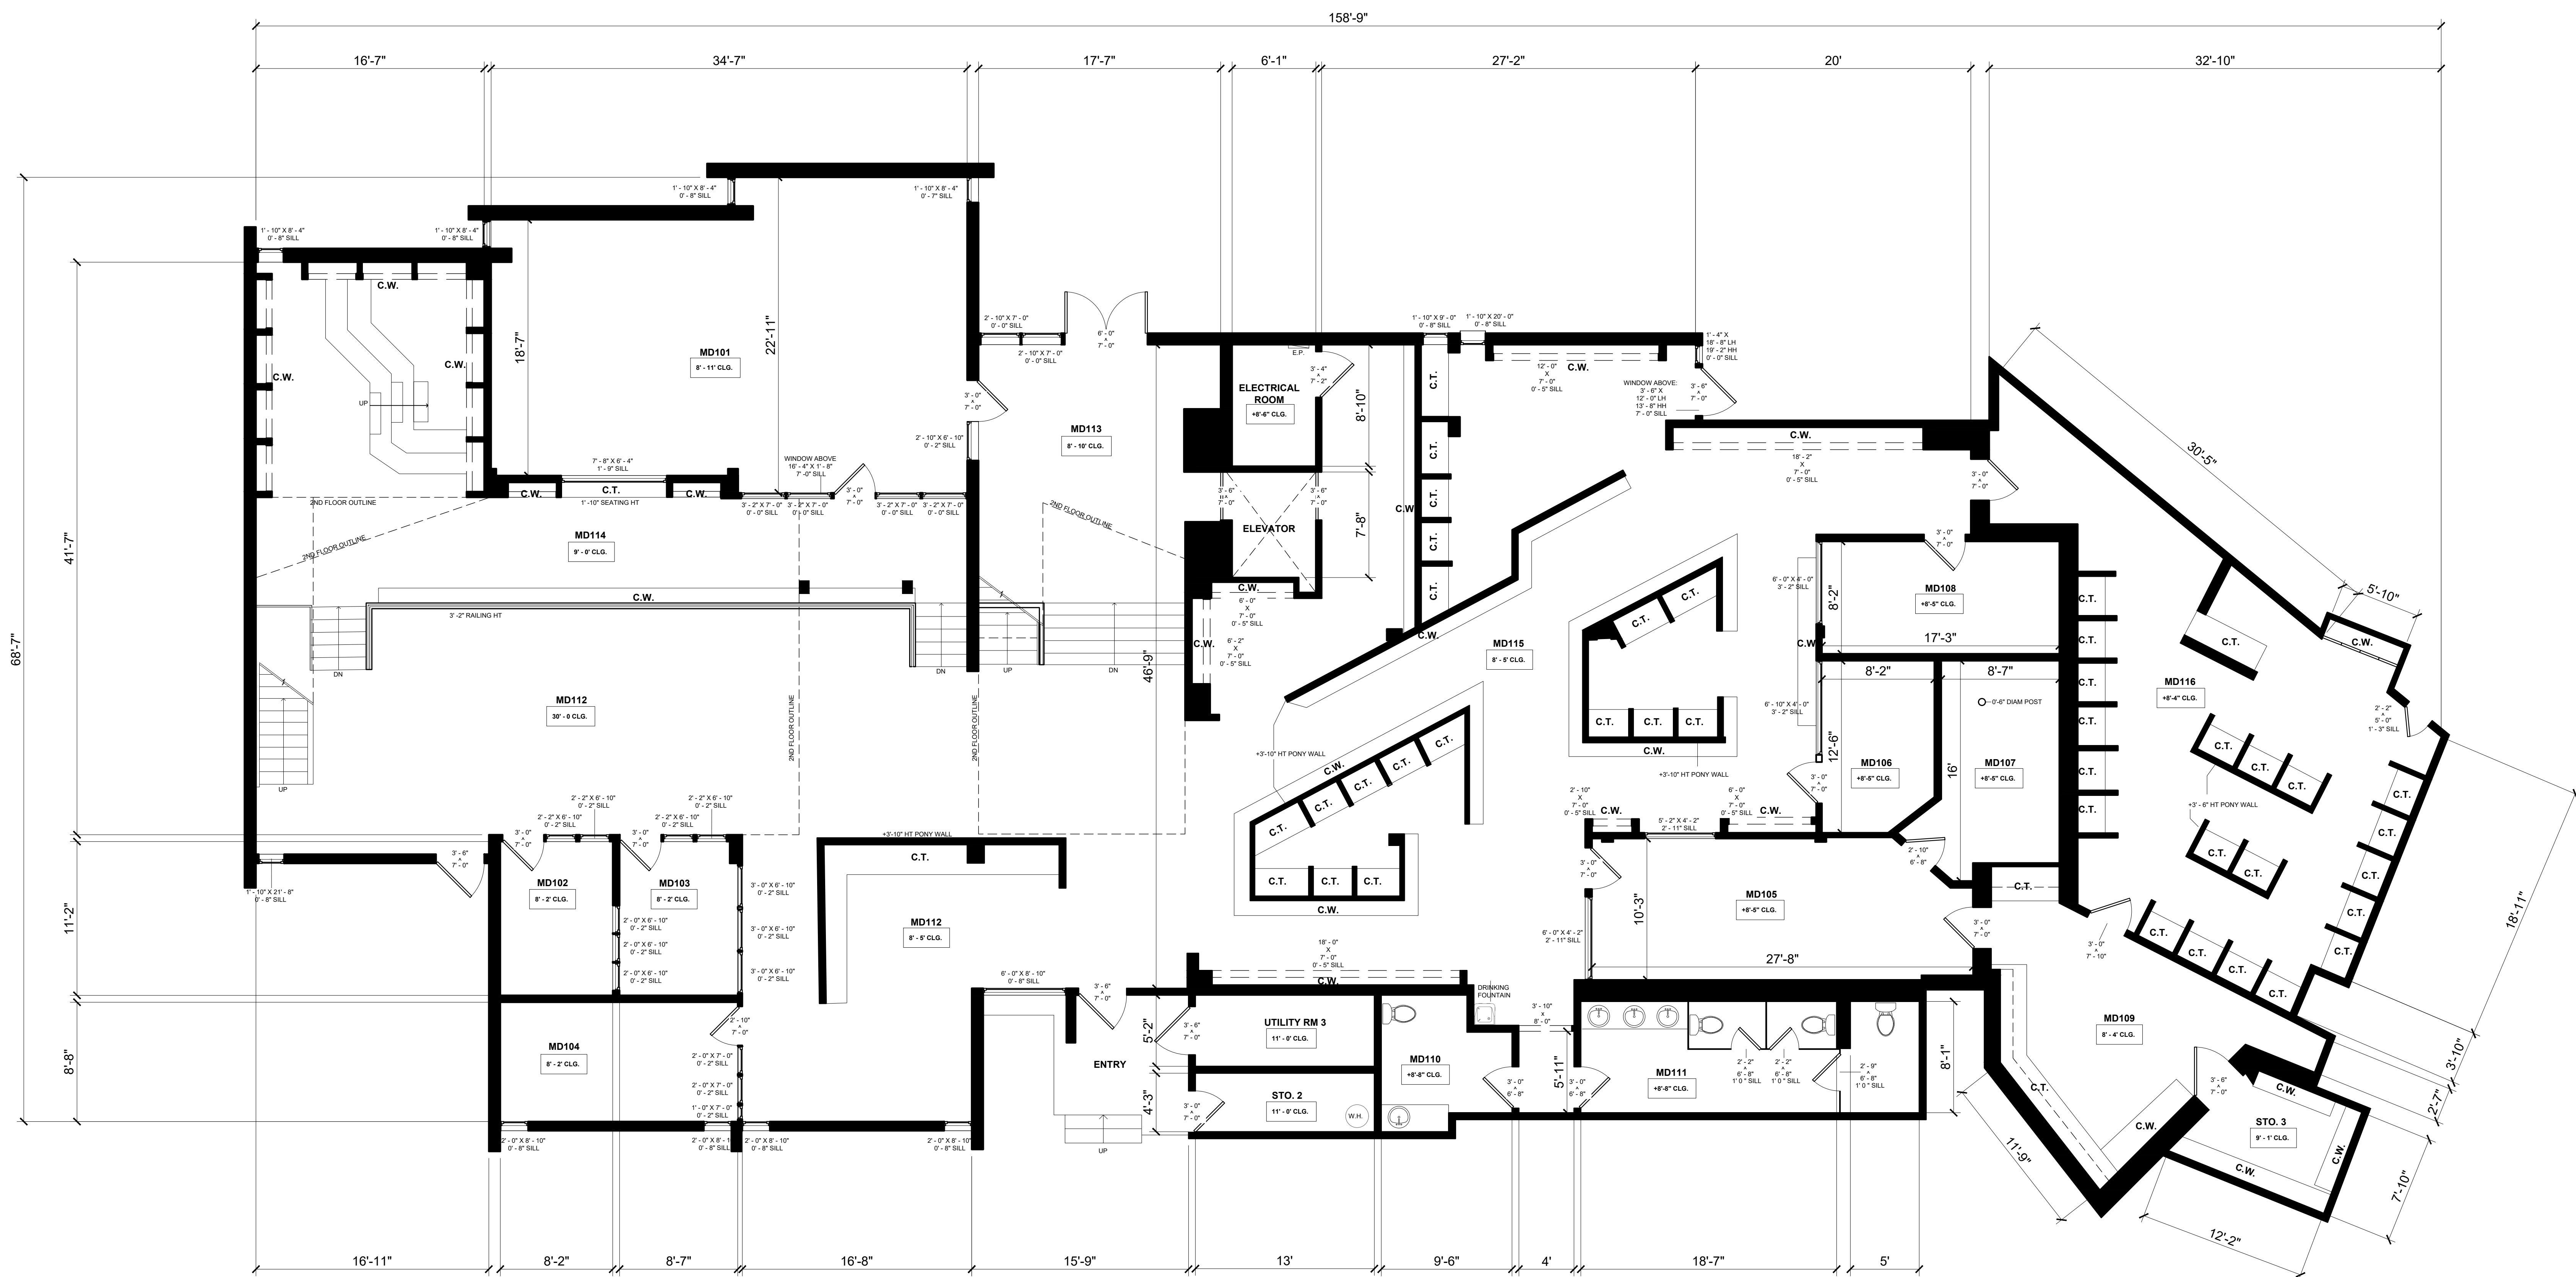

1 MUDD LIBRARY - EXISTING GROUND FLOOR PLAN
3/16" = 1'-0"

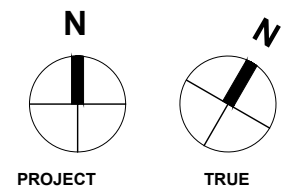

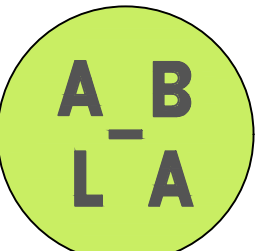

AS BUILT LA
21255 BURBANK BLVD, STE 120
WOODLAND HILLS, CA 91367
WWW.ASBUILTLA.COM
INFO@ASBUILTLA.COM
(818)-208-3616

FLOOR PLAN LEGEND	
	WINDOW WIDTH X HEIGHT - SILL HEIGHT
C.W.	CASEWORK / CABINETRY / BUILT-INS
C.T.	COUNTERTOP / ISLAND
F.P.	FIREPLACE
T.O.	TOP OF
B.O.	BOTTOM OF
+X - "X" CLG.	CEILING AT HIGHEST POINT
+X - "X"	LEVEL CHANGE
X"	STEP DIRECTION & HEIGHT



**HARVARD
WESTLAKE
SCHOOL**

AS BUILT LA
 21255 BURBANK BLVD., STE 120
 WOODLAND HILLS, CA 91367
WWW.ASBUILTLA.COM
INFO@ASBUILTLA.COM
 (818)-208-3616

NOTES REGARDING AREA SIZING * AREA MEASUREMENTS ARE BASED ON TOTAL SQUARE FOOTAGE MEASURED FROM THE INTERIOR SIDE OF THE WALLS IN ADDITION TO THE EXTERIOR SIDE OF WALLS. ** AREA CALCULATIONS ARE COMPLEMENTARY AND WILL NOT NECESSARILY MATCH WHAT IS ON BUILDING OR REAL ESTATE RECORDS. *** IT'S THE RESPONSIBILITY OF THE PROJECT DESIGN PROFESSIONAL TO DETERMINE THE PROPER BREAKDOWN OF SPACES SIZES AS REQUIRED PER LOCAL REGULATIONS, BUILDING AND PLANNING CODES AND ANY OTHER COMPLAINT CODES OR ORDINANCES.	DRAWN BY:	M.M.M
	CHECKED BY:	F.P.S.
	DATE:	01/09/2026
	PROJECT ID	4578
	SHEET SIZE	48" X 36"
DELIVERABLES	2D CAD & PDF	

**** WE RECOMMEND TO ALL OUR CUSTOMERS TO GET A LAND SURVEY OF THEIR PROPERTY WHICH PROVIDES ANOTHER LEVEL OF ACCURACY, SIZING INFORMATION FOR THE PROPERTY, BOUNDARIES, AND AS IS OFTEN REQUIRED BY CITY BUILDING & PLANNING DEPARTMENTS FOR PLAN CHECK REVIEWS

SCOPE OF WORK

As Built Set

AREA CALCULATIONS	
MD117	1082 SF
MD118	371 SF
MD119	580 SF
MD120	107 SF
MD121	108 SF
MD122	107 SF
MD123	154 SF
MD124	1066 SF
MD125	735 SF
MD126	1155 SF
MD127	210 SF
MD128	134 SF

Existing Building - Interior - World Language Center	7280 SF
Existing Building - Interior - Mudd Library 1ST FL	8157 SF
Existing Building - Interior - Mudd Library 2ND FL	6982 SF
Existing Building - Interior - Seaver	8250 SF

PROJECT ADDRESS:


3700 Coldwater Canyon
Ave. Los Angeles, CA 91604

SHEET TITLE:

Mudd Library
Floor Plans

SCALE: AS NOTED

SHEET NUMBER: AB-115

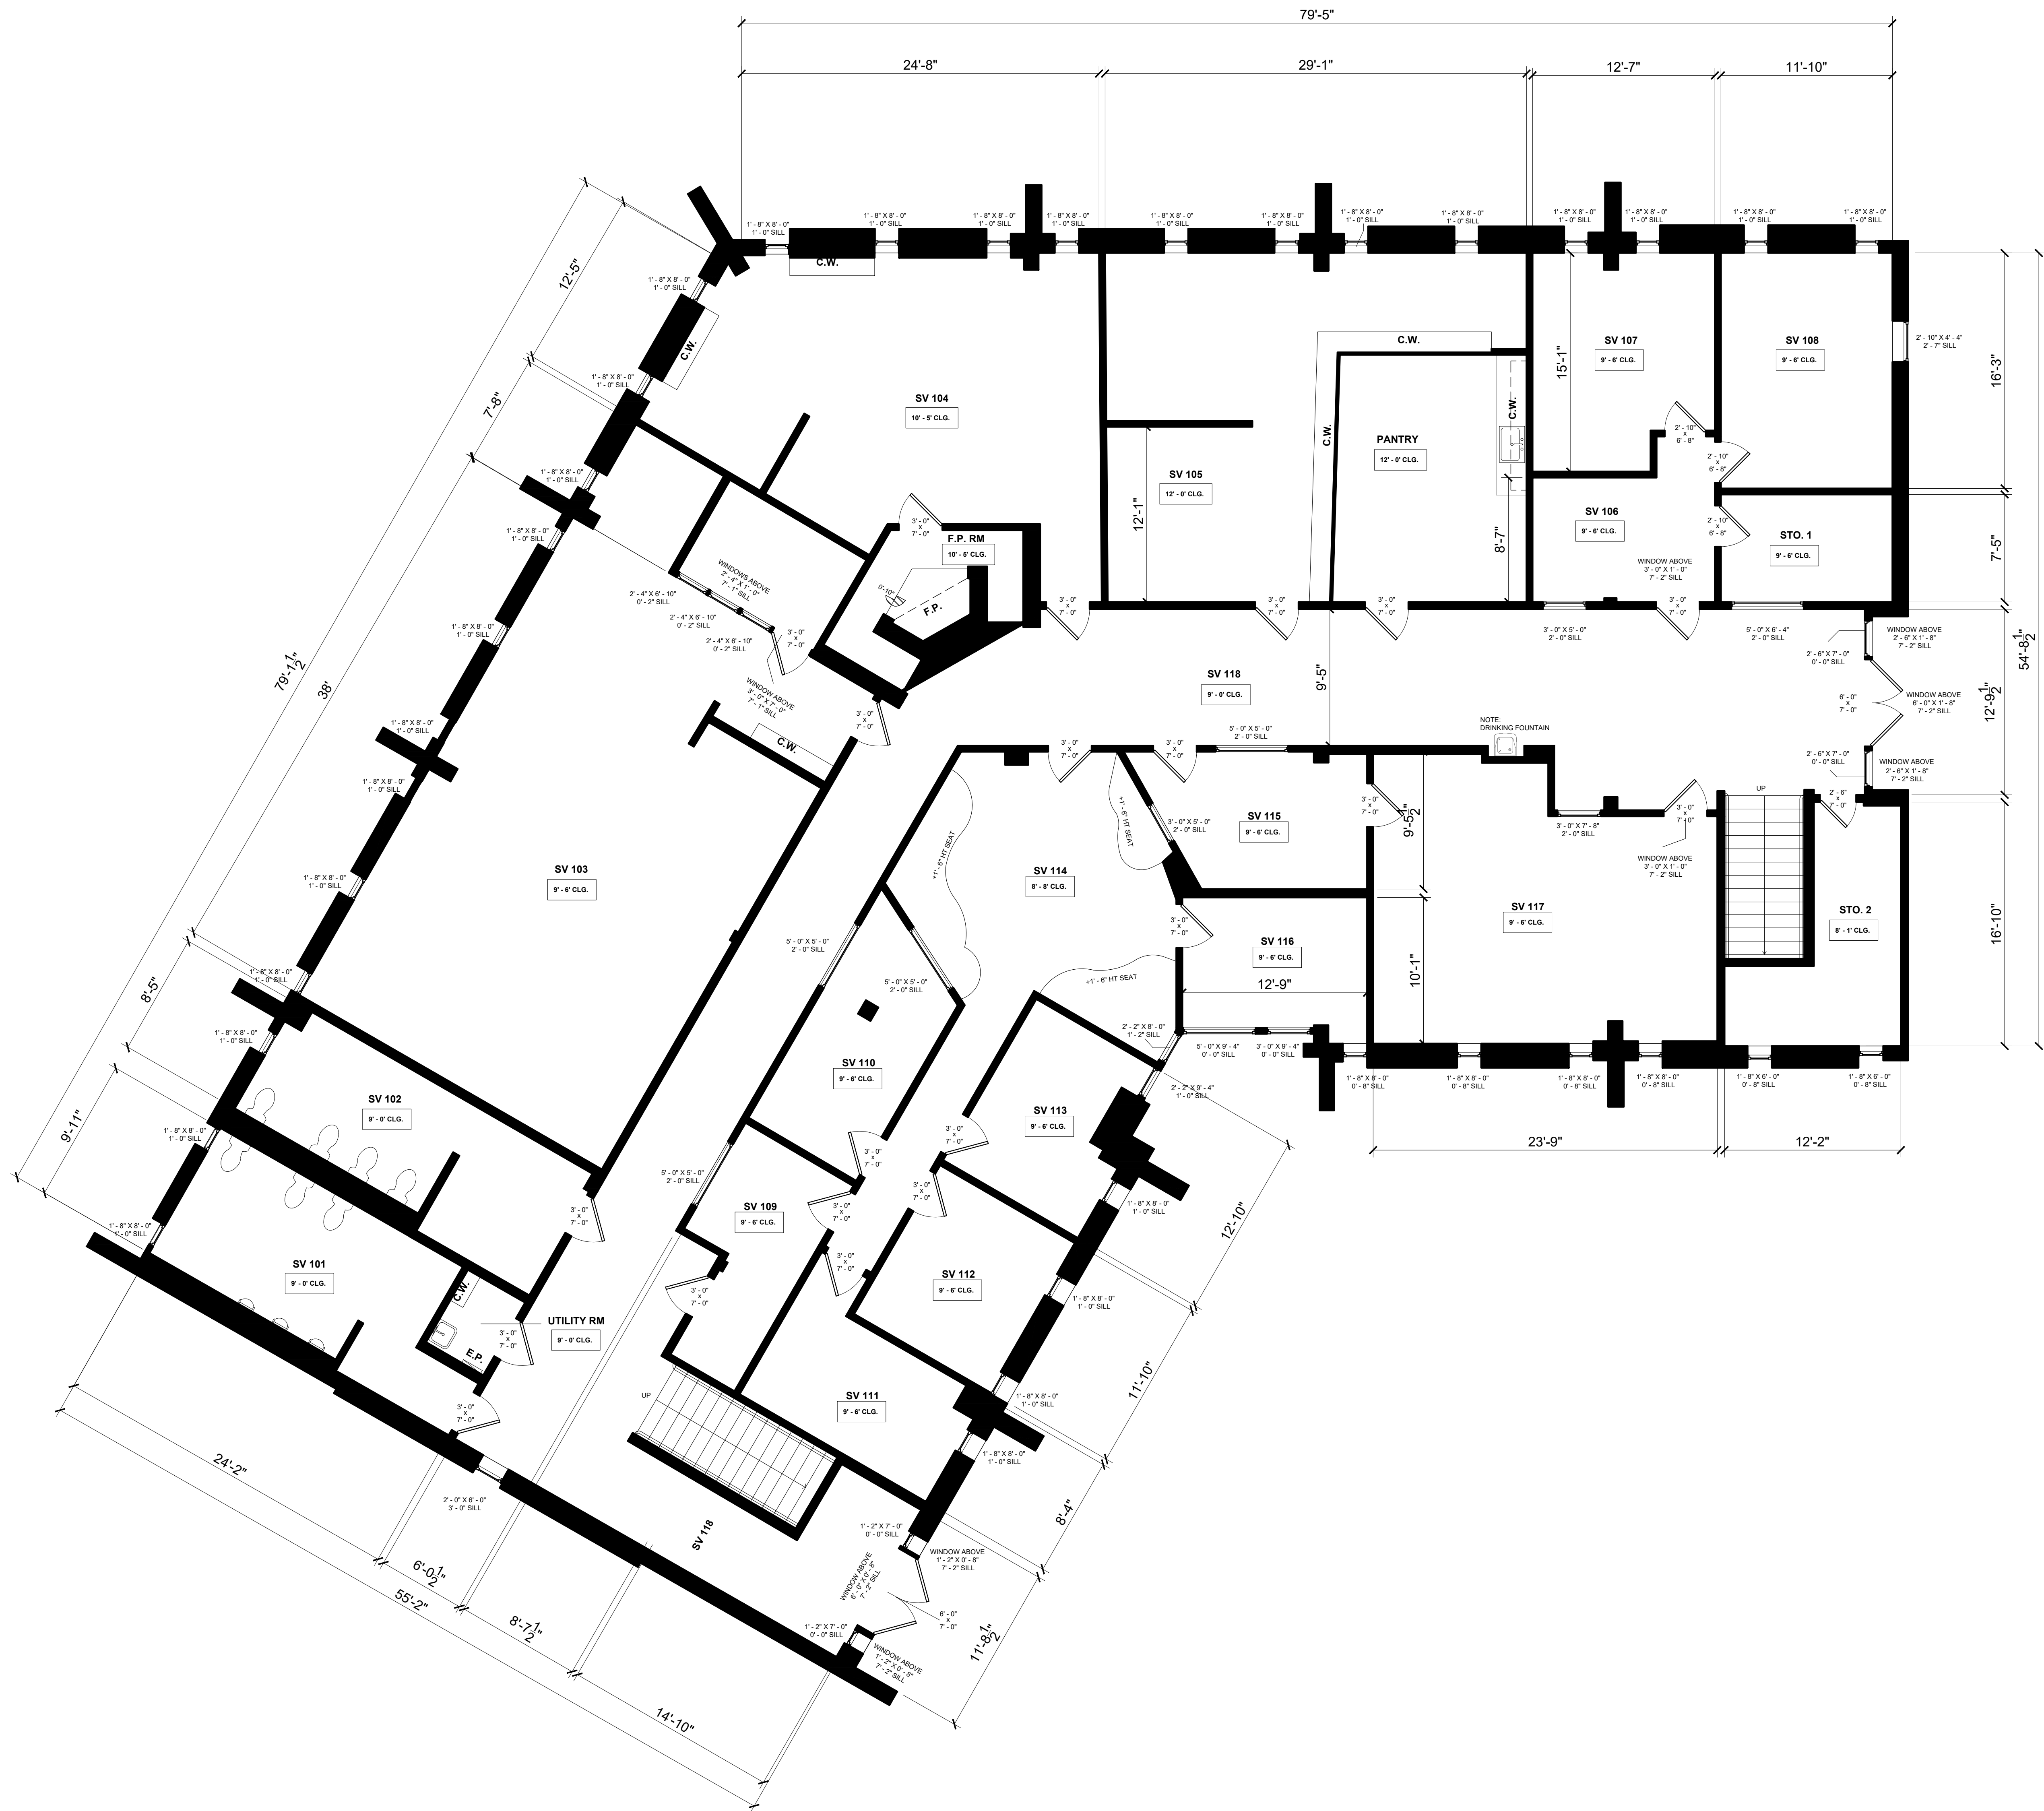

FLOOR PLAN LEGEND	
	WINDOW WIDTH X HEIGHT - SILL HEIGHT
C.W.	CASEWORK / CABINETRY / BUILT-INS
C.T.	COUNTERTOP / ISLAND
F.P.	FIREPLACE
T.O.	TOP OF
B.O.	BOTTOM OF
+X' - X' CLG.	CEILING AT HIGHEST POINT
+X' - X'	LEVEL CHANGE
X'	STEP DIRECTION & HEIGHT

HARVARD
WESTLAKE
SCHOOL

A
B
L
A

AS BUILT LA

21255 BURBANK BLVD, STE 120
WOODLAND HILLS, CA 91367
WWW.ASBUILT.LA.COM
INFO@ASBUILT.LA.COM
(818)-208-3616

NOTES REGARDING AREA SIZING	
* AREA MEASUREMENTS ARE BASED ON TOTAL SQUARE FOOTAGE MEASURED FROM THE INTERIOR SIDE OF THE WALLS IN ADDITION TO THE EXTERIOR SIDE OF WALLS.	
** AREA CALCULATIONS ARE COMPLIMENTARY AND WILL NOT NECESSARILY MATCH WHAT IS ON BUILDING OR REAL ESTATE RECORDS.	
*** IT'S THE RESPONSIBILITY OF THE PROJECT DESIGN PROFESSIONAL TO DETERMINE THE PROPER BREAKDOWN OF SPACES SIZES AS REQUIRED PER LOCAL REGULATIONS, BUILDING AND PLANNING CODES AND PROVIDE COMPLIANCE DOCUMENTATION AS REQUIRED.	
**** WE RECOMMEND TO ALL OUR CUSTOMERS TO GET A LAND SURVEY OF THEIR PROPERTY WHICH PROVIDES ANOTHER LEVEL OF ACCURACY, SIZING INFORMATION FOR THE PROPERTY, BOUNDARIES, AND AS IS OFTEN REQUIRED BY CITY BUILDING & PLANNING DEPARTMENTS FOR PLAN CHECK REVIEWS.	

DRAWN BY:	M.M.B
CHECKED BY:	N.D.B
DATE:	01/09/2026
PROJECT ID	4578
SHEET SIZE	48" X 36"
DELIVERABLES	2D CAD & PDF

SCOPE OF WORK	
As Built Set	

AREA CALCULATIONS	
SV 101	213 SF
SV 102	210 SF
SV 103	1080 SF
SV 104	549 SF
SV 105	466 SF
SV 106	119 SF
SV 107	177 SF
SV 108	192 SF
SV 109	113 SF
SV 110	139 SF
SV 111	131 SF
SV 112	128 SF
SV 113	122 SF
SV 114	378 SF
SV 115	134 SF
SV 116	118 SF
SV 117	422 SF
SV 118	1262 SF
Existing Utility RM - Interior 2ND FL	26 SF
Existing Stn. 1 - Interior 2ND FL	88 SF
Existing Stn. 2 - Interior 2ND FL	135 SF
Existing Pantry - Interior 2ND FL	226 SF
Existing F.P RM - Interior 2ND FL	106 SF
Existing Building - Interior - World Language Center	7280 SF
Existing Building - Interior - Mudd Library 1ST FL	8157 SF
Existing Building - Interior - Mudd Library 2ND FL	6982 SF
Existing Building - Interior - Seaver 2ND FL	7037 SF
Existing Building - Interior - Seaver 3RD FL	8250 SF

PROJECT ADDRESS:	
3700 Coldwater Canyon Ave. Los Angeles, CA 91604	

SHEET TITLE:	
Seaver Building Floor Plans	
SCALE:	AS NOTED
SHEET NUMBER:	AB-116

1 SEAVER BUILDING - EXISTING SECOND FLOOR PLAN
3/16" = 1'-0"

AS BUILT LA
21255 BURBANK BLVD, STE 120
WOODLAND HILLS, CA 91367
WWW.ASBUILTLA.COM
INFO@ASBUILTLA.COM
(818)-208-3616

NOTES REGARDING AREA SIZING * AREA MEASUREMENTS ARE BASED ON TOTAL SQUARE FOOTAGE MEASURED FROM THE INTERIOR SIDE OF THE WALLS IN ADDITION TO THE EXTERIOR SIDE OF WALLS. ** AREA CALCULATIONS ARE COMPLIMENTARY AND WILL NOT NECESSARILY MATCH WHAT IS ON BUILDING OR REAL ESTATE RECORDS. *** IT'S THE RESPONSIBILITY OF THE PROJECT DESIGN PROFESSIONAL TO DETERMINE THE PROPER BREAKDOWN OF SPACES SIZES AS REQUIRED PER LOCAL REGULATIONS, BUILDING AND PLANNING CODES AND CURRENT COMPLIANT CODES AND STANDARDS.	DRAWN BY:	M.M.M
	CHECKED BY:	N.D.B
	DATE:	01/09/2026
	PROJECT ID	4578
	SHEET SIZE	48" X 36"
DELIVERABLES	2D CAD & PDF	

** AREA CALCULATIONS ARE COMPLIMENTARY AND WILL NOT NECESSARILY MATCH WHAT IS ON BUILDING OR REAL ESTATE RECORDS.	SHEET SIZE	48" X 36"
---	-------------------	-----------

*** IT'S THE RESPONSIBILITY OF THE PROJECT DESIGN PROFESSIONAL TO DETERMINE THE PROPER BREAKDOWN OF SPACES SIZES AS REQUIRED PER LOCAL REGULATIONS, BUILDING AND PLANNING CODES AND PROVIDE COMPLIANCE DOCUMENTATION AS REQUIRED.		
	SCOPE OF WORK	

FROM PLAT DOCUMENTATION AS REQUIRED. **** WE RECOMMEND TO ALL OUR CUSTOMERS TO GET A LAND SURVEY OF THEIR PROPERTY WHICH PROVIDES ANOTHER LEVEL OF ACCURACY. SIZING INFORMATION FOR THE PROPERTY, BOUNDARIES, AND AS IS OFTEN REQUIRED BY CITY BUILDING & PLANNING DEPARTMENTS FOR PLAN CHECK REVIEWS.	SCOPE OF WORK As Built Set
--	---

AREA CALCULATIONS	
SV 119	731 SF
SV 120	651 SF
SV 121	466 SF
SV 122	464 SF
SV 123	458 SF
SV 124	542 SF
SV 125	509 SF
SV 126	384 SF
SV 127	555 SF
SV 128	536 SF
SV 129	220 SF
SV 130	196 SF
SV 131	1393 SF
SV 132	243 SF
Existing Building - Interior - World Language Center	7280 SF
Existing Building - Interior - Middle Library 1ST FL	8157 SF
Existing Building - Interior - Middle Library 2ND FL	6982 SF
Existing Building - Interior - Seaver	8250 SF

PROJECT ADDRESS:


3700 Coldwater Canyon
Ave. Los Angeles, CA 91604

SHEET TITLE:


Seaver Building
Floor Plans

SCALE: AS NOTED

SHEET NUMBER: AB-117

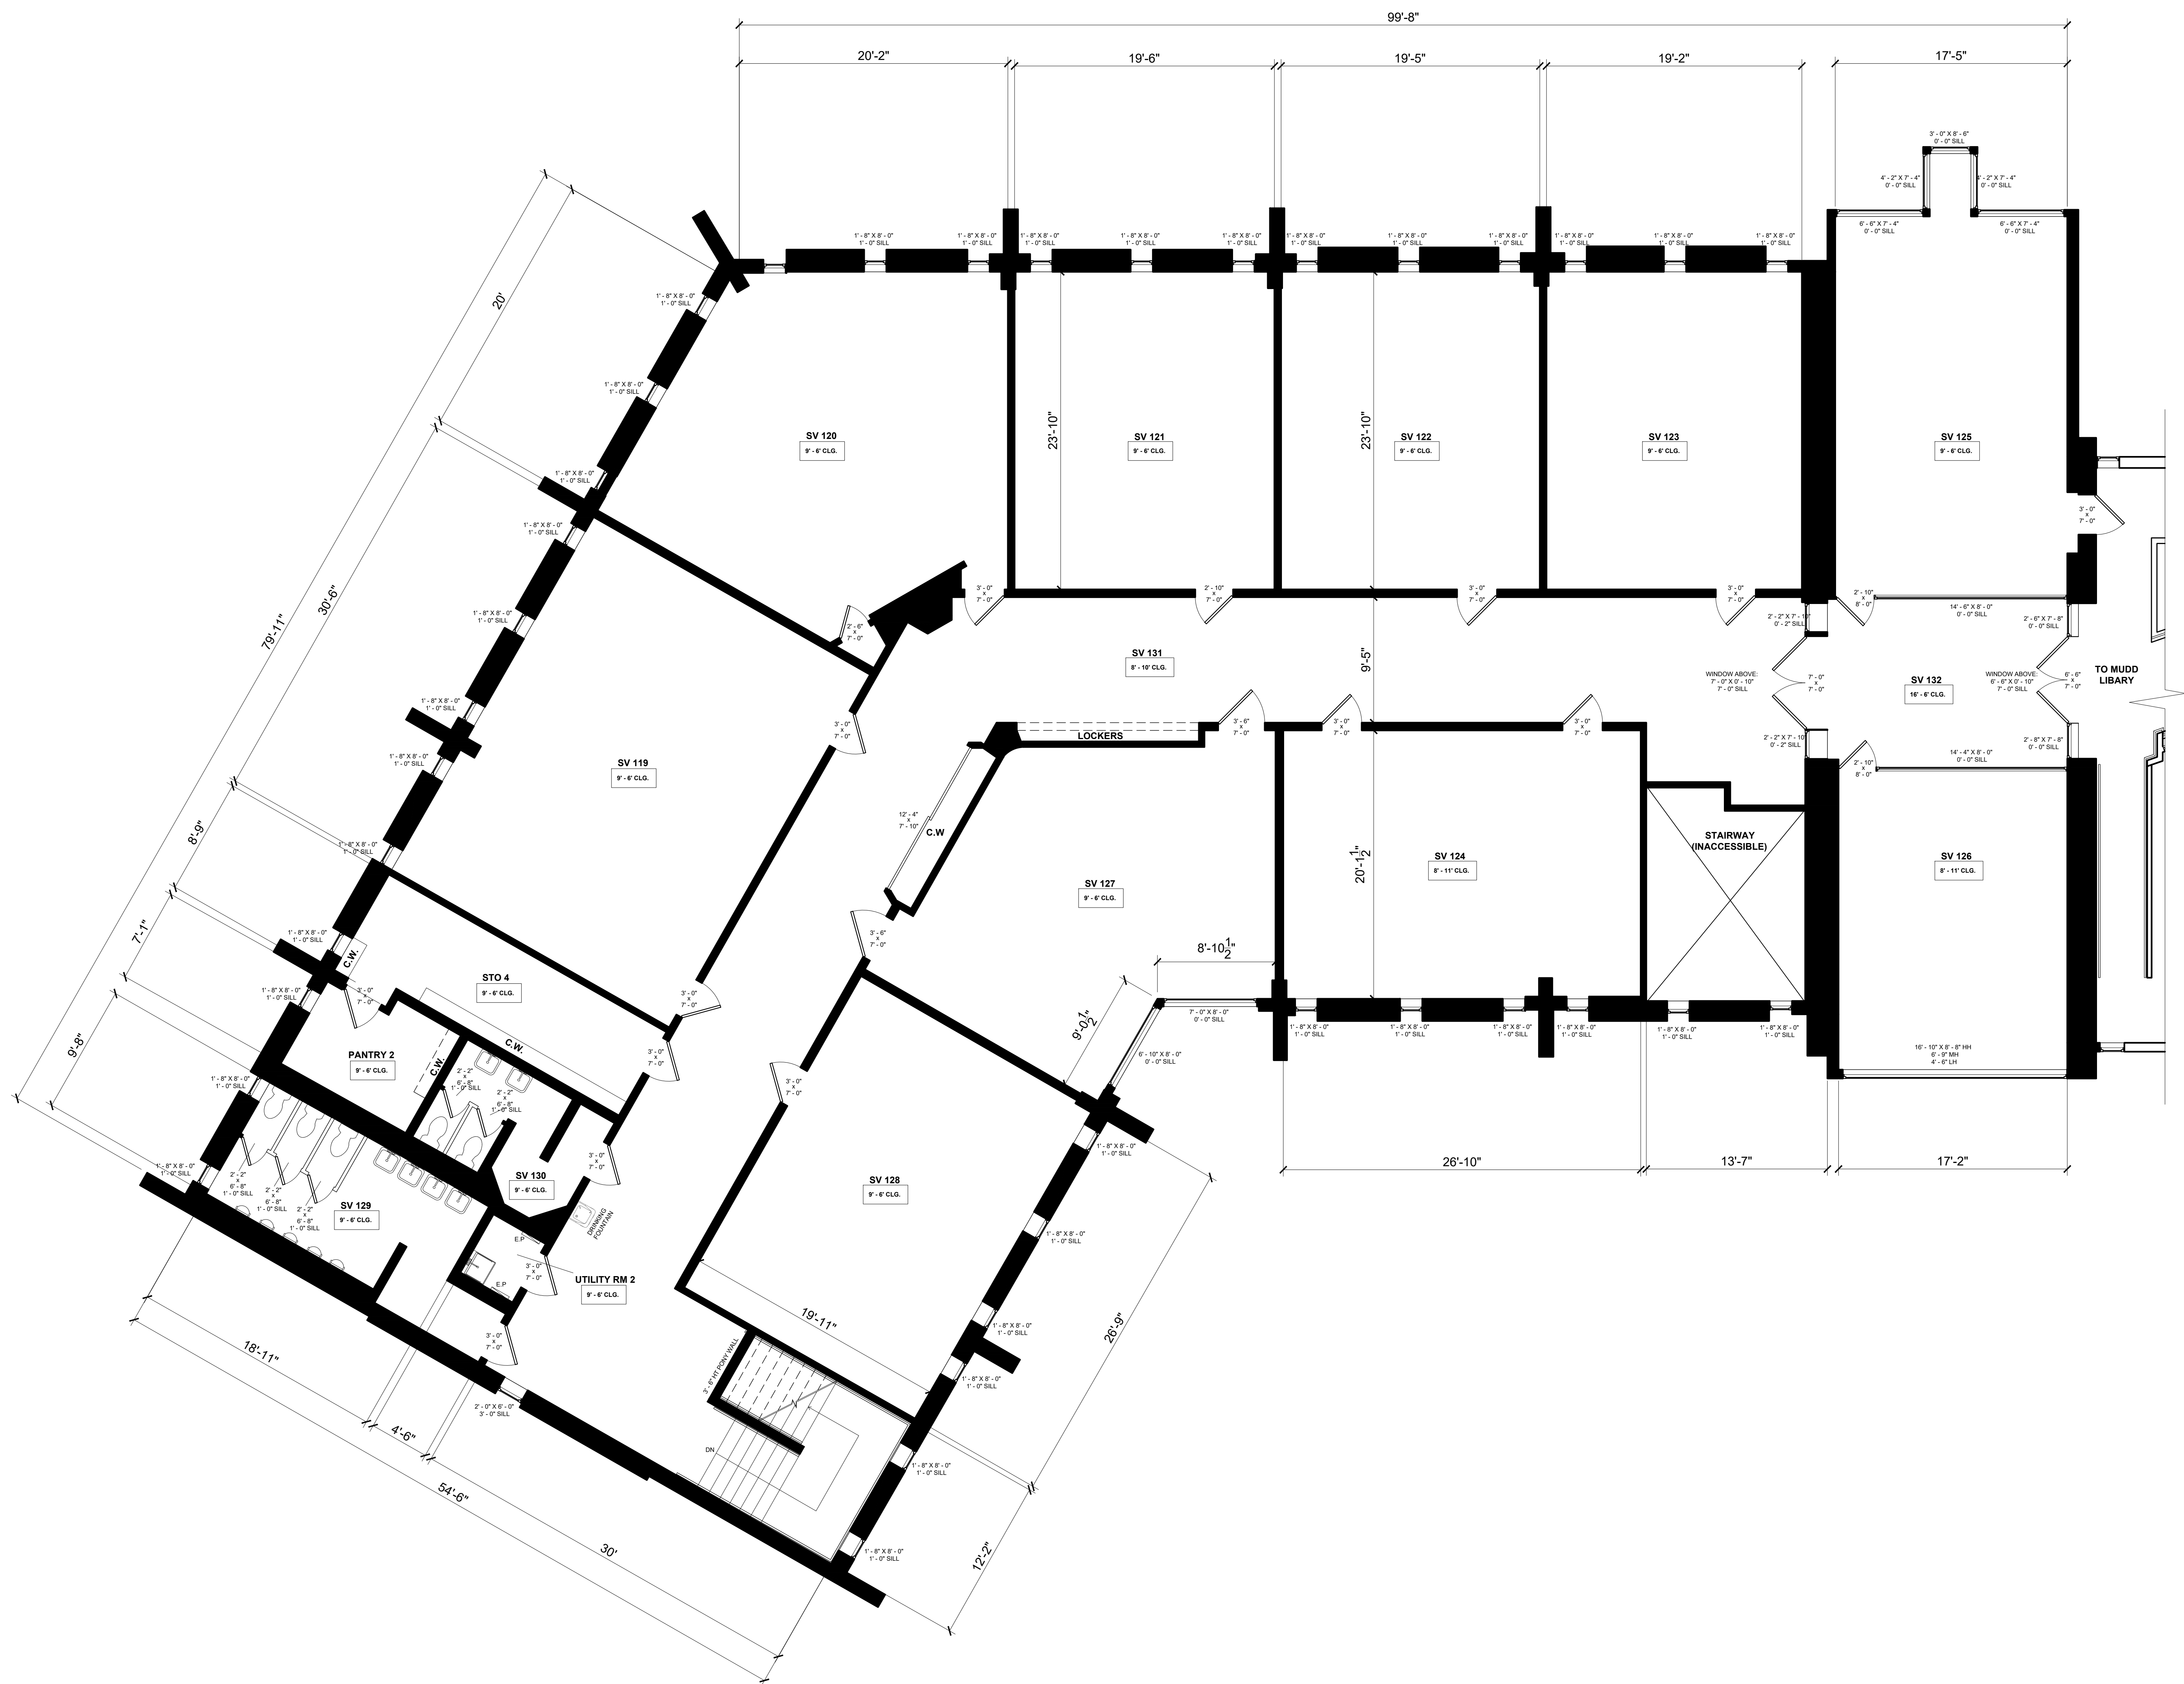

1 SEAVER BUILDING - EXISTING THIRD FLOOR PLAN
3/16" = 1'-0"

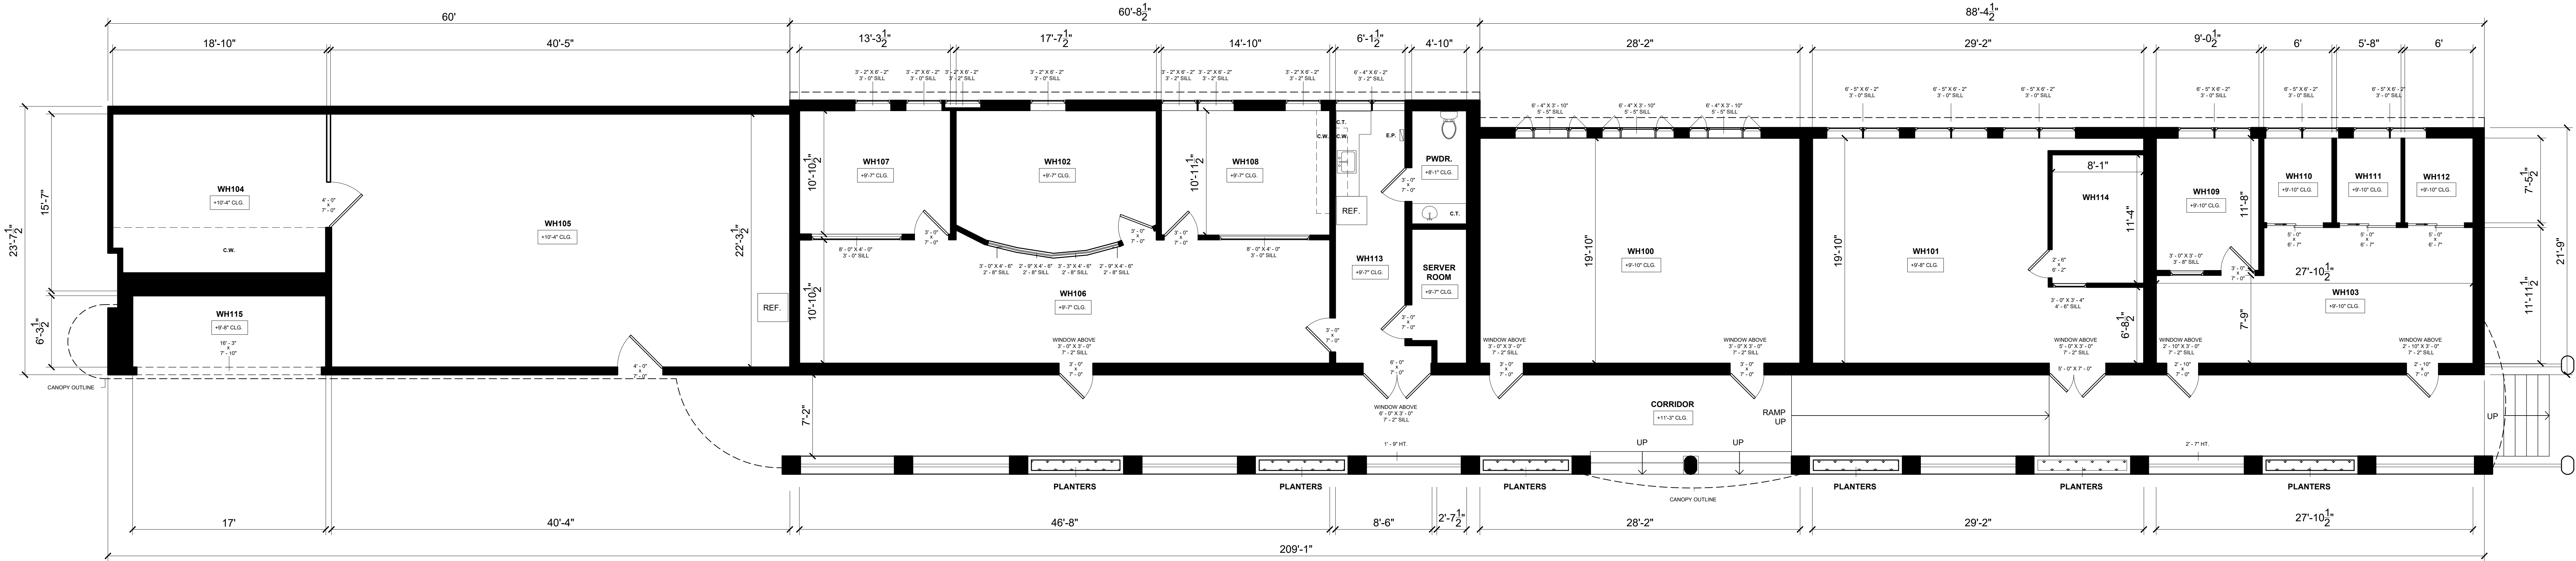

1 WEILER HALL - EXISTING FLOOR PLAN
3/16" = 1'-0"

FLOOR PLAN LEGEND	
	WINDOW WIDTH X HEIGHT - SILL HEIGHT
C.W.	CASEWORK / CABINETRY / BUILT-INS
C.T.	COUNTERTOP / ISLAND
F.P.	FIREPLACE
T.O.	TOP OF
B.O.	BOTTOM OF
+X" - X" CLG.	CEILING AT HIGHEST POINT
+X" - X"	LEVEL CHANGE
X"	STEP DIRECTION & HEIGHT

NOTES REGARDING AREA SIZING

* AREA MEASUREMENTS ARE BASED ON TOTAL SQUARE FOOTAGE MEASURED FROM THE INTERIOR SIDE OF THE WALLS IN ADDITION TO THE EXTERIOR SIDE OF WALLS.

** AREA CALCULATIONS ARE COMPLIMENTARY AND WILL NOT NECESSARILY MATCH WHAT IS ON BUILDING OR REAL ESTATE RECORDS.

*** IT'S THE RESPONSIBILITY OF THE PROJECT DESIGN PROFESSIONAL TO DETERMINE THE PROPER BREAKDOWN OF SPACES SIZES AS REQUIRED PER LOCAL REGULATIONS.

**** WE RECOMMEND TO ALL OUR CUSTOMERS TO GET A LAND SURVEY OF THEIR PROPERTY WHICH PROVIDES ANOTHER LEVEL OF ACCURACY, SIZING INFORMATION FOR THE PROPERTY. BOUNDARIES, AND AS IS OFTEN REQUIRED BY CITY BUILDING & PLANNING DEPARTMENTS FOR PLAN CHECK REVIEWS.

HARVARD
WESTLAKE
SCHOOL

A
B
L
A


AS BUILT LA
21255 BURBANK BLVD, STE 120
WOODLAND HILLS, CA 91367
WWW.ASBUILTLA.COM
INFO@ASBUILTLA.COM
(818)-208-3616

DRAWN BY:	R.C.M.
CHECKED BY:	F.P.S.
DATE:	01/09/2026
PROJECT ID	4578
SHEET SIZE	48" X 36"
DELIVERABLES	2D CAD & PDF

SCOPE OF WORK	
As Built Set	

AREA CALCULATIONS	
Existing Residence - Interior	4,390 SF
Existing Residence - Exterior	4,800 SF
WH100	560 SF
WH101	477 SF
WH102	205 SF
WH103	293 SF
WH104	290 SF
WH105	900 SF
WH106	495 SF
WH107	145 SF
WH108	162 SF
WH109	105 SF
WH110	45 SF
WH111	42 SF
WH112	45 SF
WH113	140 SF
WH114	92 SF
WH115	107 SF

PROJECT ADDRESS:	
3700 Coldwater Canyon Ave. Los Angeles, CA 91604	
SHEET TITLE:	
Weiler Hall Floor Plans	
SCALE:	AS NOTED
SHEET NUMBER:	AB-118

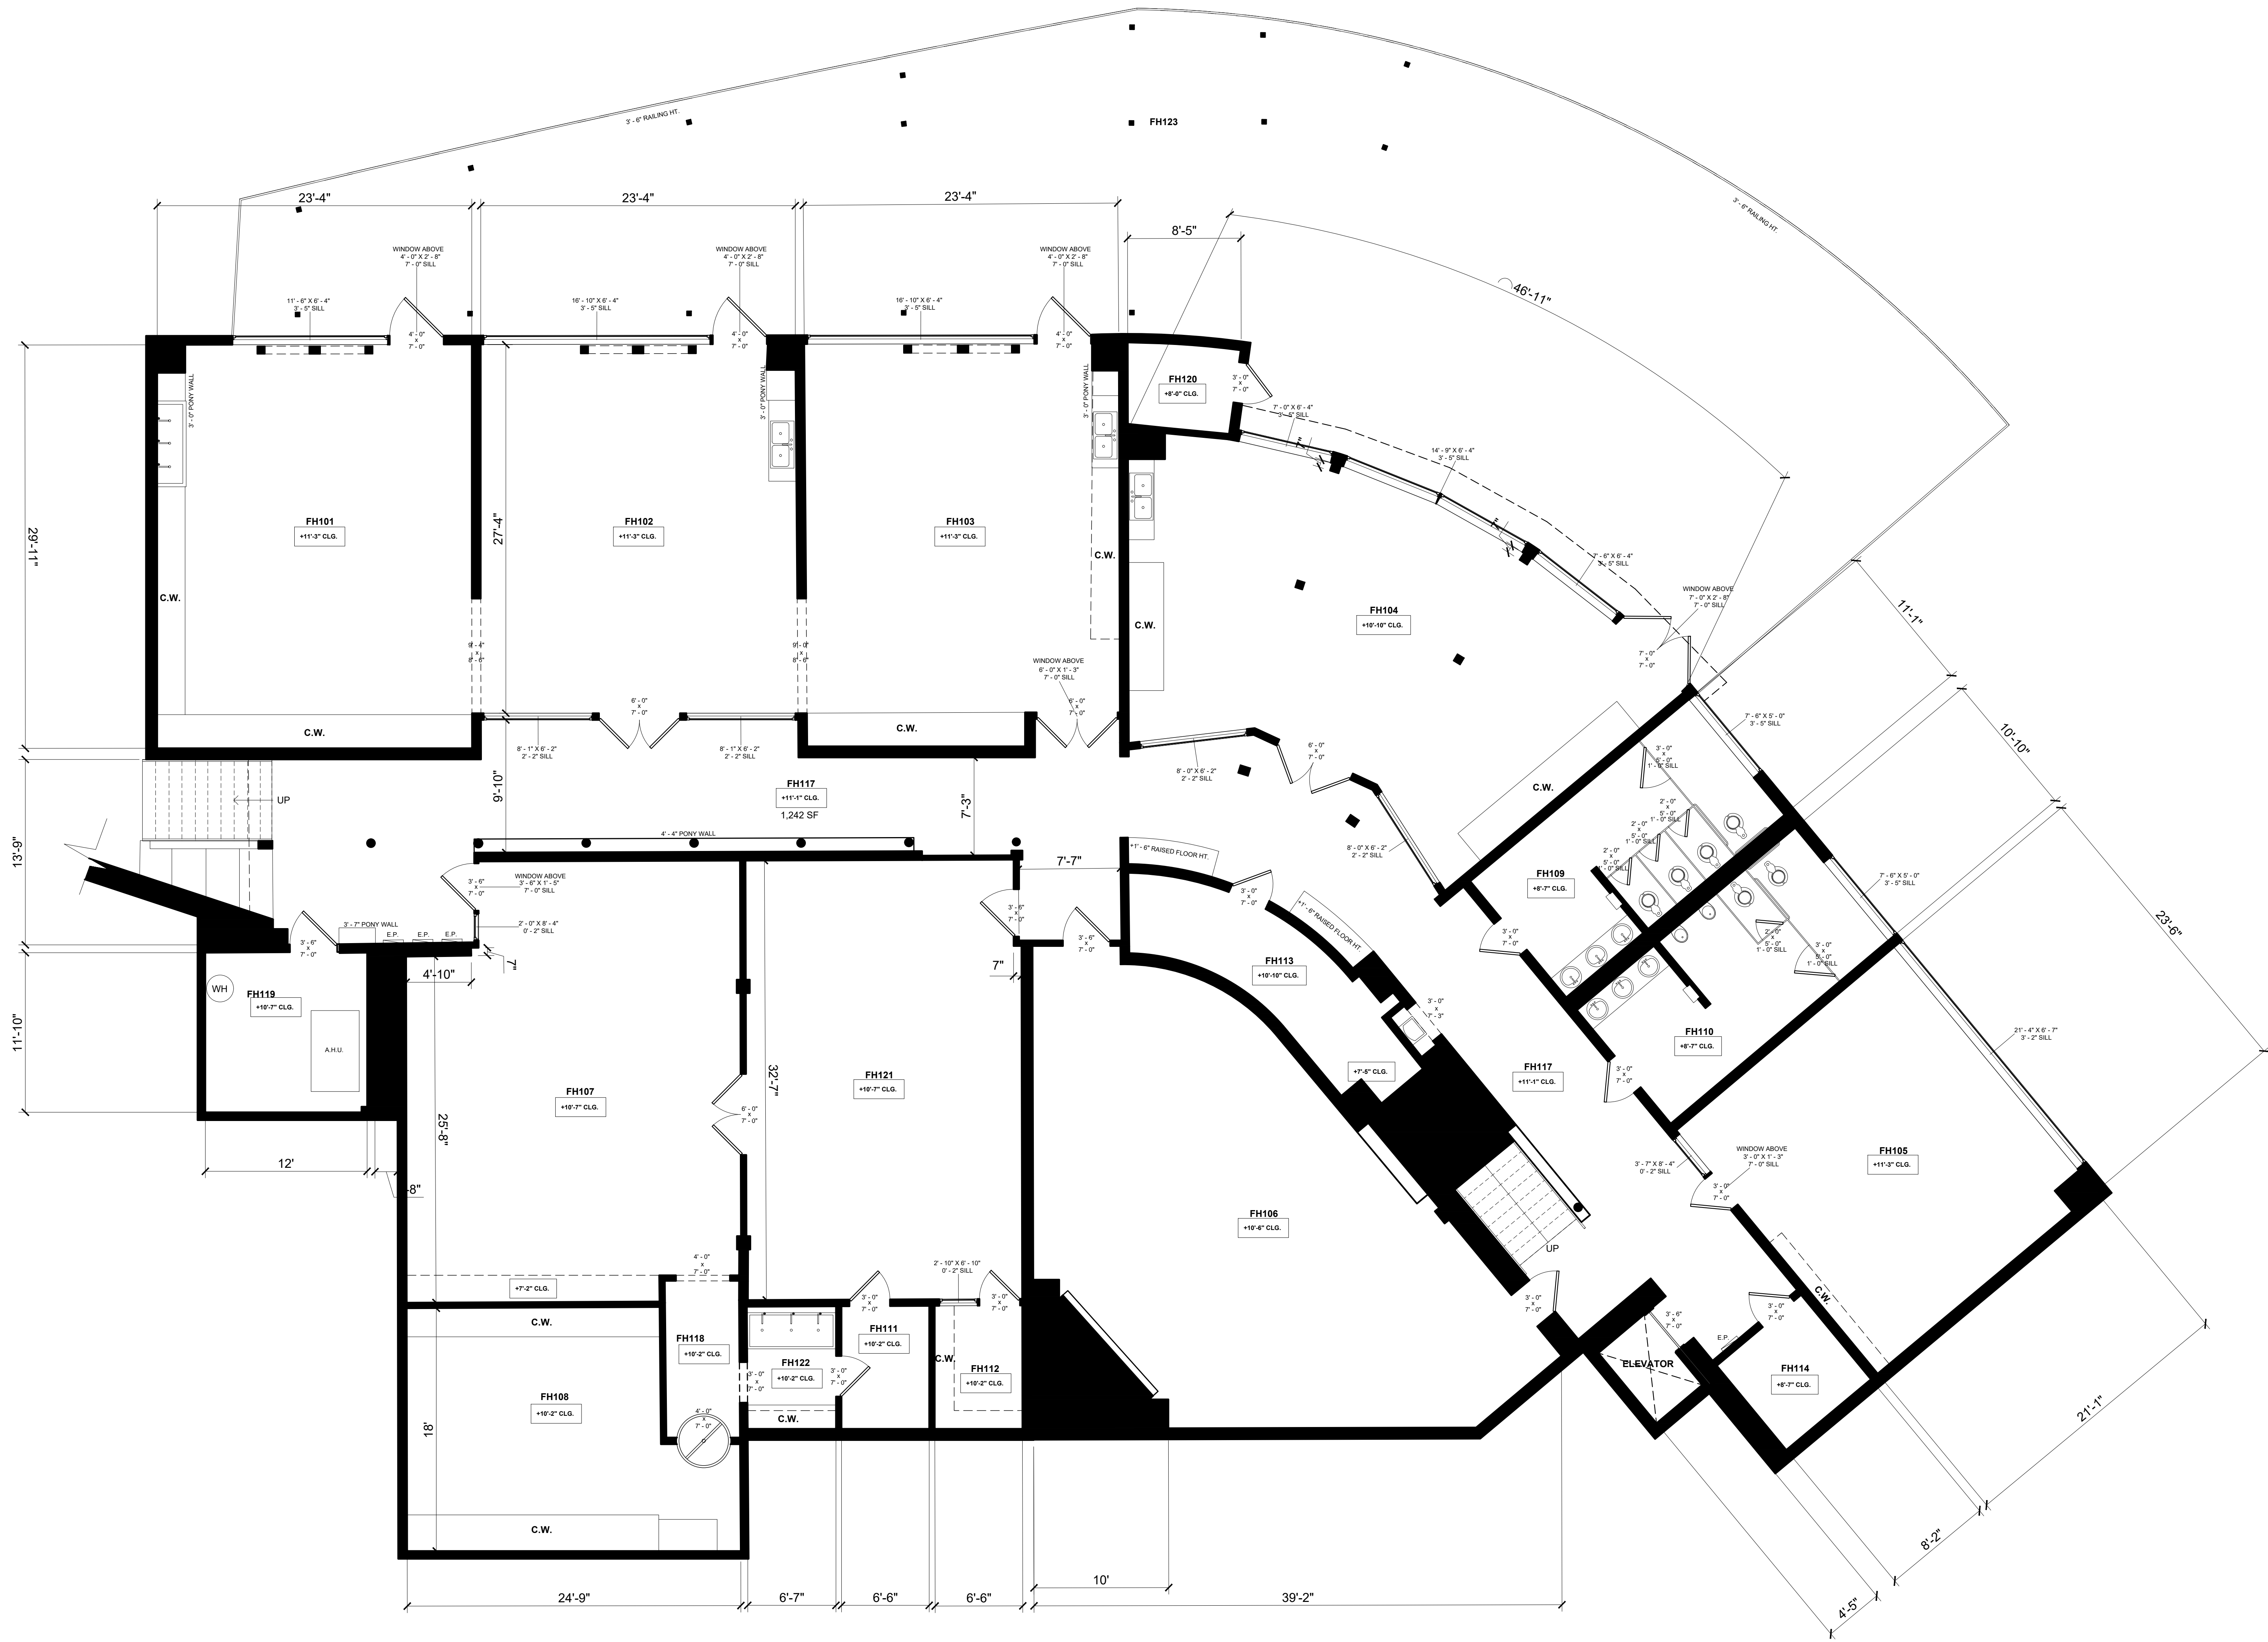

1 FELDMAN HALL - EXISTING GROUND FLOOR PLAN
3/16" = 1'-0"

FLOOR PLAN LEGEND	
	WINDOW WIDTH X HEIGHT - SILL HEIGHT
C.W.	CASEWORK / CABINETRY / BUILT-INS
C.T.	COUNTERTOP / ISLAND
F.P.	FIREPLACE
T.O.	TOP OF
B.O.	BOTTOM OF
+X' - X' CLG.	CEILING AT HIGHEST POINT
+X' - X'	LEVEL CHANGE
X'	STEP DIRECTION & HEIGHT

HARVARD
WESTLAKE
SCHOOL

ABLA

AS BUILT LA
21255 BURBANK BLVD, STE 120
WOODLAND HILLS, CA 91367
WWW.ASBUILT.LA.COM
INFO@ASBUILT.LA.COM
(818)-208-3616

NOTES REGARDING AREA SIZING	DRAWN BY:	J.H.B.
	CHECKED BY:	F.P.S.
	DATE:	01/09/2026
	PROJECT ID	4578
	SHEET SIZE	48" X 36"
	DELIVERABLES	2D CAD & PDF

SCOPE OF WORK


As Built Set


*** IT'S THE RESPONSIBILITY OF THE PROJECT DESIGN PROFESSIONAL TO DETERMINE THE PROPER BREAKDOWN OF SPACES SIZES AS REQUIRED PER LOCAL REGULATIONS, BUILDING AND PLANNING CODES AND PROVIDE COMPLIANCE DOCUMENTATION AS REQUIRED.

**** WE RECOMMEND TO ALL OUR CUSTOMERS TO GET A LAND SURVEY OF THEIR PROPERTY WHICH PROVIDES ANOTHER LEVEL OF ACCURACY, SIZING INFORMATION FOR THE PROPERTY, BOUNDARIES, AND AS IS OFTEN REQUIRED BY CITY BUILDING & PLANNING DEPARTMENTS FOR PLAN CHECK REVIEWS.

AREA CALCULATIONS	
Existing Residence 1ST FL - Interior	9,135 SF
Existing Residence 2ND FL - Interior	4,631 SF
Existing Residence 2ND FL - Exterior	5,068 SF
FH101	694 SF
FH102	637 SF
FH103	672 SF
FH104	799 SF
FH105	490 SF
FH106	886 SF
FH107	760 SF
FH108	386 SF
FH109	234 SF
FH110	230 SF
FH111	60 SF
FH112	60 SF
FH113	152 SF
FH114	66 SF
FH115	162 SF
FH116	211 SF
FH117	1,242 SF
FH118	64 SF
FH119	142 SF
FH120	53 SF
FH121	661 SF
FH122	60 SF
FH123	2,953 SF
FH124	726 SF
FH125	706 SF
FH126	711 SF
FH127	917 SF
FH128	492 SF
FH129	491 SF
FH130	51 SF

PROJECT ADDRESS:	
3700 Coldwater Canyon Ave. Los Angeles, CA 91604	
SHEET TITLE:	
Feldman Hall Floor Plans	
SCALE:	AS NOTED
SHEET NUMBER:	AB-119

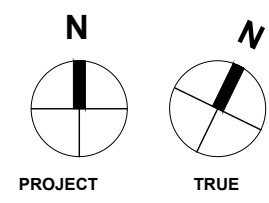

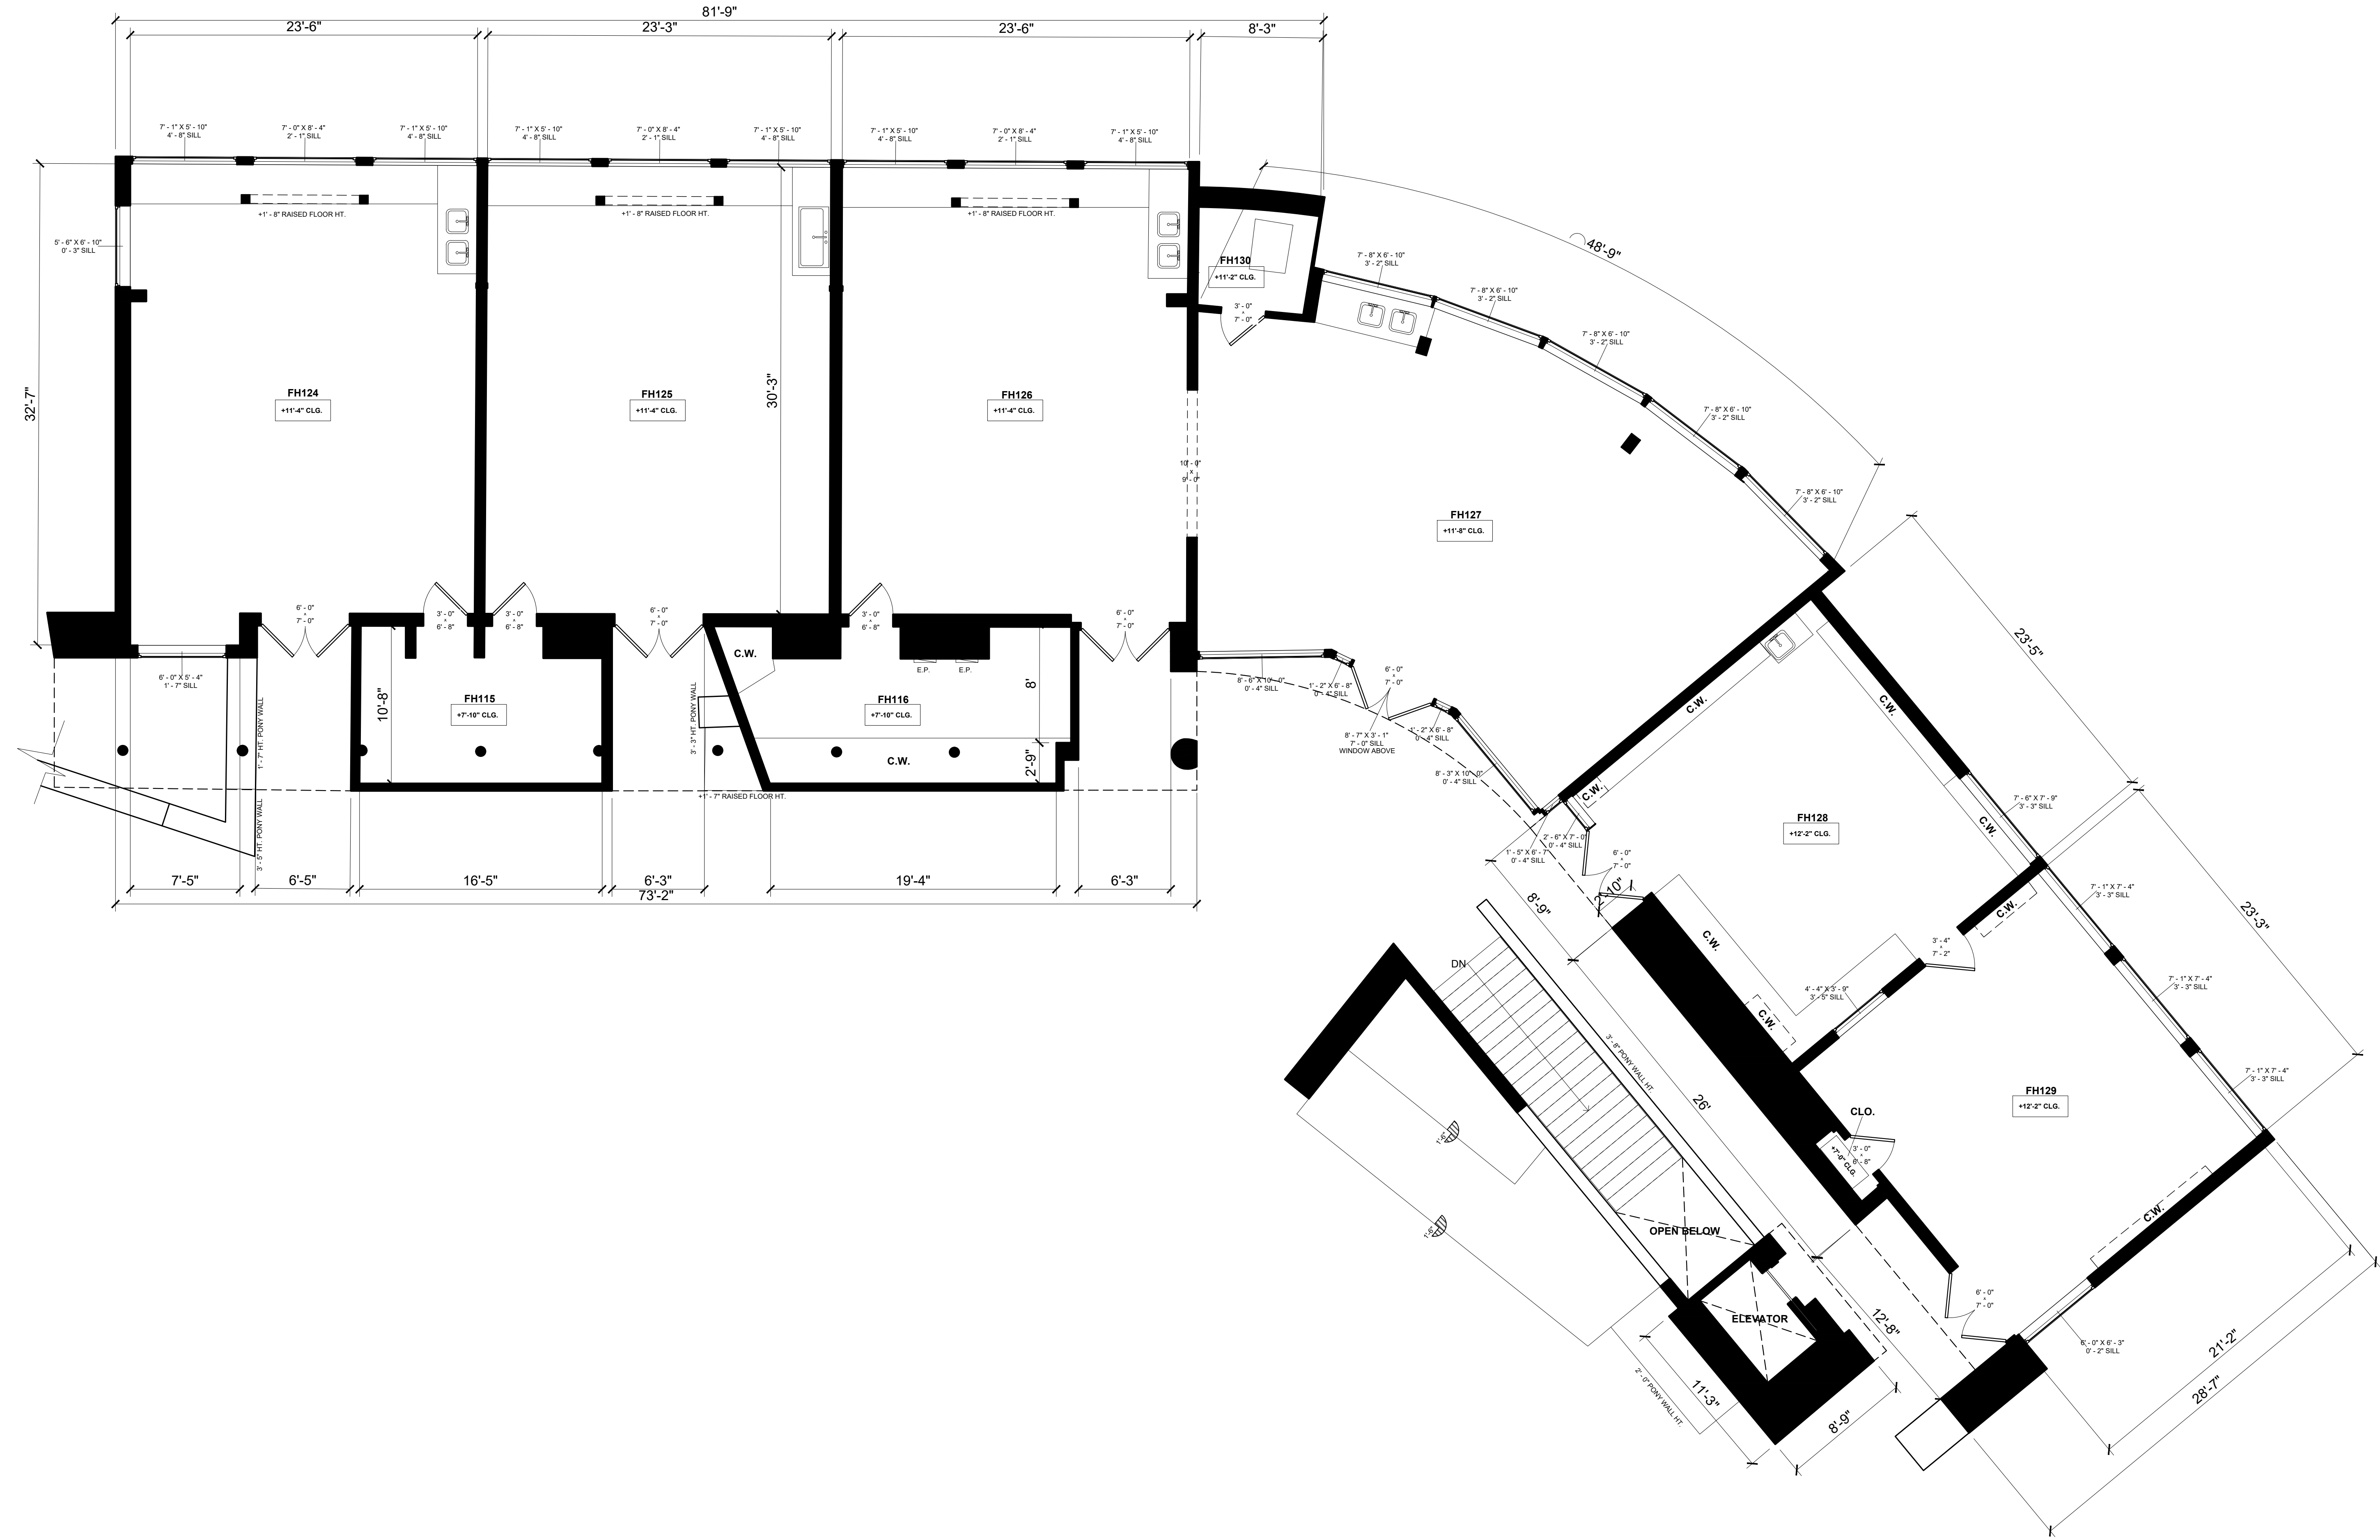

① FELDMAN HALL - EXISTING GROUND FLOOR PLAN
3/16" = 1'-0"

FLOOR PLAN LEGEND	
	WINDOW WIDTH X HEIGHT - SILL HEIGHT
C.W.	CASEWORK / CABINETRY / BUILT-INS
C.T.	COUNTERTOP / ISLAND
F.P.	FIREPLACE
T.O.	TOP OF
B.O.	BOTTOM OF
+X' - X' CLG.	CEILING AT HIGHEST POINT
+X' - X'	LEVEL CHANGE
	STEP DIRECTION & HEIGHT

NOTES REGARDING AREA SIZING	
* AREA MEASUREMENTS ARE BASED ON TOTAL SQUARE FOOTAGE MEASURED FROM THE INTERIOR SIDE OF THE WALLS IN ADDITION TO THE EXTERIOR SIDE OF WALLS.	
** AREA CALCULATIONS ARE COMPLIMENTARY AND WILL NOT NECESSARILY MATCH WHAT IS ON BUILDING OR REAL ESTATE RECORDS.	
*** IT'S THE RESPONSIBILITY OF THE PROJECT DESIGN PROFESSIONAL TO DETERMINE THE PROPER BREAKDOWN OF SPACES SIZES AS REQUIRED PER LOCAL REGULATIONS, BUILDING AND PLANNING CODES AND PROVIDE COMPLIANCE DOCUMENTATION AS REQUIRED.	
**** WE RECOMMEND TO ALL OUR CUSTOMERS TO GET A LAND SURVEY OF THEIR PROPERTY WHICH PROVIDES ANOTHER LEVEL OF ACCURACY, SIZING INFORMATION FOR THE PROPERTY, BOUNDARIES, AND AS IS OFTEN REQUIRED BY CITY BUILDING & PLANNING DEPARTMENTS FOR PLAN CHECK REVIEWS.	

HARVARD
WESTLAKE
SCHOOL

ABLA

AS BUILT LA
21255 BURBANK BLVD, STE 120
WOODLAND HILLS, CA 91367
WWW.ASBUILT.LA.COM
INFO@ASBUILT.LA.COM
(818)-208-3616

DRAWN BY:	J.H.B.
CHECKED BY:	F.P.S.
DATE:	01/09/2026
PROJECT ID	4578
SHEET SIZE	48" X 36"
DELIVERABLES	2D CAD & PDF

SCOPE OF WORK

As Built Set

PROJECT ADDRESS:


3700 Coldwater Canyon
Ave. Los Angeles, CA 91604

SHEET TITLE:

Feldman Hall
Floor Plans

SCALE: AS NOTED

SHEET NUMBER: AB-120

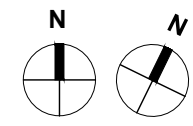


**HARVARD
WESTLAKE
SCHOOL**




AS BUILT LA
21255 BURBANK BLVD. STE 120
WOODLAND HILLS, CA 91367
WWW.ASBUILT.LA
INFO@ASBUILT.LA
(818)-208-3616


SCOPE OF WORK	
As Built Set	

PROJECT ADDRESS:	
3700 Coldwater Canyon Ave. Los Angeles, CA 91604	
SHEET TITLE:	
Alvarez Business Office Floor Plans	
SCALE:	AS NOTED
SHEET NUMBER:	AB-121

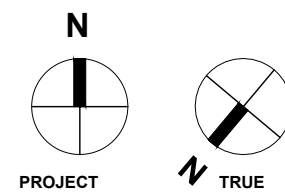

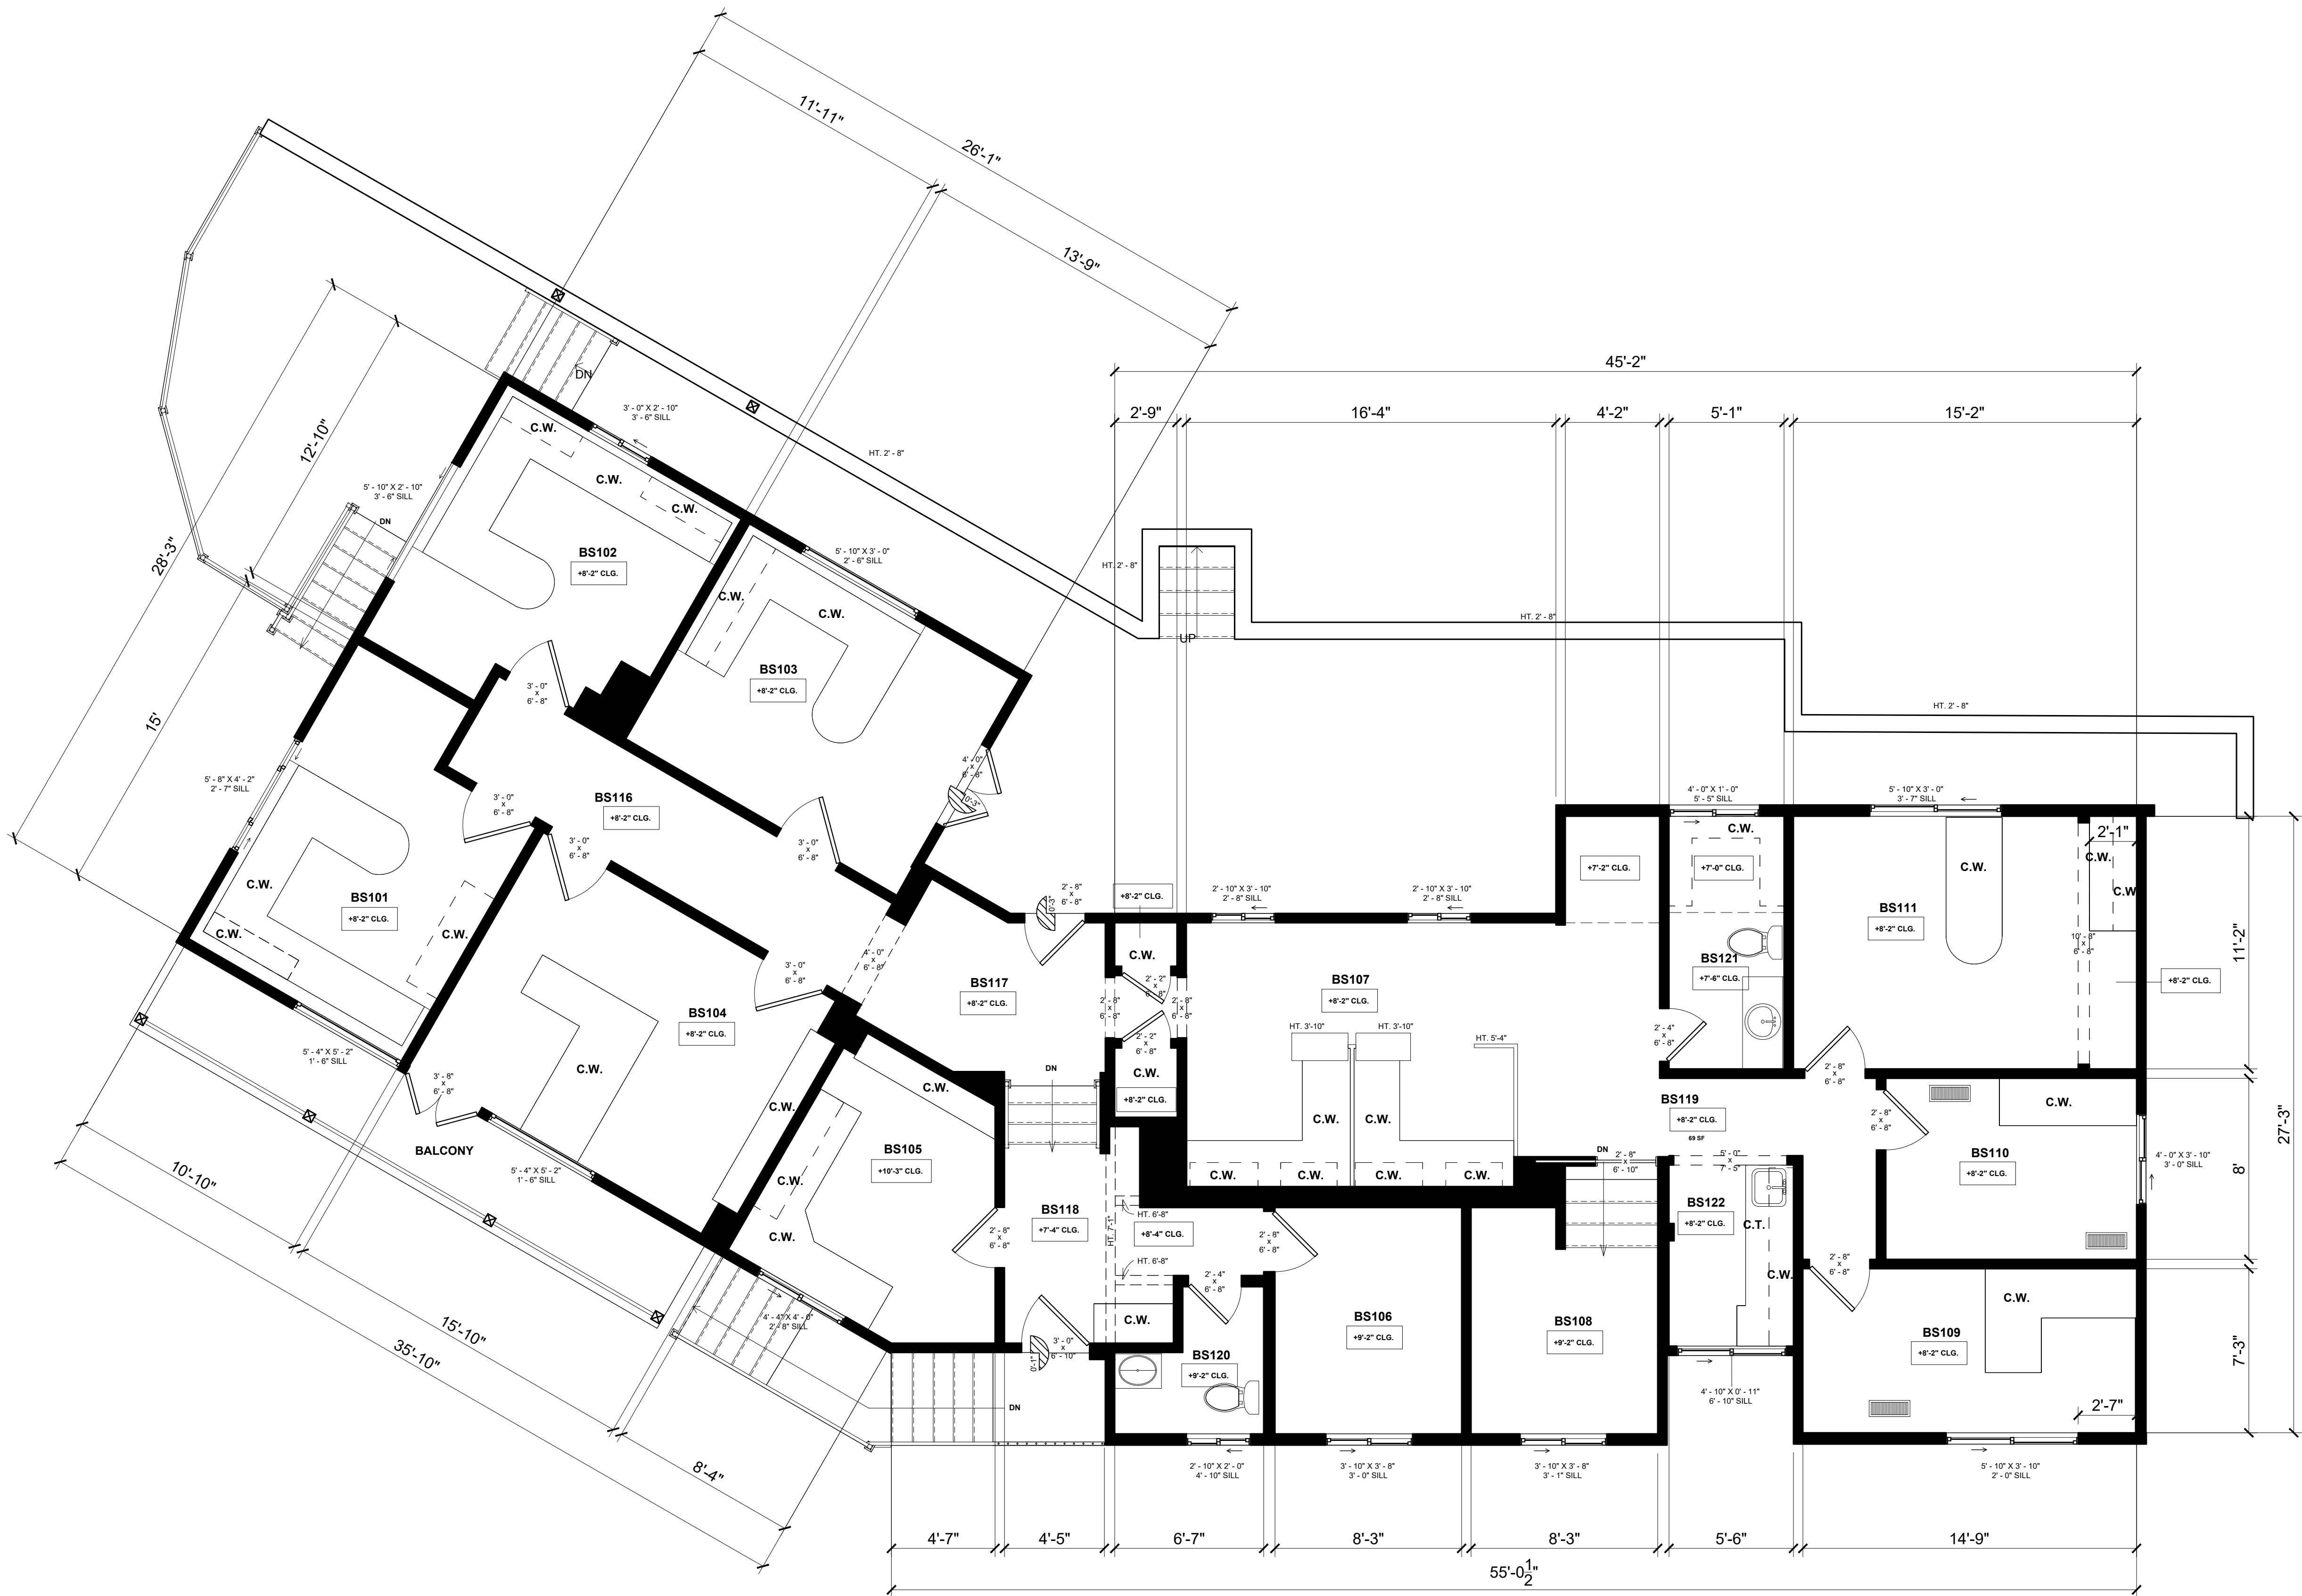

1 ALVAREZ BUSINESS OFFICE - EXISTING SECOND FLOOR PLAN
1/4" = 1'-0"

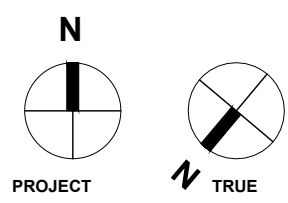

FLOOR PLAN LEGEND	
	WINDOW WIDTH X HEIGHT - SILL HEIGHT
C.W.	CASEWORK / CABINETRY / BUILT-INS
C.T.	COUNTERTOP / ISLAND
F.P.	FIREPLACE
T.O.	TOP OF
B.O.	BOTTOM OF
+X' - X' CLG.	CEILING AT HIGHEST POINT
+X' - X'	LEVEL CHANGE
X'	STEP DIRECTION & HEIGHT

HARVARD WESTLAKE SCHOOL

AS BUILT LA
21255 BURBANK BLVD, STE 120
WOODLAND HILLS, CA 91367
WWW.ASBUILT.LA.COM
INFO@ASBUILT.LA.COM
(818)-208-3616


NOTES REGARDING AREA SIZING	
* AREA MEASUREMENTS ARE BASED ON TOTAL SQUARE FOOTAGE MEASURED FROM THE INTERIOR SIDE OF THE WALLS IN ADDITION TO THE EXTERIOR SIDE OF WALLS.	
** AREA CALCULATIONS ARE COMPLIMENTARY AND WILL NOT NECESSARILY MATCH WHAT IS ON BUILDING OR REAL ESTATE RECORDS.	
*** IT'S THE RESPONSIBILITY OF THE PROJECT DESIGN PROFESSIONAL TO DETERMINE THE PROPER BREAKDOWN OF SPACES SIZES AS REQUIRED PER LOCAL REGULATIONS, BUILDING AND PLANNING CODES AND PROVIDE COMPLIANCE DOCUMENTATION AS REQUIRED.	
**** WE RECOMMEND TO ALL OUR CUSTOMERS TO GET A LAND SURVEY OF THEIR PROPERTY WHICH PROVIDES ANOTHER LEVEL OF ACCURACY, SIZING INFORMATION FOR THE PROPERTY, BOUNDARIES, AND AS IS OFTEN REQUIRED BY CITY BUILDING & PLANNING DEPARTMENTS FOR PLAN CHECK REVIEWS.	

DRAWN BY:	PG
CHECKED BY:	F.P.S.
DATE:	01/09/2026
PROJECT ID:	4578
SHEET SIZE:	48" X 36"
DELIVERABLES:	2D CAD & PDF


SCOPE OF WORK	
As Built Set	

AREA CALCULATIONS	
Existing Business Center - 1st FL Interior	653 SF
Existing Business Center - 1st FL Exterior	726.1 SF
Existing Business Center - 2nd FL Exterior	2123 SF
Existing Business Center - 2nd FL Exterior	2225 SF
BS100	277 SF
BS101	146 SF
BS102	136 SF
BS103	151 SF
BS104	185 SF
BS105	111 SF
BS106	83 SF
BS107	230 SF
BS108	89 SF
BS109	107 SF
BS110	89 SF
BS111	140 SF
BS112	72 SF
BS113	232 SF
BS114	232 SF
BS115	50 SF
BS116	92 SF
BS117	67 SF
BS118	88 SF
BS119	69 SF
BS120	34 SF
BS121	57 SF
BS122	44 SF

PROJECT ADDRESS:	
3700 Coldwater Canyon Ave. Los Angeles, CA 91604	
SHEET TITLE:	
Alvarez Business Office Floor Plans	
SCALE:	AS NOTED
SHEET NUMBER:	AB-122

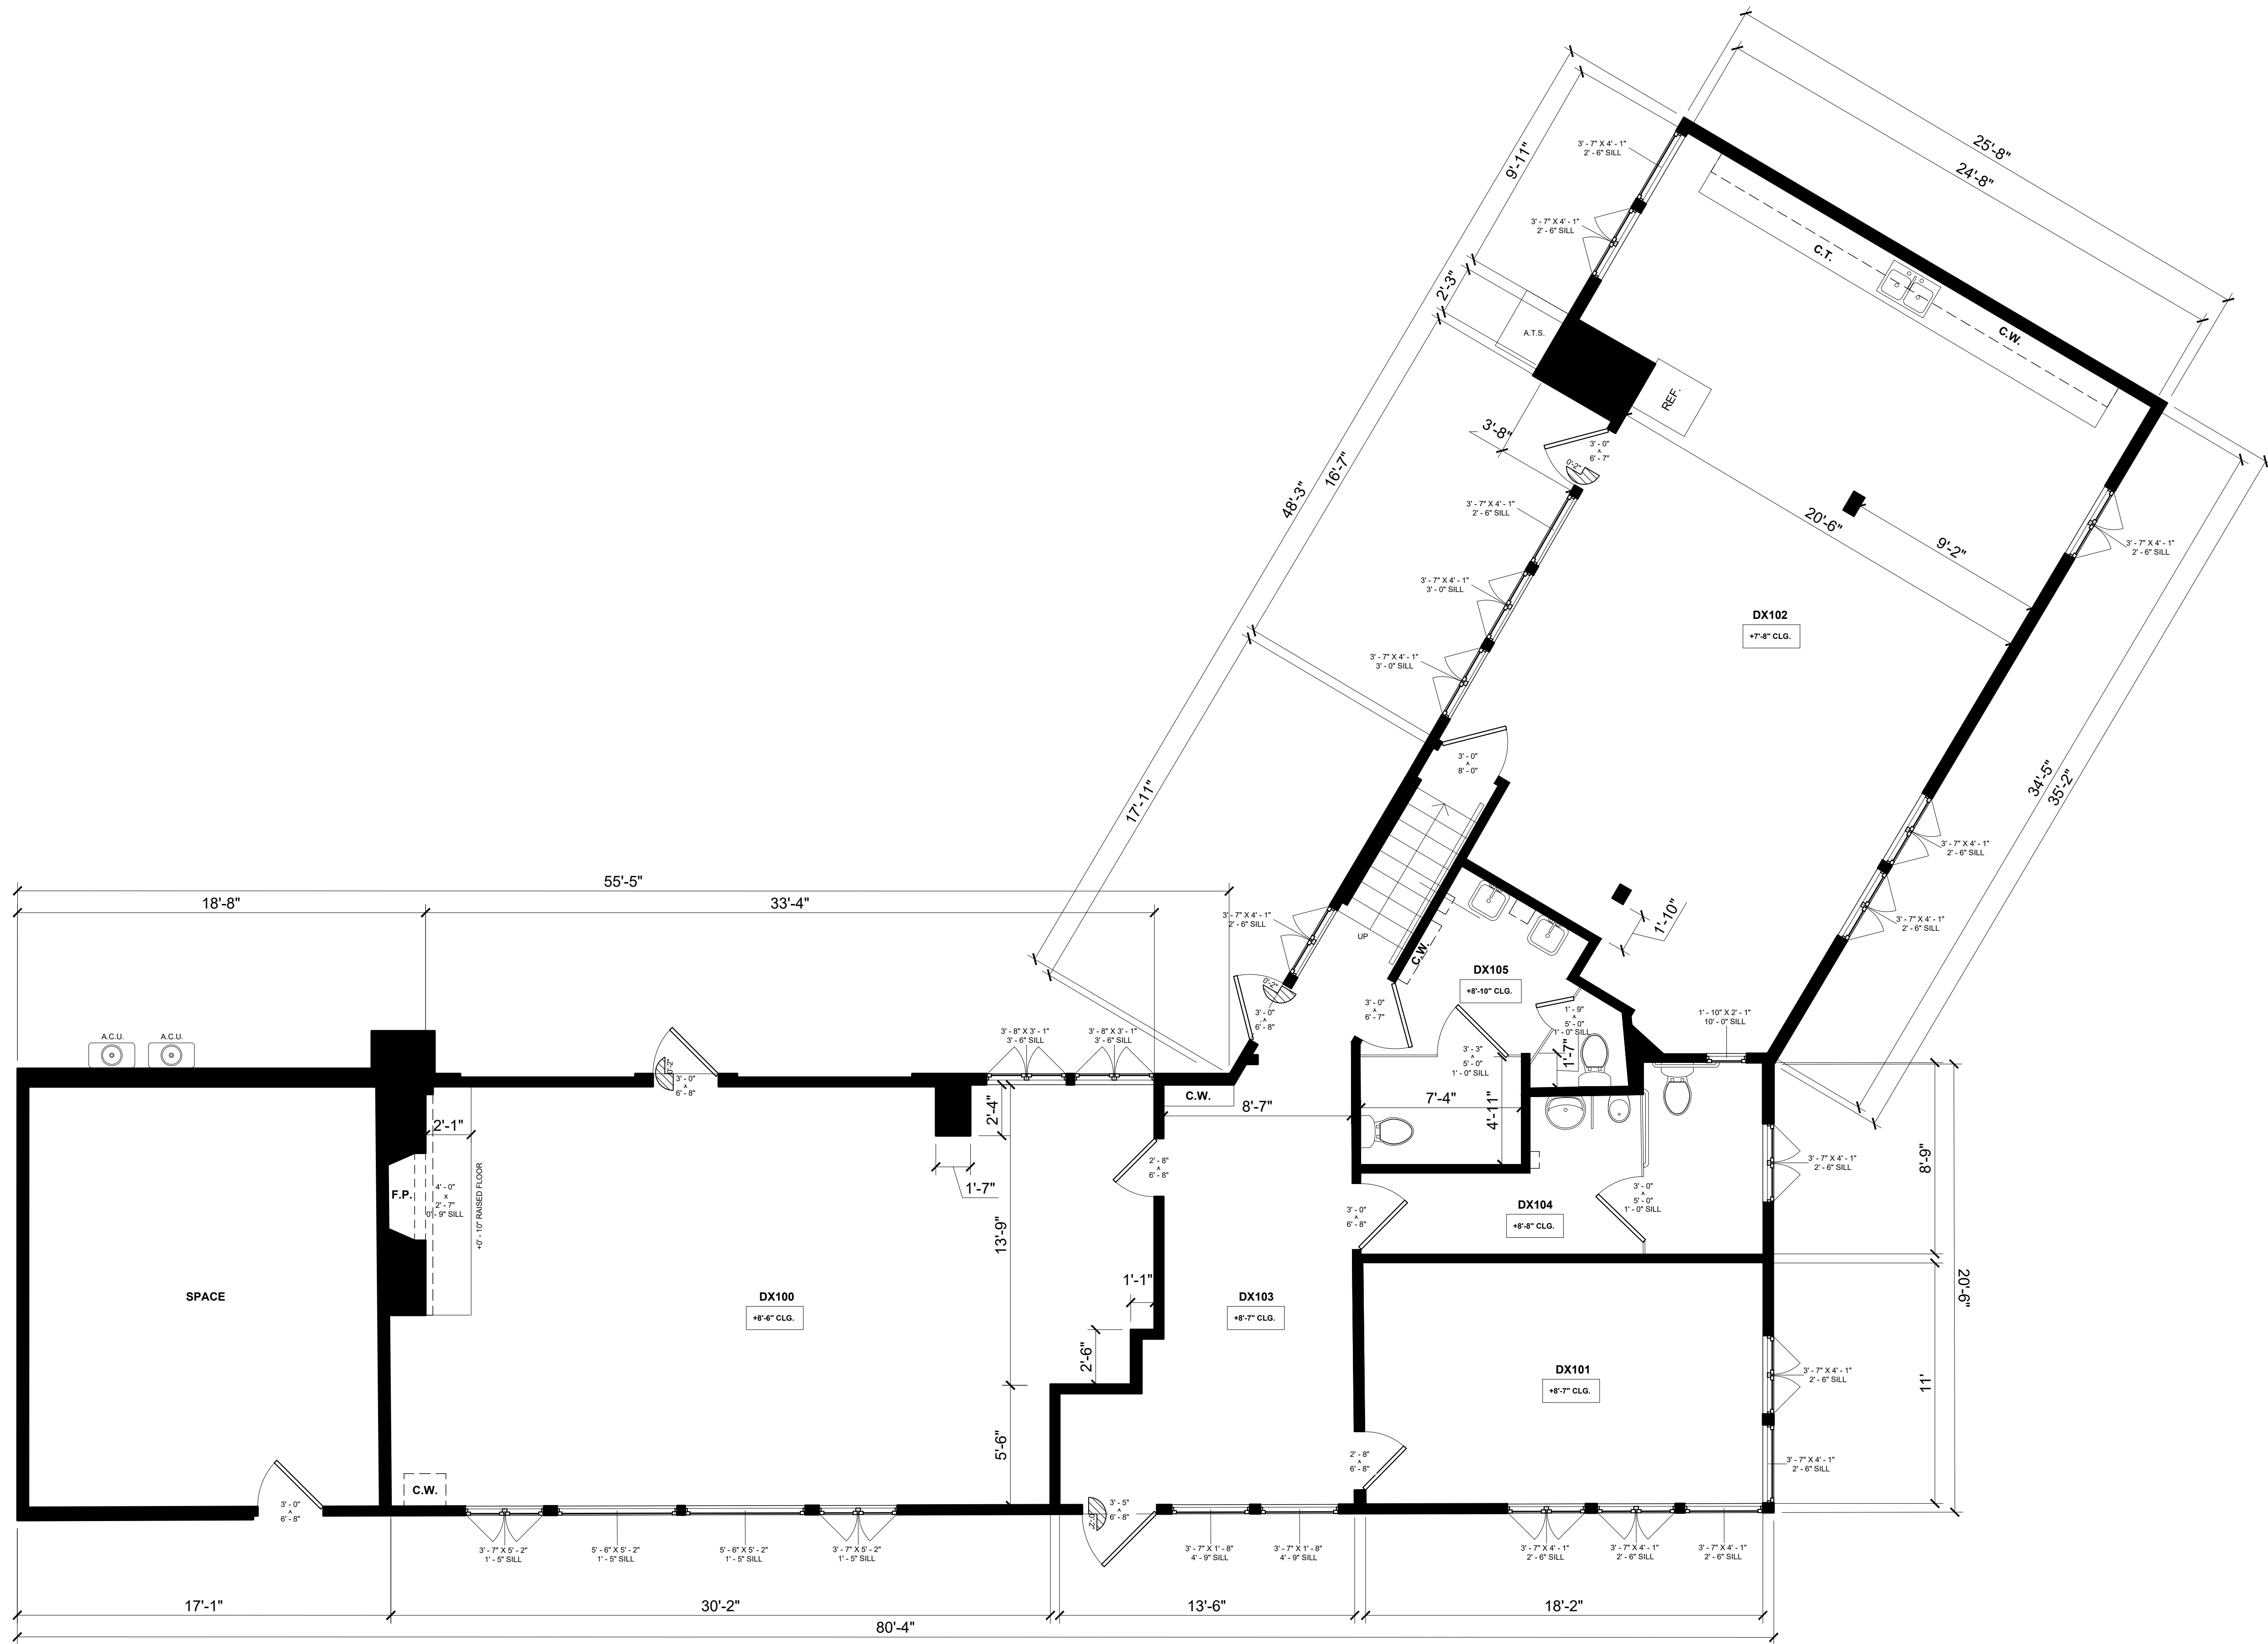

1 DIDAX HEADQUARTERS - EXISTING FLOOR PLAN
1/4" = 1'-0"

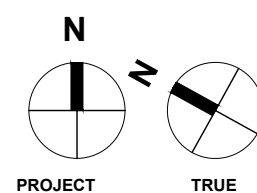

FLOOR PLAN LEGEND	
	WINDOW WIDTH X HEIGHT - SILL HEIGHT
C.W.	CASEWORK / CABINETRY / BUILT-INS
C.T.	COUNTERTOP / ISLAND
F.P.	FIREPLACE
T.O.	TOP OF
B.O.	BOTTOM OF
+X' - X' CLG.	CEILING AT HIGHEST POINT
+X' - X'	LEVEL CHANGE
X'	STEP DIRECTION & HEIGHT

**HARVARD
WESTLAKE
SCHOOL**

AS BUILT LA
21255 BURBANK BLVD, STE 120
WOODLAND HILLS, CA 91367
WWW.ASBUILT.LA.COM
INFO@ASBUILT.LA.COM
(818)-208-3616

NOTES REGARDING AREA SIZING	
* AREA MEASUREMENTS ARE BASED ON TOTAL SQUARE FOOTAGE MEASURED FROM THE INTERIOR SIDE OF THE WALLS IN ADDITION TO THE EXTERIOR SIDE OF WALLS.	
** AREA CALCULATIONS ARE COMPLIMENTARY AND WILL NOT NECESSARILY MATCH WHAT IS ON BUILDING OR REAL ESTATE RECORDS.	
*** IT'S THE RESPONSIBILITY OF THE PROJECT DESIGN PROFESSIONAL TO DETERMINE THE PROPER BREAKDOWN OF SPACES SIZES AS REQUIRED PER LOCAL REGULATIONS, BUILDING AND PLANNING CODES AND PROVIDE COMPLIANCE DOCUMENTATION AS REQUIRED.	
**** WE RECOMMEND TO ALL OUR CUSTOMERS TO GET A LAND SURVEY OF THEIR PROPERTY WHICH PROVIDES ANOTHER LEVEL OF ACCURACY, SIZING INFORMATION FOR THE PROPERTY, BOUNDARIES, AND AS IS OFTEN REQUIRED BY CITY BUILDING & PLANNING DEPARTMENTS FOR PLAN CHECK REVIEWS.	

DRAWN BY:	PG
CHECKED BY:	F.P.S.
DATE:	01/09/2026
PROJECT ID	4578
SHEET SIZE	48" X 36"
DELIVERABLES	2D CAD & PDF

SCOPE OF WORK

As Built Set

AREA CALCULATIONS

Existing Residence - Interior	2,420 SF
Existing Residence - Exterior	2,583 SF
DX100	643 SF
DX101	201 SF
DX102	734 SF
DX103	252 SF
DX104	114 SF
DX105	108 SF

PROJECT ADDRESS:


3700 Coldwater Canyon Ave.
Los Angeles, CA 91604

SHEET TITLE:

Didax Headquarters
Floor Plans


SCALE: AS NOTED

SHEET NUMBER: AB-123

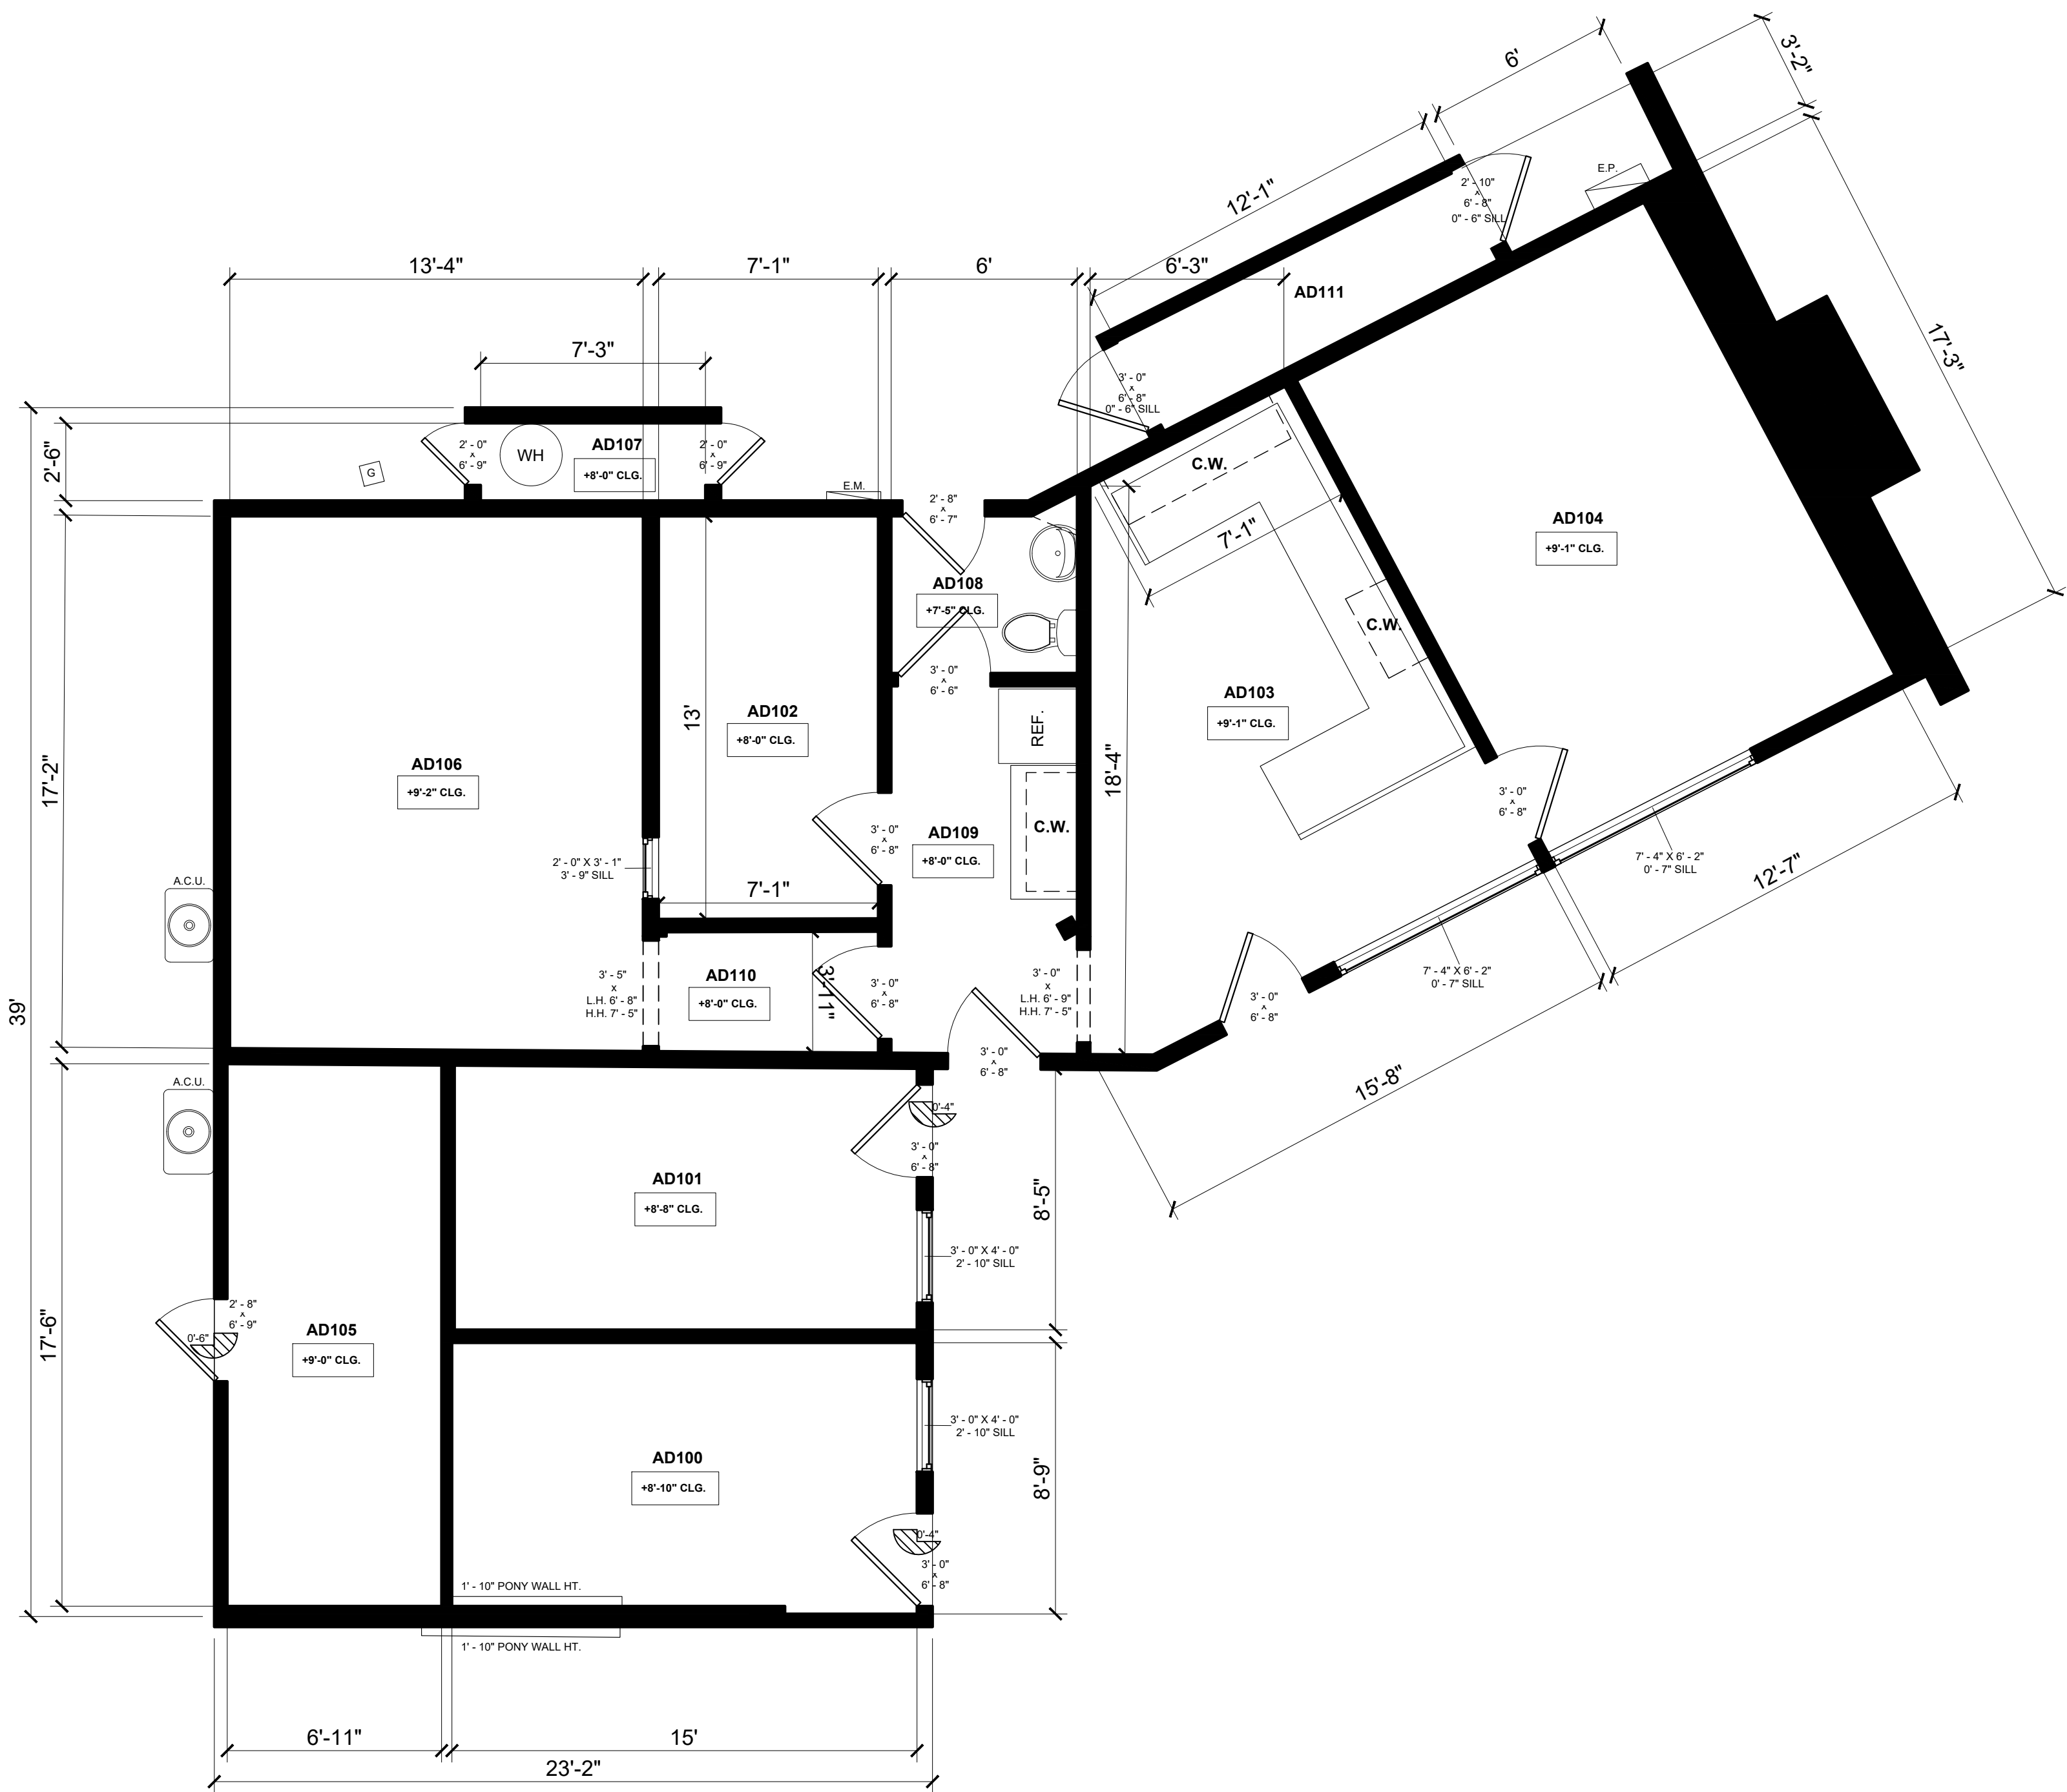

1 ADVANCEMENT HOUSE - EXISTING FLOOR PLAN
1/4" = 1'-0"


FLOOR PLAN LEGEND		HARVARD WESTLAKE SCHOOL ABLA AS BUILT LA 21255 BURBANK BLVD, STE 120 WOODLAND HILLS, CA 91367 WWW.ASBUILT.LA.COM INFO@ASBUILT.LA.COM (818)-208-3616
	WINDOW WIDTH X HEIGHT - SILL HEIGHT	
C.W.	CASEWORK / CABINETRY / BUILT-INS	
C.T.	COUNTERTOP / ISLAND	
F.P.	FIREPLACE	
T.O.	TOP OF	
B.O.	BOTTOM OF	
+X' - X' CLG.	CEILING AT HIGHEST POINT	
+X' - X'	LEVEL CHANGE	
X'	STEP DIRECTION & HEIGHT	
NOTES REGARDING AREA SIZING		DRAWN BY: PG
* AREA MEASUREMENTS ARE BASED ON TOTAL SQUARE FOOTAGE MEASURED FROM THE INTERIOR SIDE OF THE WALLS IN ADDITION TO THE EXTERIOR SIDE OF WALLS. ** AREA CALCULATIONS ARE COMPLIMENTARY AND WILL NOT NECESSARILY MATCH WHAT IS ON BUILDING OR REAL ESTATE RECORDS. *** IT'S THE RESPONSIBILITY OF THE PROJECT DESIGN PROFESSIONAL TO DETERMINE THE PROPER BREAKDOWN OF SPACES SIZES AS REQUIRED PER LOCAL REGULATIONS, BUILDING AND PLANNING CODES AND PROVIDE COMPLIANCE DOCUMENTATION AS REQUIRED. **** WE RECOMMEND TO ALL OUR CUSTOMERS TO GET A LAND SURVEY OF THEIR PROPERTY WHICH PROVIDES ANOTHER LEVEL OF ACCURACY, SIZING INFORMATION FOR THE PROPERTY, BOUNDARIES, AND AS IS OFTEN REQUIRED BY CITY BUILDING & PLANNING DEPARTMENTS FOR PLAN CHECK REVIEWS.		CHECKED BY: F.P.S.
		DATE: 01/09/2026
		PROJECT ID: 4578
		SHEET SIZE: 48" X 36"
		DELIVERABLES: 2D CAD & PDF
SCOPE OF WORK		
As Built Set		
AREA CALCULATIONS		
Existing Residence - Interior	1,370 SF	
Existing Residence - Exterior	1,507 SF	
AD100	129 SF	
AD101	126 SF	
AD102	92 SF	
AD103	217 SF	
AD104	217 SF	
AD105	121 SF	
AD106	230 SF	
AD107	18 SF	
AD108	31 SF	
AD109	71 SF	
AD110	27 SF	
AD111	39 SF	
PROJECT ADDRESS:		
3700 Coldwater Canyon Ave. Los Angeles, CA 91604		
SHEET TITLE:		
Advancement House Floor Plans		
SCALE:	AS NOTED	
SHEET NUMBER:	AB-124	

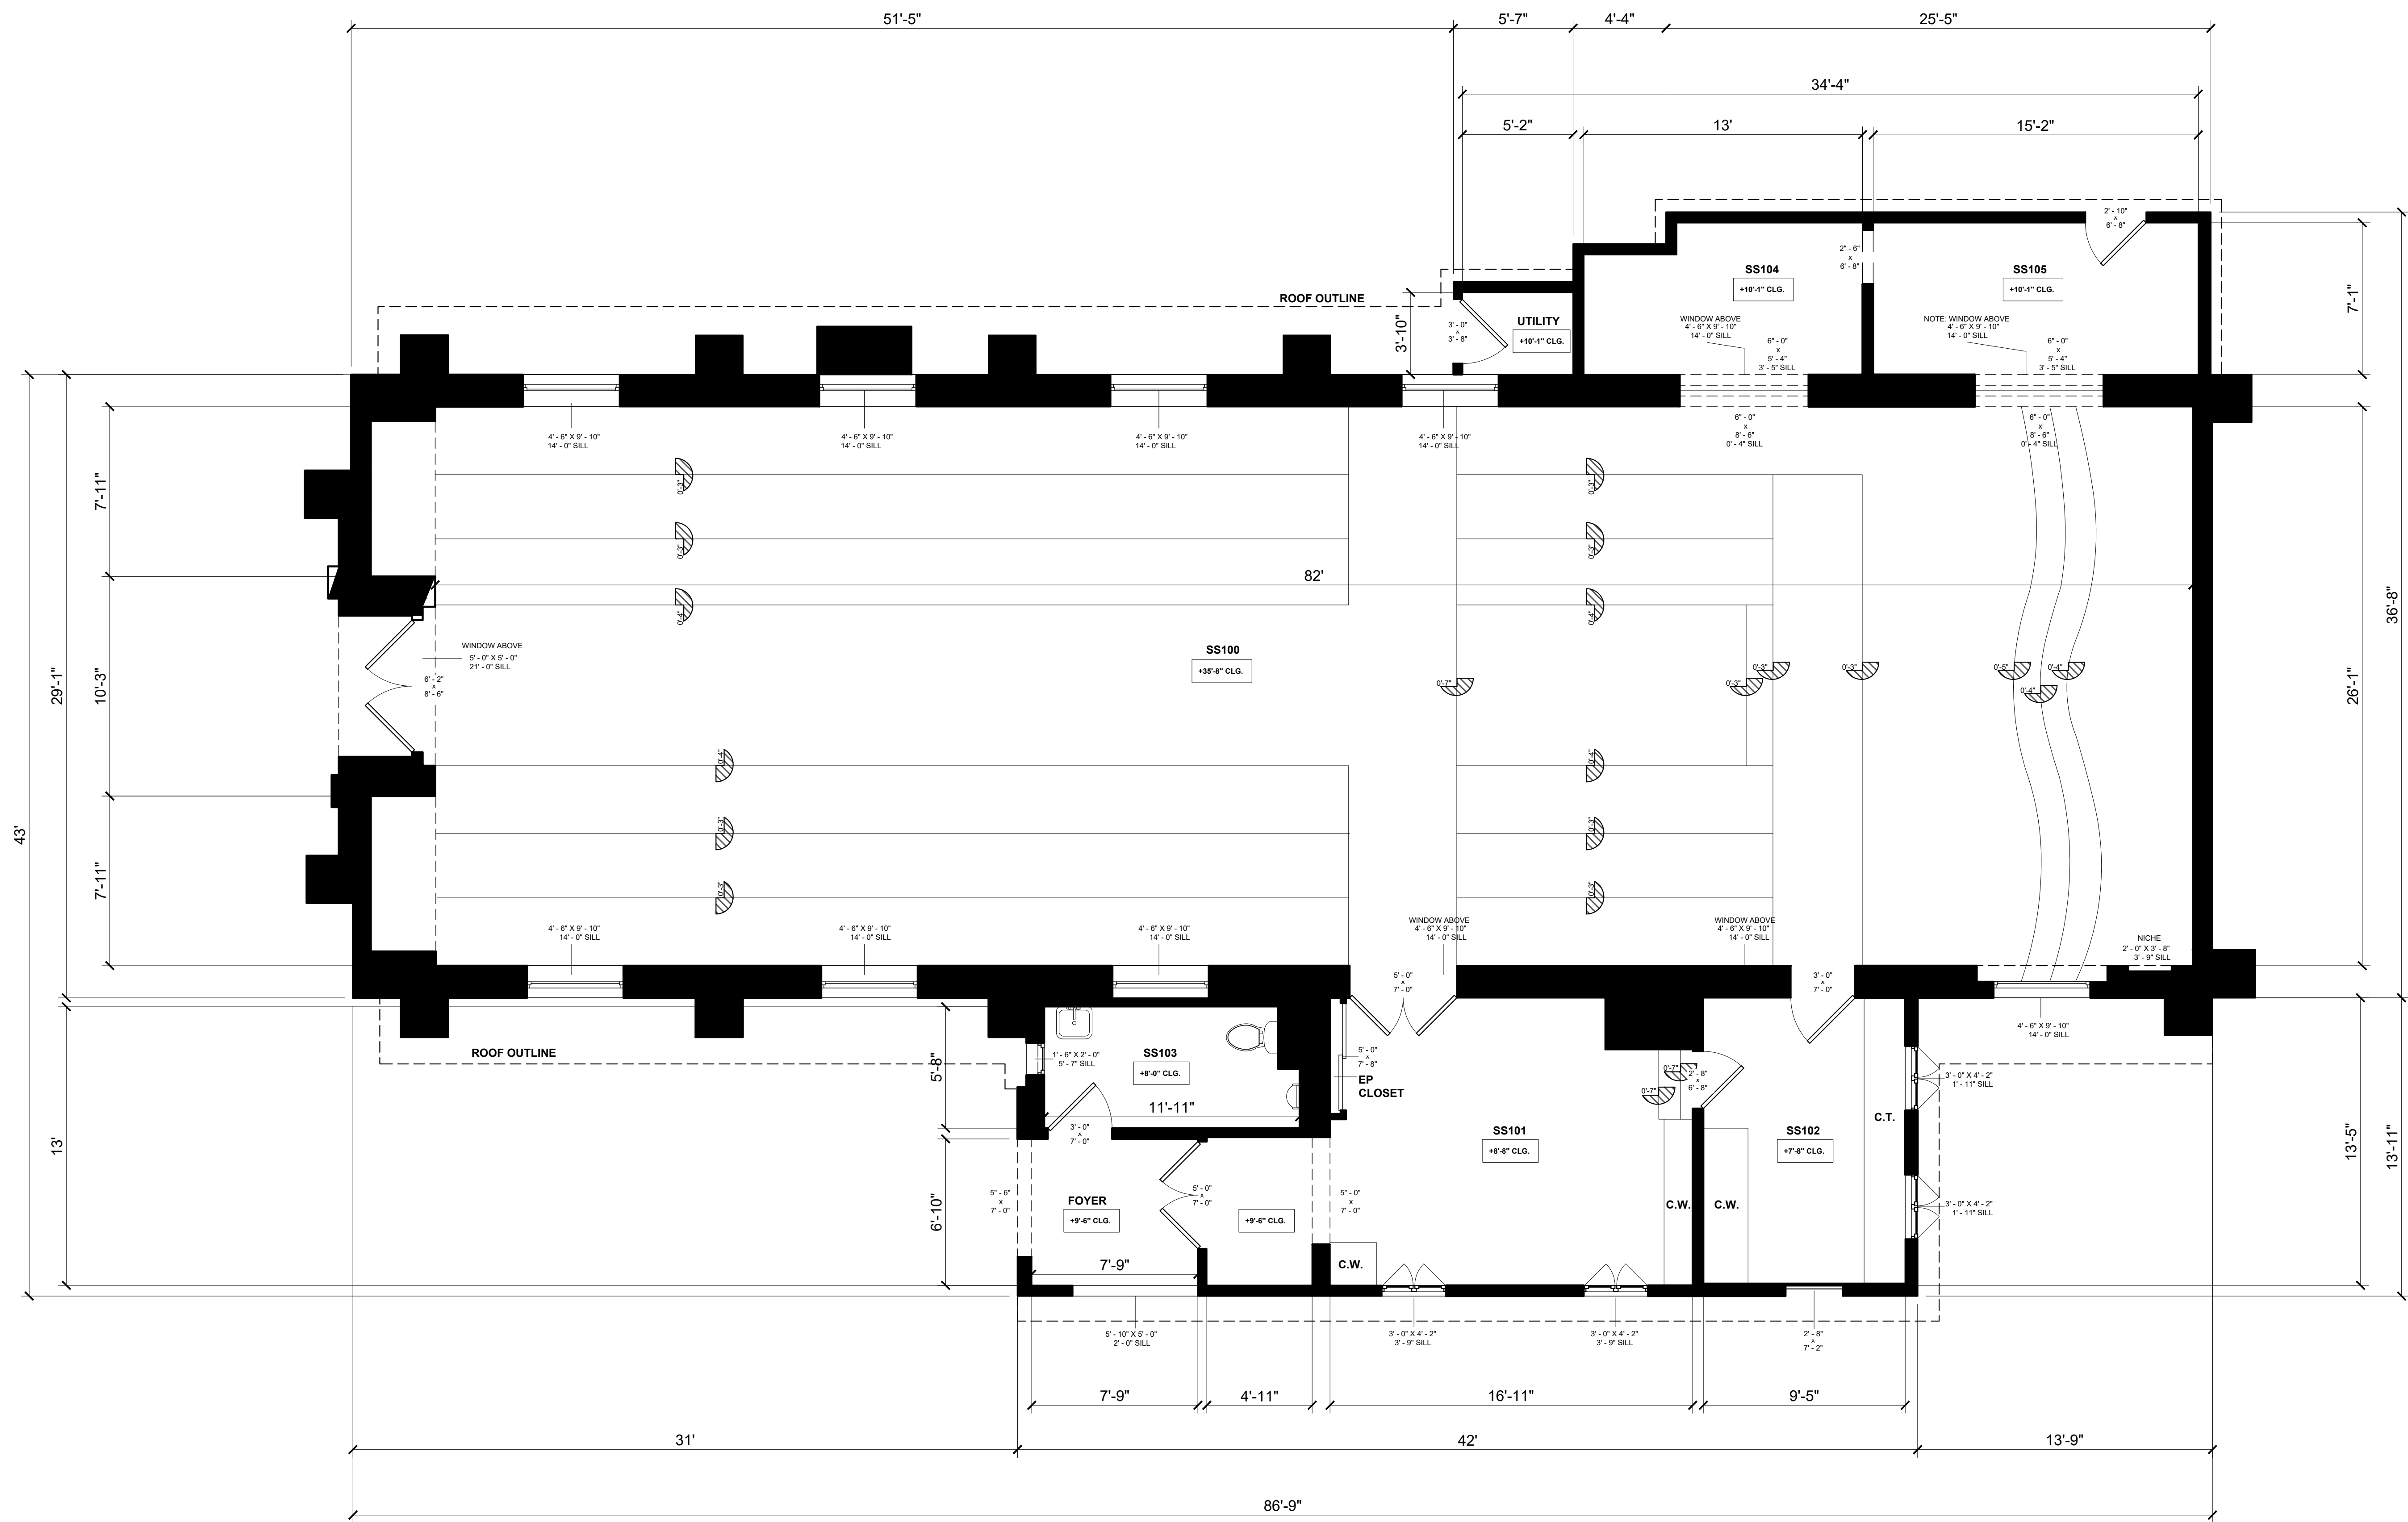

① St. Saviors Chapel - Floor Plan
1/4" = 1'-0"

FLOOR PLAN LEGEND	
	WINDOW WIDTH X HEIGHT - SILL HEIGHT
C.W.	CASEWORK / CABINETRY / BUILT-INS
C.T.	COUNTERTOP / ISLAND
F.P.	FIREPLACE
T.O.	TOP OF
B.O.	BOTTOM OF
+X" - X" CLG.	CEILING AT HIGHEST POINT
+X" - X"	LEVEL CHANGE
X"	STEP DIRECTION & HEIGHT


HARVARD WESTLAKE
S C H O O L

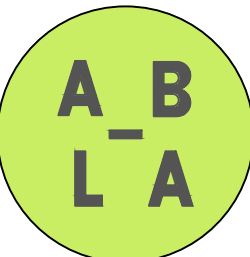

AS BUILT LA
21255 BURBANK BLVD, STE 120
WOODLAND HILLS, CA 91367
WWW.ASBUILT.LA.COM
INFO@ASBUILT.LA.COM
(818)-208-3616

NOTES REGARDING AREA SIZING * AREA MEASUREMENTS ARE BASED ON TOTAL SQUARE FOOTAGE MEASURED FROM THE INTERIOR SIDE OF THE WALLS IN ADDITION TO THE EXTERIOR SIDE OF WALLS. ** AREA CALCULATIONS ARE COMPLIMENTARY AND WILL NOT NECESSARILY MATCH WHAT IS ON BUILDING OR REAL ESTATE RECORDS. *** IT'S THE RESPONSIBILITY OF THE PROJECT DESIGN PROFESSIONAL TO DETERMINE THE PROPER BREAKDOWN OF SPACES SIZES AS REQUIRED PER LOCAL REGULATIONS, BUILDING AND PLANNING CODES AND PROVIDE COMPLIANCE DOCUMENTATION AS REQUIRED. **** WE RECOMMEND TO ALL OUR CUSTOMERS TO GET A LAND SURVEY OF THEIR PROPERTY WHICH PROVIDES ANOTHER LEVEL OF ACCURACY, SIZING INFORMATION FOR THE PROPERTY, BOUNDARIES, AND AS IS OFTEN REQUIRED BY CITY BUILDING & PLANNING DEPARTMENTS FOR PLAN CHECK REVIEWS.	DRAWN BY:	M.M.M
	CHECKED BY:	N.D.B.
	DATE:	01/09/2026
	PROJECT ID	4578
	SHEET SIZE	48" X 36"
	DELIVERABLES	2D CAD & PDF
SCOPE OF WORK		
As Built Set		

AREA CALCULATIONS	
SS100	2196 SF
SS101	257 SF
SS102	126 SF
SS103	65 SF
SS104	86 SF
SS105	107 SF
Existing Chapel - Exterior	3398 SF
PROJECT ADDRESS:	
3700 Coldwater Canyon Ave, Studio City, CA 91604	
SHEET TITLE:	
St. Saviors Chapel Floor Plan	
SCALE:	AS NOTED
SHEET NUMBER:	AB-125

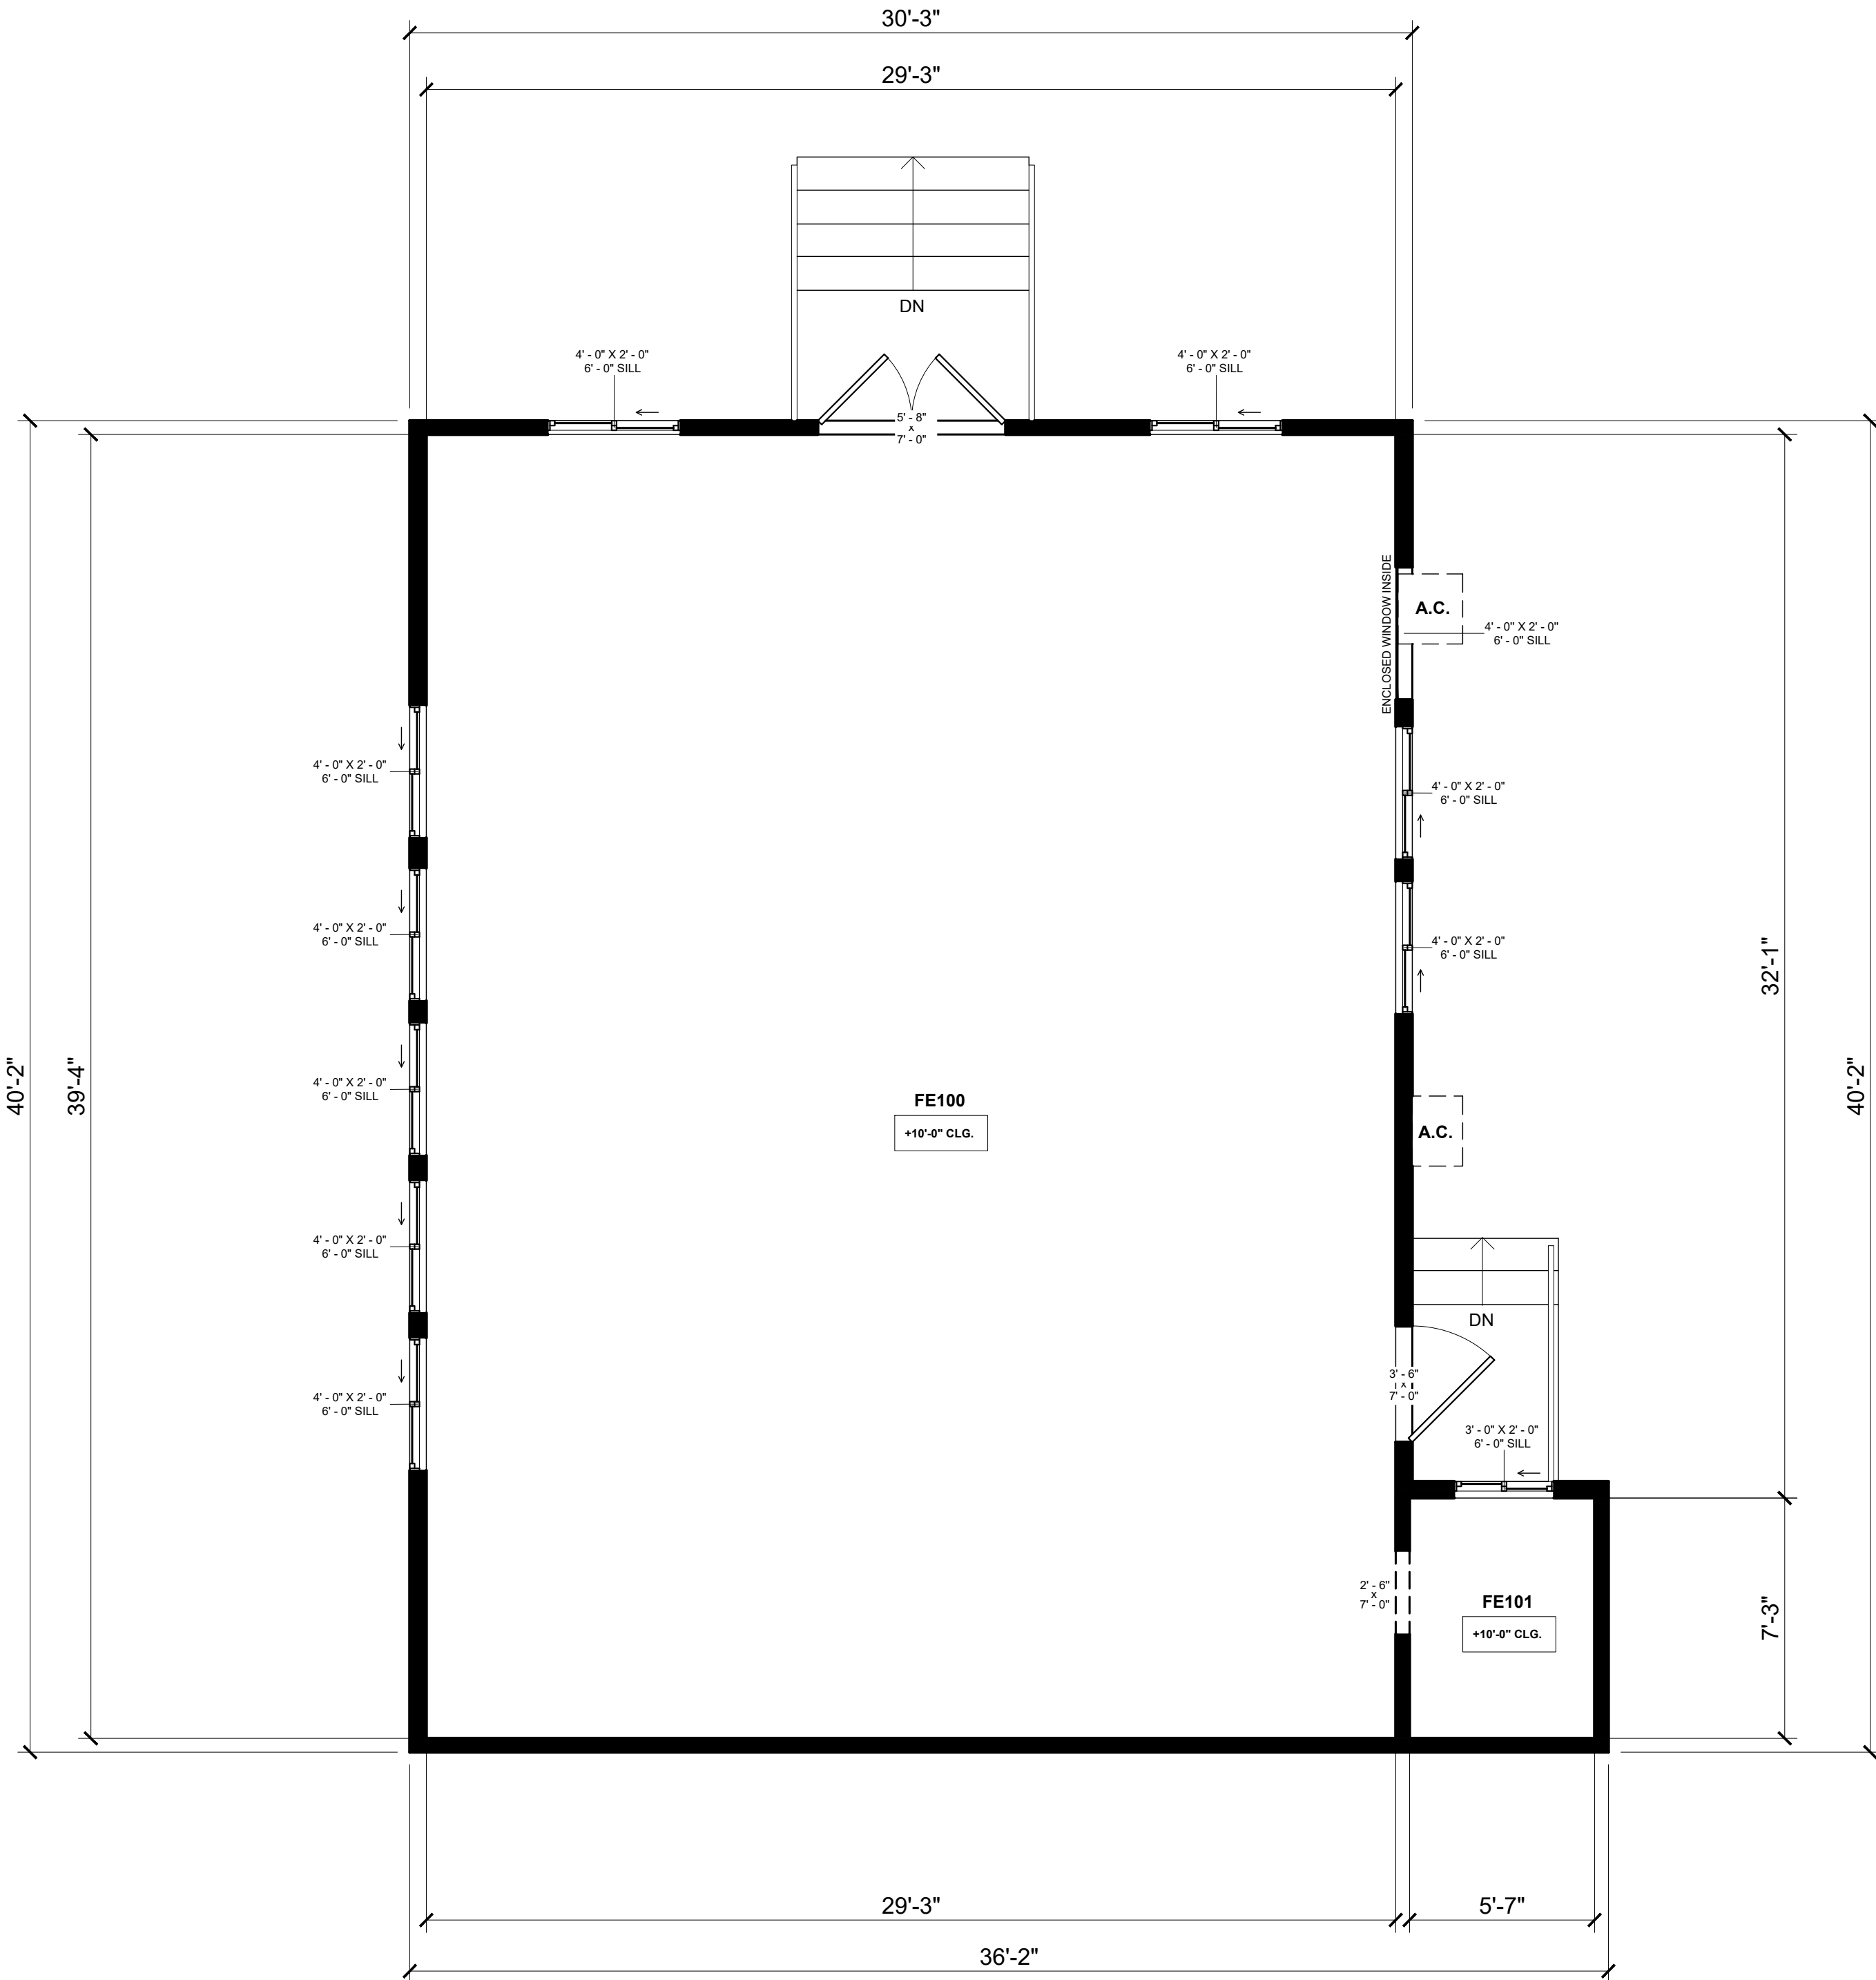

1 Fencing Room - Floor Plan
1/4" = 1'-0"

FLOOR PLAN LEGEND	
	WINDOW WIDTH X HEIGHT - SILL HEIGHT
C.W.	CASEWORK / CABINETRY / BUILT-INS
C.T.	COUNTERTOP / ISLAND
F.P.	FIREPLACE
T.O.	TOP OF
B.O.	BOTTOM OF
+X' - X' CLG.	CEILING AT HIGHEST POINT
+X' - X'	LEVEL CHANGE
X'	STEP DIRECTION & HEIGHT

HARVARD
WESTLAKE
S C H O O L

AS BUILT LA

21255 BURBANK BLVD, STE 120
WOODLAND HILLS, CA 91367
WWW.ASBUILT.LA.COM
INFO@ASBUILT.LA.COM
(818)-208-3616


NOTES REGARDING AREA SIZING	DRAWN BY:	F.P.S.
	CHECKED BY:	N.D.B.
	DATE:	01/09/2026
	PROJECT ID	4578
	SHEET SIZE	48" X 36"
	DELIVERABLES	2D CAD & PDF

SCOPE OF WORK

As Built Set

AREA CALCULATIONS	
FE100	1150.50 SF
FE101	40.48 SF
Existing Building - Exterior	1283.36 SF

PROJECT ADDRESS:	
3700 Coldwater Canyon Ave, Studio City, CA 91604	
SHEET TITLE:	
Fencing Room Floor Plans	
SCALE:	AS NOTED
SHEET NUMBER:	AB-126

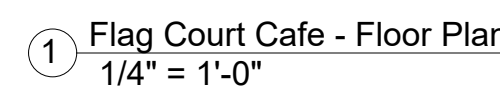

SHEET NUMBER: AB-127

AS BUILT LA
21255 BURBANK BLVD, STE 120
WOODLAND HILLS, CA 91367
WWW.ASBUILT.LA.COM
INFO@ASBUILT.LA.COM
(818)-208-3616

FLOOR PLAN LEGEND

	WINDOW WIDTH X HEIGHT - SILL HEIGHT
C.W.	CASEWORK / CABINETRY / BUILT-INS
C.T.	COUNTERTOP / ISLAND
F.P.	FIREPLACE
T.O.	TOP OF
B.O.	BOTTOM OF
+X" - X" CLG.	CEILING AT HIGHEST POINT
+X" - X"	LEVEL CHANGE
X"	STEP DIRECTION & HEIGHT

HARVARD
WESTLAKE
SCHOOL

ABLA

AS BUILT LA
21255 BURBANK BLVD, STE 120
WOODLAND HILLS, CA 91367
WWW.ASBUILT.LA.COM
INFO@ASBUILT.LA.COM
(818)-208-3616

NOTES REGARDING AREA SIZING	DRAWN BY:	PG
	CHECKED BY:	F.P.S.
* AREA MEASUREMENTS ARE BASED ON TOTAL SQUARE FOOTAGE MEASURED FROM THE INTERIOR SIDE OF THE WALLS IN ADDITION TO THE EXTERIOR SIDE OF WALLS.	DATE:	01/09/2026
** AREA CALCULATIONS ARE COMPLIMENTARY AND WILL NOT NECESSARILY MATCH WHAT IS ON BUILDING OR REAL ESTATE RECORDS.	PROJECT ID	4578
*** IT'S THE RESPONSIBILITY OF THE PROJECT DESIGN PROFESSIONAL TO DETERMINE THE PROPER BREAKDOWN OF SPACES SIZES AS REQUIRED PER LOCAL REGULATIONS, BUILDING AND PLANNING CODES AND PROVIDE COMPLIANCE DOCUMENTATION AS REQUIRED.	SHEET SIZE	48" X 36"
**** WE RECOMMEND TO ALL OUR CUSTOMERS TO GET A LAND SURVEY OF THEIR PROPERTY WHICH PROVIDES ANOTHER LEVEL OF ACCURACY, SIZING INFORMATION FOR THE PROPERTY, BOUNDARIES, AND AS IS OFTEN REQUIRED BY CITY BUILDING & PLANNING DEPARTMENTS FOR PLAN CHECK REVIEWS.	DELIVERABLES	2D CAD & PDF

SCOPE OF WORK
As Built Set

AREA CALCULATIONS

Existing - Interior	9,628 SF
Existing - Exterior	10,062 SF
HM100	6,391 SF
HM101	487 SF
HM102	1,218 SF
HM103	88 SF
HM104	199 SF
HM105	211 SF
HM106	265 SF
HM107	126 SF
HM108	237 SF
HM109	1558 SF
HM110	172 SF
HM111	37 SF

PROJECT ADDRESS:


3700 Coldwater Canyon Ave.
Los Angeles, CA 91604

SHEET TITLE:

Hamilton Gym
Floor Plans

SCALE: AS NOTED

SHEET NUMBER: AB-128

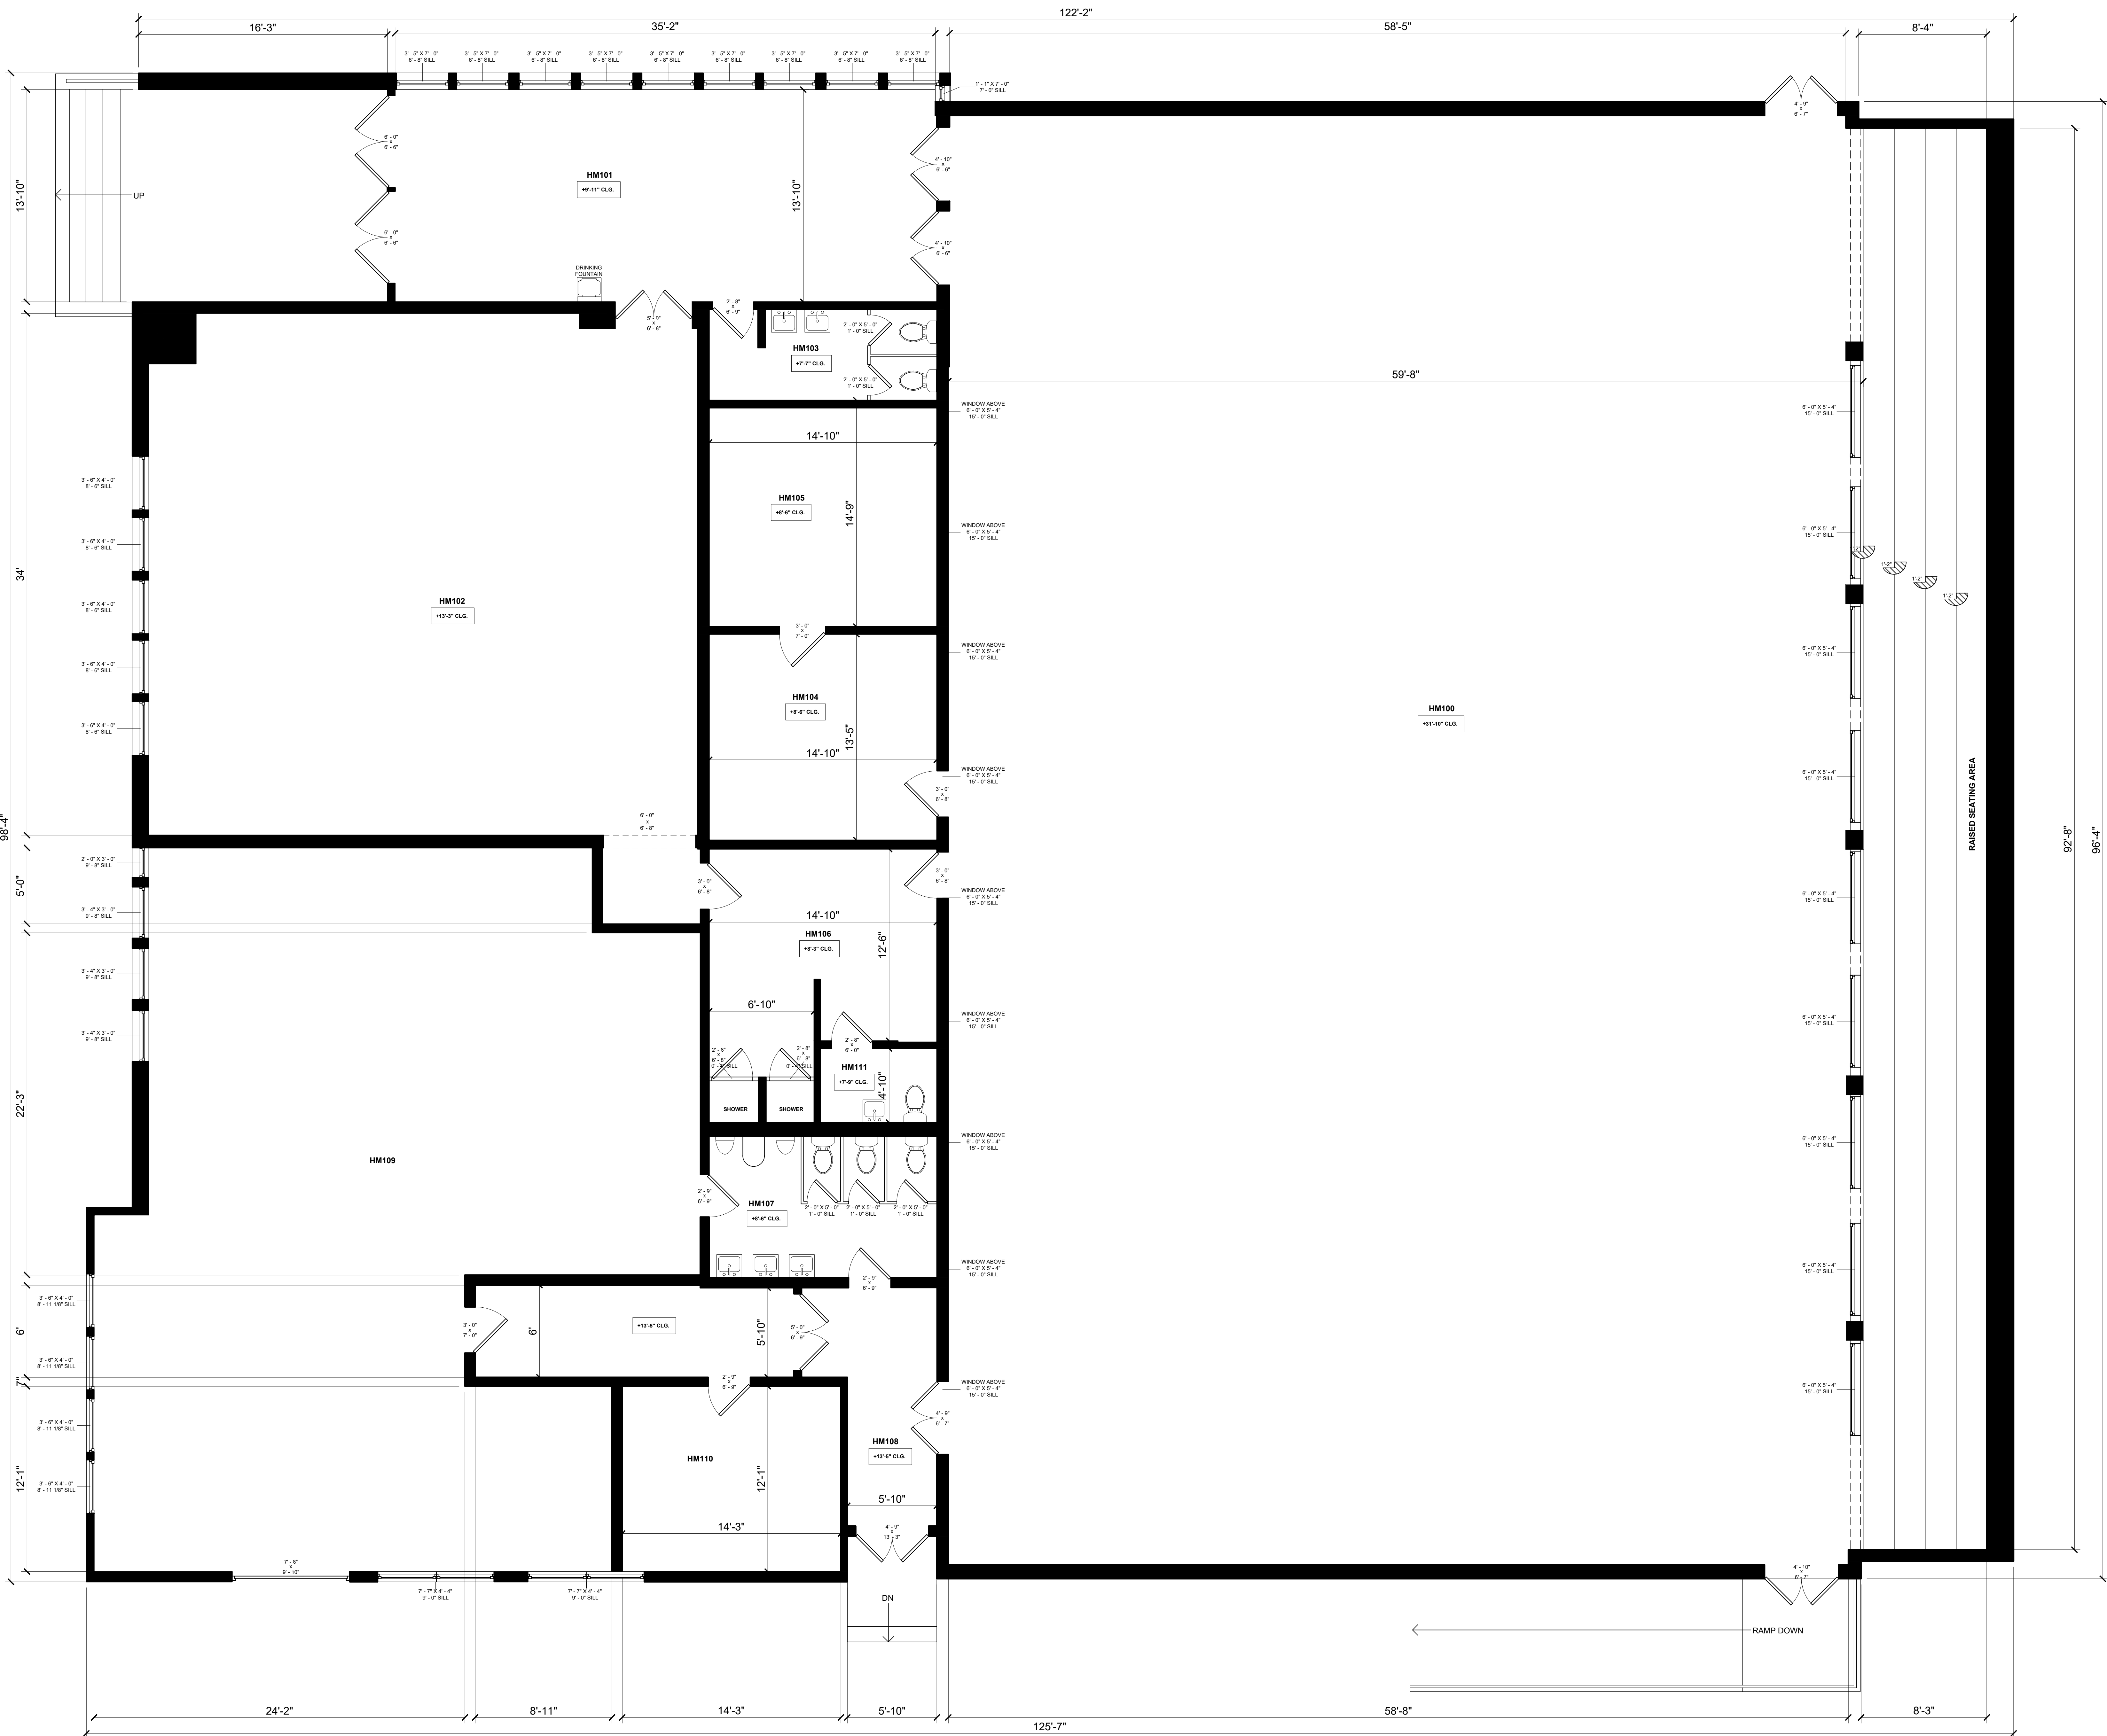

1 HAMILTON GYM - EXISTING FLOOR PLAN
1/4" = 1'-0"