


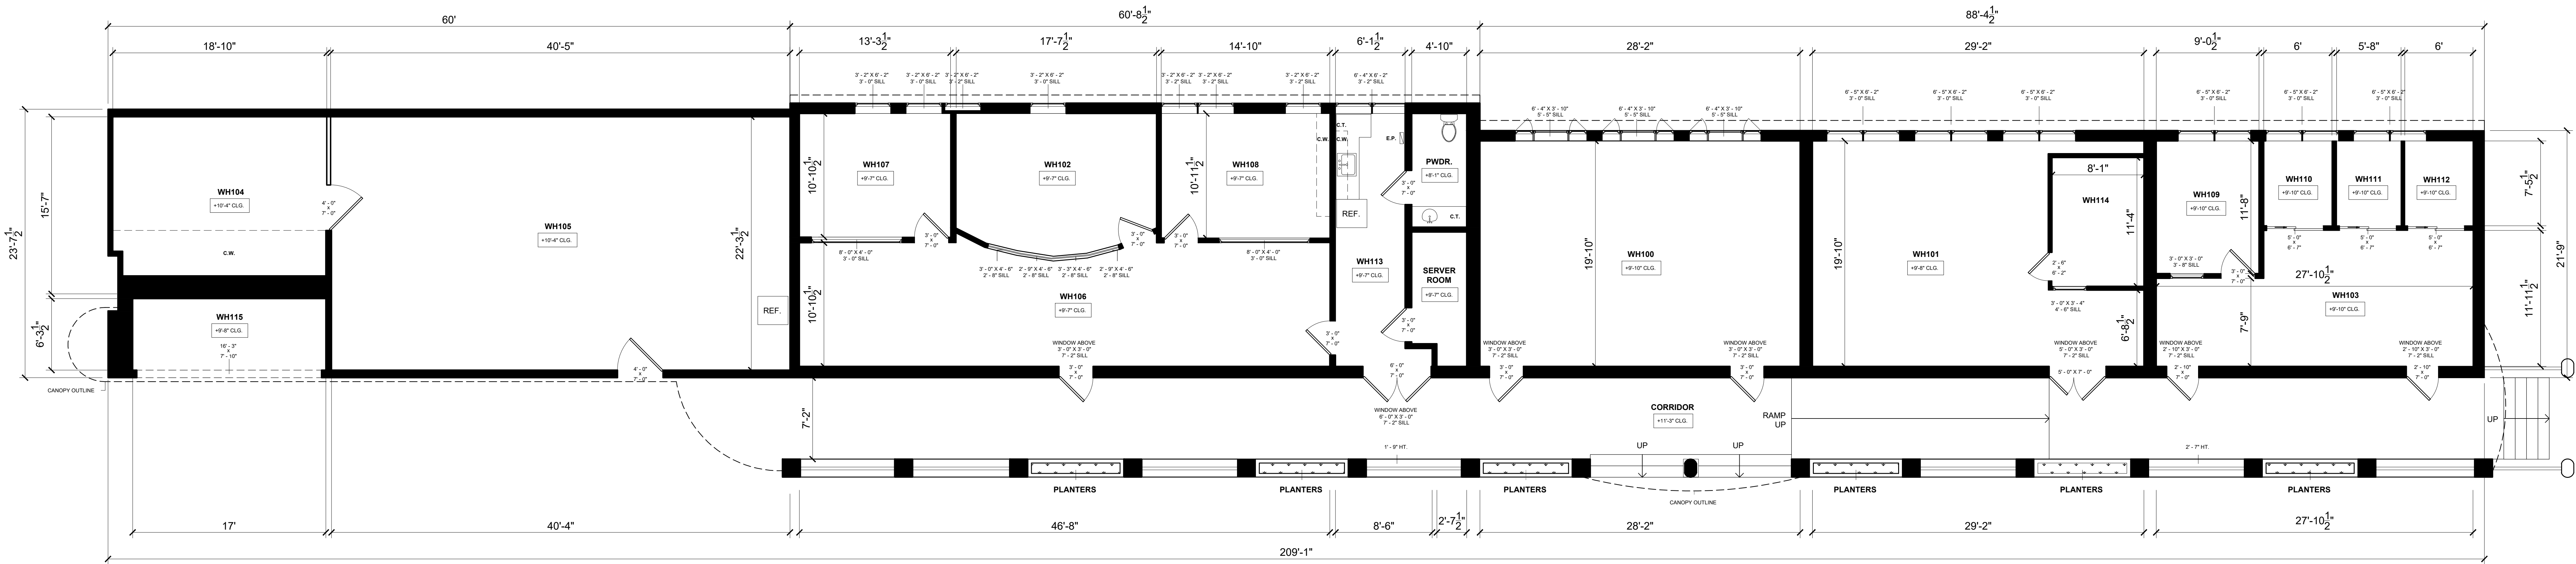

1 WEILER HALL - EXISTING FLOOR PLAN
3/16" = 1'-0"

FLOOR PLAN LEGEND	
	WINDOW WIDTH X HEIGHT - SILL HEIGHT
C.W.	CASEWORK / CABINETRY / BUILT-INS
C.T.	COUNTERTOP / ISLAND
F.P.	FIREPLACE
T.O.	TOP OF
B.O.	BOTTOM OF
+X' - X' CLG.	CEILING AT HIGHEST POINT
+X' - X'	LEVEL CHANGE
X'	STEP DIRECTION & HEIGHT

NOTES REGARDING AREA SIZING

* AREA MEASUREMENTS ARE BASED ON TOTAL SQUARE FOOTAGE MEASURED FROM THE INTERIOR SIDE OF THE WALLS IN ADDITION TO THE EXTERIOR SIDE OF WALLS.

** AREA CALCULATIONS ARE COMPLIMENTARY AND WILL NOT NECESSARILY MATCH WHAT IS ON BUILDING OR REAL ESTATE RECORDS.

*** IT'S THE RESPONSIBILITY OF THE PROJECT DESIGN PROFESSIONAL TO DETERMINE THE PROPER BREAKDOWN OF SPACES SIZES AS REQUIRED PER LOCAL REGULATIONS.

**** WE RECOMMEND TO ALL OUR CUSTOMERS TO GET A LAND SURVEY OF THEIR PROPERTY WHICH PROVIDES ANOTHER LEVEL OF ACCURACY, SIZING INFORMATION FOR THE PROPERTY. BOUNDARIES, AND AS IS OFTEN REQUIRED BY CITY BUILDING & PLANNING DEPARTMENTS FOR PLAN CHECK REVIEWS.

HARVARD
WESTLAKE
SCHOOL

A
B
L
A

AS BUILT LA
21255 BURBANK BLVD, STE 120
WOODLAND HILLS, CA 91367
WWW.ASBUILTLA.COM
INFO@ASBUILTLA.COM
(818)-208-3616

DRAWN BY:	R.C.M.
CHECKED BY:	F.P.S.
DATE:	11/01/2025
PROJECT ID	4578
SHEET SIZE	48" X 36"

SCOPE OF WORK	
As Built Set	

AREA CALCULATIONS	
Existing Residence - Interior	4,390 SF
Existing Residence - Exterior	4,800 SF
WH100	560 SF
WH101	477 SF
WH102	205 SF
WH103	293 SF
WH104	290 SF
WH105	900 SF
WH106	495 SF
WH107	145 SF
WH108	162 SF
WH109	105 SF
WH110	45 SF
WH111	42 SF
WH112	45 SF
WH113	140 SF
WH114	92 SF
WH115	107 SF

PROJECT ADDRESS:	
3700 Coldwater Canyon Ave. Los Angeles, CA 91604	
SHEET TITLE:	
Weiler Hall Floor Plans	
SCALE:	AS NOTED
SHEET NUMBER:	AB-118